




WETLANDS (POND)

WETLAND

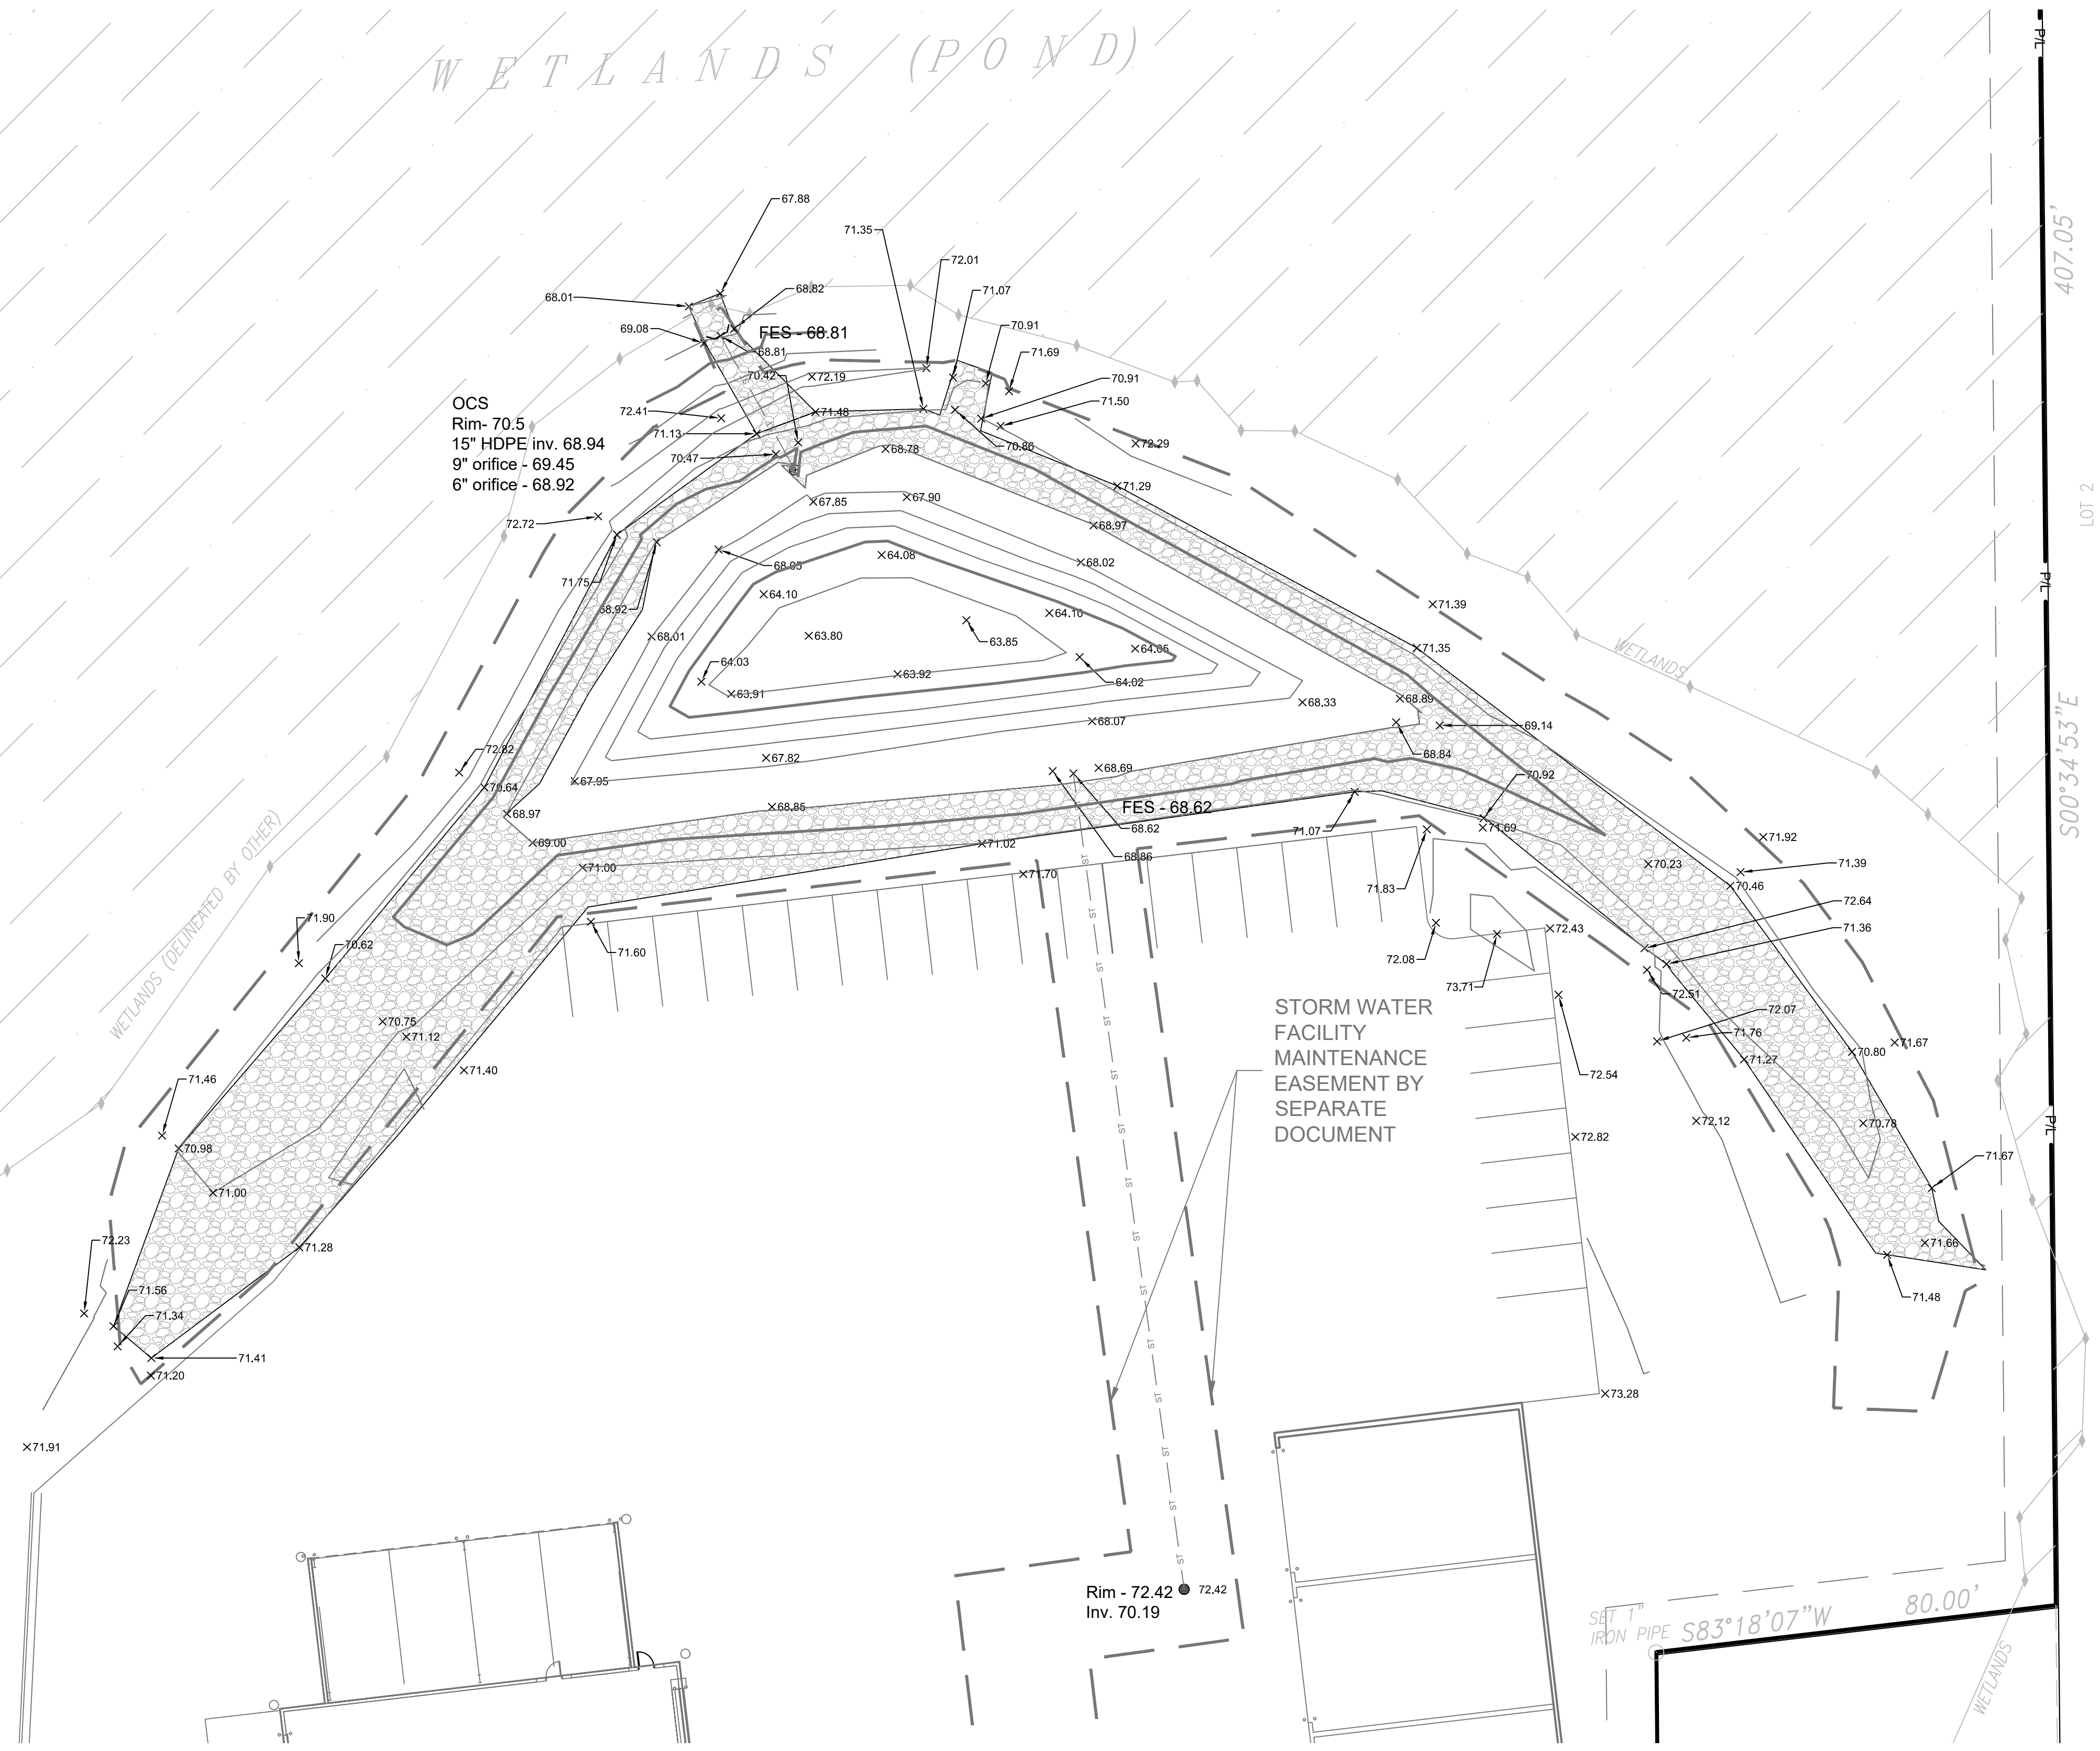

File: I:\Korb\16223 Pearl Street Civil\060 CAD\C - Civil\100 Modeling\Storm Sewer\040 FIGURES\SWM asbuilt.dwg 7/30/2018 4:45 PM



CALL DIGGERS HOTLINE  
 1-800-242-8511  
 TOLL FREE  
 MS STATUTE 182.07(187A)  
 REQUIRES MIN. 3 WORK DAYS  
 NOTICE BEFORE YOU EXCAVATE  
 MILW. AREA 259-1181

THE UNDERGROUND UTILITY INFORMATION SHOWN ON THIS MAP IS BASED ON FIELD MARKINGS AND INFORMATION FURNISHED BY UTILITY COMPANIES AND THE LOCAL MUNICIPALITY. WHILE THIS INFORMATION IS BELIEVED TO BE RELIABLE, ITS ACCURACY AND COMPLETENESS CANNOT BE GUARANTEED.

BEADRY SERVICES, INC.  
 1522 PEARL ST.  
 WAUKESHA, WISCONSIN

**WET DETENTION BASIN AS-BUILT**

NO. REVISION DATE BY

DRAWING NO.	SWM asbuilt.dwg
DRAWN BY:	---
DATE:	9/28/16
PROJECT NO:	---
CHECKED BY:	---
APPROVED BY:	---
SHEET NO.:	---

**C 200**