

WAUKESHA COUNTY AIRPORT

WAUKESHA, WISCONSIN

A.I.P. NO. 3-55-0090-22

CONTRACT 1

AIRPORT IMPROVEMENTS

AIRPORT TYPE: BASIC TRANSPORT

DESCRIPTION: RUNWAY 18/36 RECONSTRUCTION

CONSTRUCT PERIMETER ACCESS ROAD

EXPAND TERMINAL PARKING LOT

S.E. HANGAR EARTHWORK AND DRAINAGE

S.E. HANGAR PAVING AND UTILITIES

~~STABILIZE RECYCLED PAVEMENT WITH
SELF CEMENTING CLASS C FLY ASH~~

~~REGRADE RECYCLED PAVEMENT AND
INSTALL GEOTEXTILE FABRIC, TYPE SR~~

REMOVED CHANGE ORDER No. 1

(BASE BID)

(ALTERNATE NO. 1)

(ALTERNATE NO. 2)

~~(ALTERNATE NO. 3)~~
NOT AWARDED

~~(ALTERNATE NO. 4)~~

INDEX OF DRAWINGS

1	TITLE SHEET
2	CONSTRUCTION SITE PLAN
3-4	CONSTRUCTION OPERATIONS PLAN
5	PHASING PLAN
6	SURVEY CONTROL
7 - 9	PROJECT LAYOUTS
10-10A	QUANTITIES
11-12	EARTHWORK SUMMARY
13-16	PLAN & LOG OF SOIL BORINGS
17-18	TYPICAL SECTIONS
19	ALTERNATE NO. 4 DISCRETIONARY CONSTRUCTION SEQUENCE
20-22	DRAINAGE & EROSION CONTROL DETAILS
23-24	EROSION CONTROL PLAN
25	PAVEMENT & STORM SEWER REMOVALS
26	CLEARING & GRUBBING / TREE REMOVALS
27-31	STORM SEWER AND UNDERDRAIN PLAN & PROFILE
32	HANGAR AREA STORM SEWER PLAN
33-36	RUNWAY 18/36 PLAN & PROFILES
37-38	ACCESS ROAD PLAN & PROFILES
39-43	HANGAR TAXILANE PLAN & PROFILES
44-45	HANGAR WATER LINE PLAN & PROFILES
46-47	HANGAR SANITARY SEWER PLAN & PROFILES
48	SIGNAGE AND PAVEMENT MARKING DETAILS
49-51	RUNWAY 18/36 PAVEMENT MARKINGS
52	PARKING LOT PAVEMENT MARKINGS
53	HANGAR AREA PAVEMENT MARKINGS
--CROSS SECTIONS--	
54-77	RUNWAY 18/36
78-82	ACCESS ROADS
83	HANGAR AREA EXISTING CONTOURS
84	HANGAR AREA PROPOSED CONTOURS
85-91	TAXILANE A
92-95	TAXILANE B
96-107	TAXILANE C
108	TAXILANE E
109-112	ROADWAY W
--ELECTRICAL--	
113-115	ELECTRICAL REMOVALS
116-118	RUNWAY 18/36 PROPOSED LIGHTING PLAN
119-121	PROPOSED GUIDANCE SIGN CONFIGURATION
122	GUIDANCE SIGN LEGEND
123	PARKING LOT PROPOSED LIGHTING PLAN
124-125	UNDERGROUND CABLE & CONDUIT INSTALLATION
126	RUNWAY & TAXILANE EDGE LIGHTS
127	GUIDANCE SIGN DETAILS
128	RUNWAY END IDENTIFIER LIGHT SYSTEM (REILS)
129	RUNWAY END IDENTIFIER LIGHT SYSTEM (REILS) LAYOUT
130	GROUNDING FOR CONSTANT CURRENT CIRCUITS
1-5	CHANGE ORDER No. 5
1-4	CHANGE ORDER No. 6


RECORD DRAWING

- CHANGE ORDER #1**
a) CHANGED ALTERNATE 4 BACK TO ALTERNATE 3
- CHANGE ORDER #2**
a) PAID CONTRACTOR FOR WATER UTILITY PREPAYMENT
- CHANGE ORDER #3**
a) CHANGED RWY LIGHTS FROM STAKE MOUNTED TO BASE MOUNTED
b) COST FOR NIGHT WORK
c) PATCH PAVING FOR STORM SEWER CROSSING
d) UNDERCUT UNDER STORM SEWER
e) TEMPORARY PIPE FOR DRAINAGE
f) WATER SERVICE FOR REPAIR
- CHANGE ORDER #4**
a) HALF APPLICATION OF PAINT IN FALL
b) FULL APPLICATION OF PAINT IN SPRING
c) ELECTRICAL REPAIRS
d) ADDITIONAL NIGHT WORK & TRAFFIC CONTROL COST
e) WINTER DRAINAGE FOR TAXILANES
f) REPAIR EXISTING VALVE BOX
g) GEOTEXTILE FABRIC UNDER TAXIWAY E
- CHANGE ORDER #5**
a) INSTALL NEW WINDCONE & REMOVE OLD
b) INSTALL NEW ANEMOMETER & REMOVE OLD
c) INSTALL UNDERDRAIN NEXT TO EXISTING PARKING LOT
d) REPAIR RUTS FROM SNOW PLOWS
e) REPAIR CURB @ INLETS
f) INSTALL TEMPORARY GRAVEL ACCESS ROAD
- CHANGE ORDER #6**
a) INSTALL HANGAR ACCESS ROAD
b) INSTALL WATER MAIN
c) INSTALL SANITARY SEWER




LOCATION MAP

AIRPORT ELEVATION = 981' (M.S.L. DATUM)
LATITUDE = 43°02'27.5"N
LONGITUDE = 88°14'13.8"W

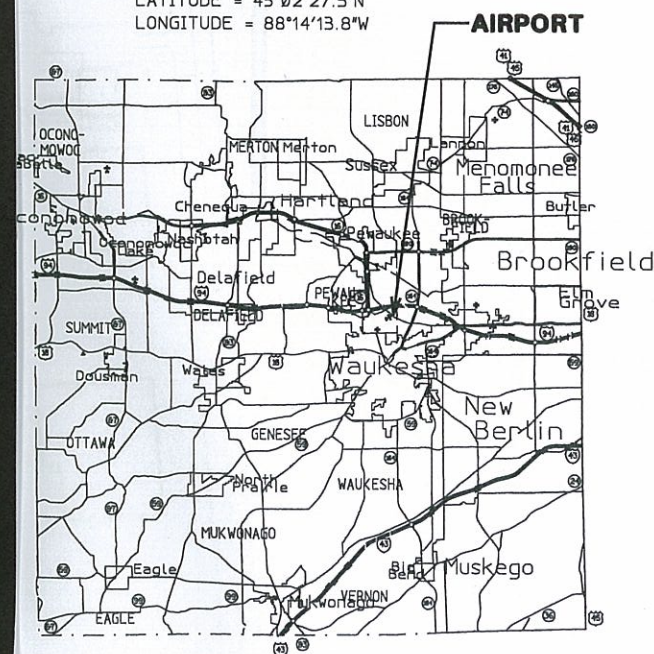

WAUKESHA COUNTY

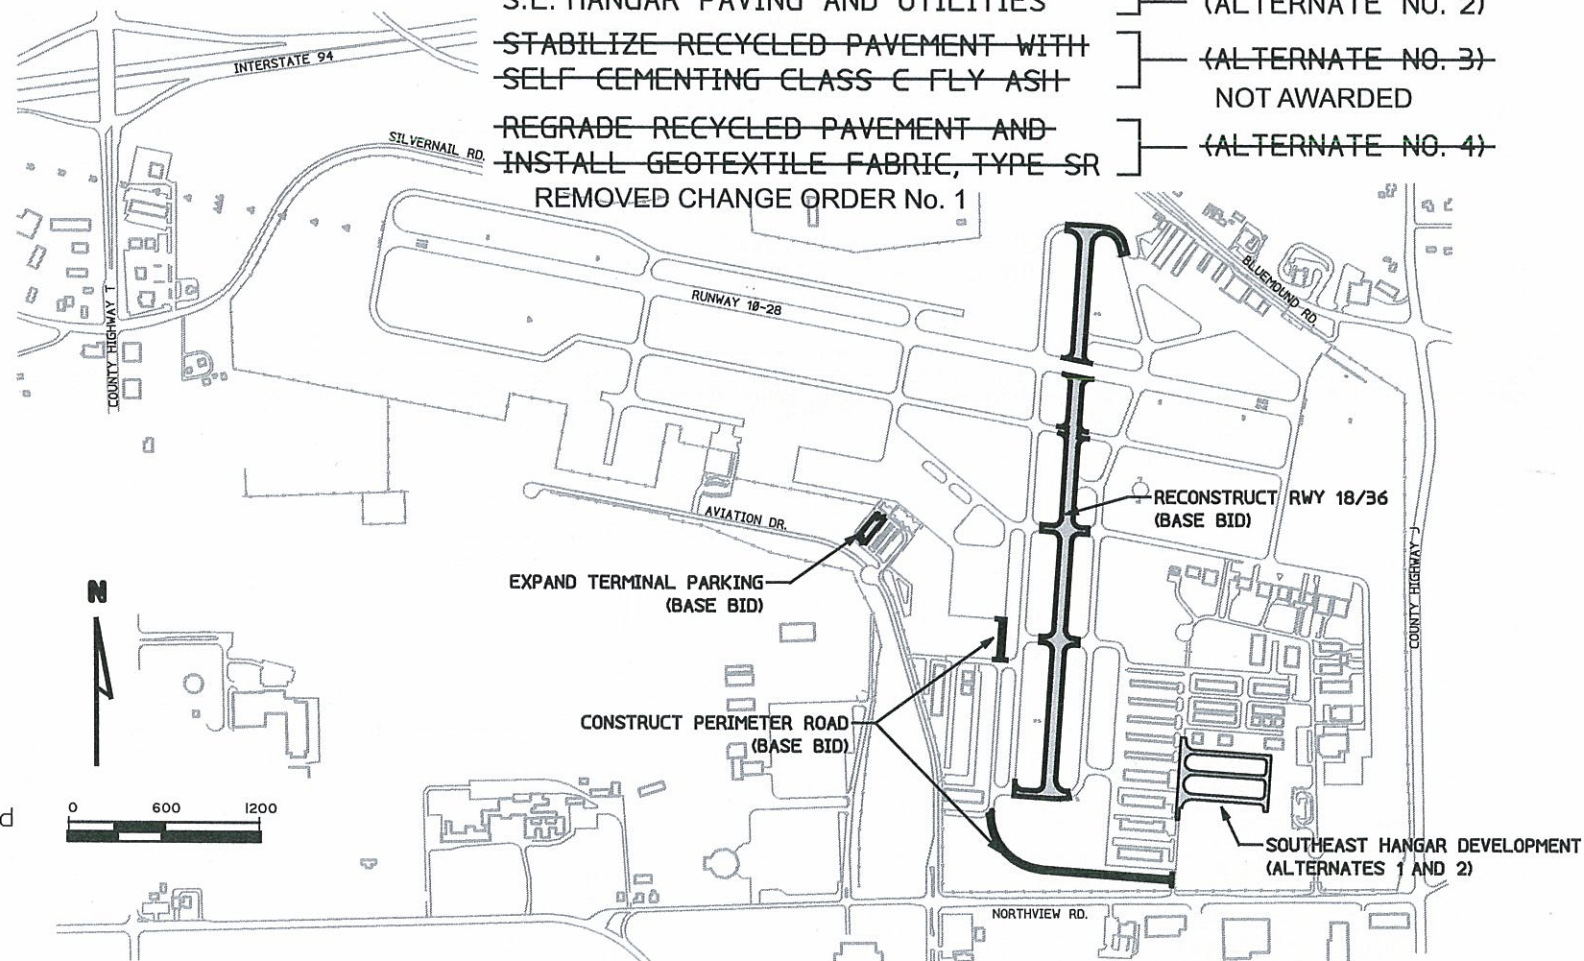

CONSTRUCTION DATA

PRIME CONTRACTOR

SUPER EXCAVATORS

MAJOR SUBCONTRACTORS AND/OR SUPPLIERS

PAYNE & DOLAN, TRI-STATE TRAFFIC

VISU-SEWER, ARROW-CRETE

OUTDOOR LIGHTING, CROWLEY

SUPER WESTERN, SPRING CITY

WORK: COMMENCED 4/27/06 COMPLETED 12/1/06
C.O. WORK COMPLETED 6/08

PROJECT ENGINEER

MARCUS J. KUHN

MEAD & HUNT, INC.

WISCONSIN
DEPARTMENT OF TRANSPORTATION
BUREAU OF AERONAUTICS

DESIGN PHASE

APPROVED BY: *Thomas A. Dole*

AIRPORT DEVELOPMENT ENGINEER

DATE: 4-13-06

Michael Arnold

AIRPORT ENGINEERING SECTION CHIEF

DATE: 4-13-06

'AS CONSTRUCTED' DRAWING

APPROVED BY: *John Tull*

AIRPORT DEVELOPMENT ENGINEER

DATE: 6-22-09

MEAD & HUNT, INC.
Madison, Wisconsin

SUBMITTED BY: *John A. Hunt*

DATE: 4-17-06

RECOMMENDED FOR APPROVAL

John A. Hunt

DATE: 4-17-06

'AS CONSTRUCTED' APPROVAL

Mrs. Kuhn

DATE: 6/24/09

**WAUKESHA CRITES FIELD
COUNTY AIRPORT**

2525 AVIATION DR.
WAUKESHA, WI 53188

DATE 1/9/2009
9005013100.dgn

DESIGNED GAS

DRAWN PCP

CHECKED AJP

MEAD & HUNT

ENGINEERS
ARCHITECTS
SCIENTISTS
PLANNERS

Mead & Hunt, Inc.
6501 Watts Road, Suite 101
Madison, Wisconsin 53719-2700
Phone: 608-273-6380
Fax: 608-273-6398

WAUKESHA COUNTY AIRPORT

TITLE SHEET

A.I.P. PROJECT NO.


3-55-0090-22

JOB NO.

23099-90-05013

SHEET NO.

1 of 130

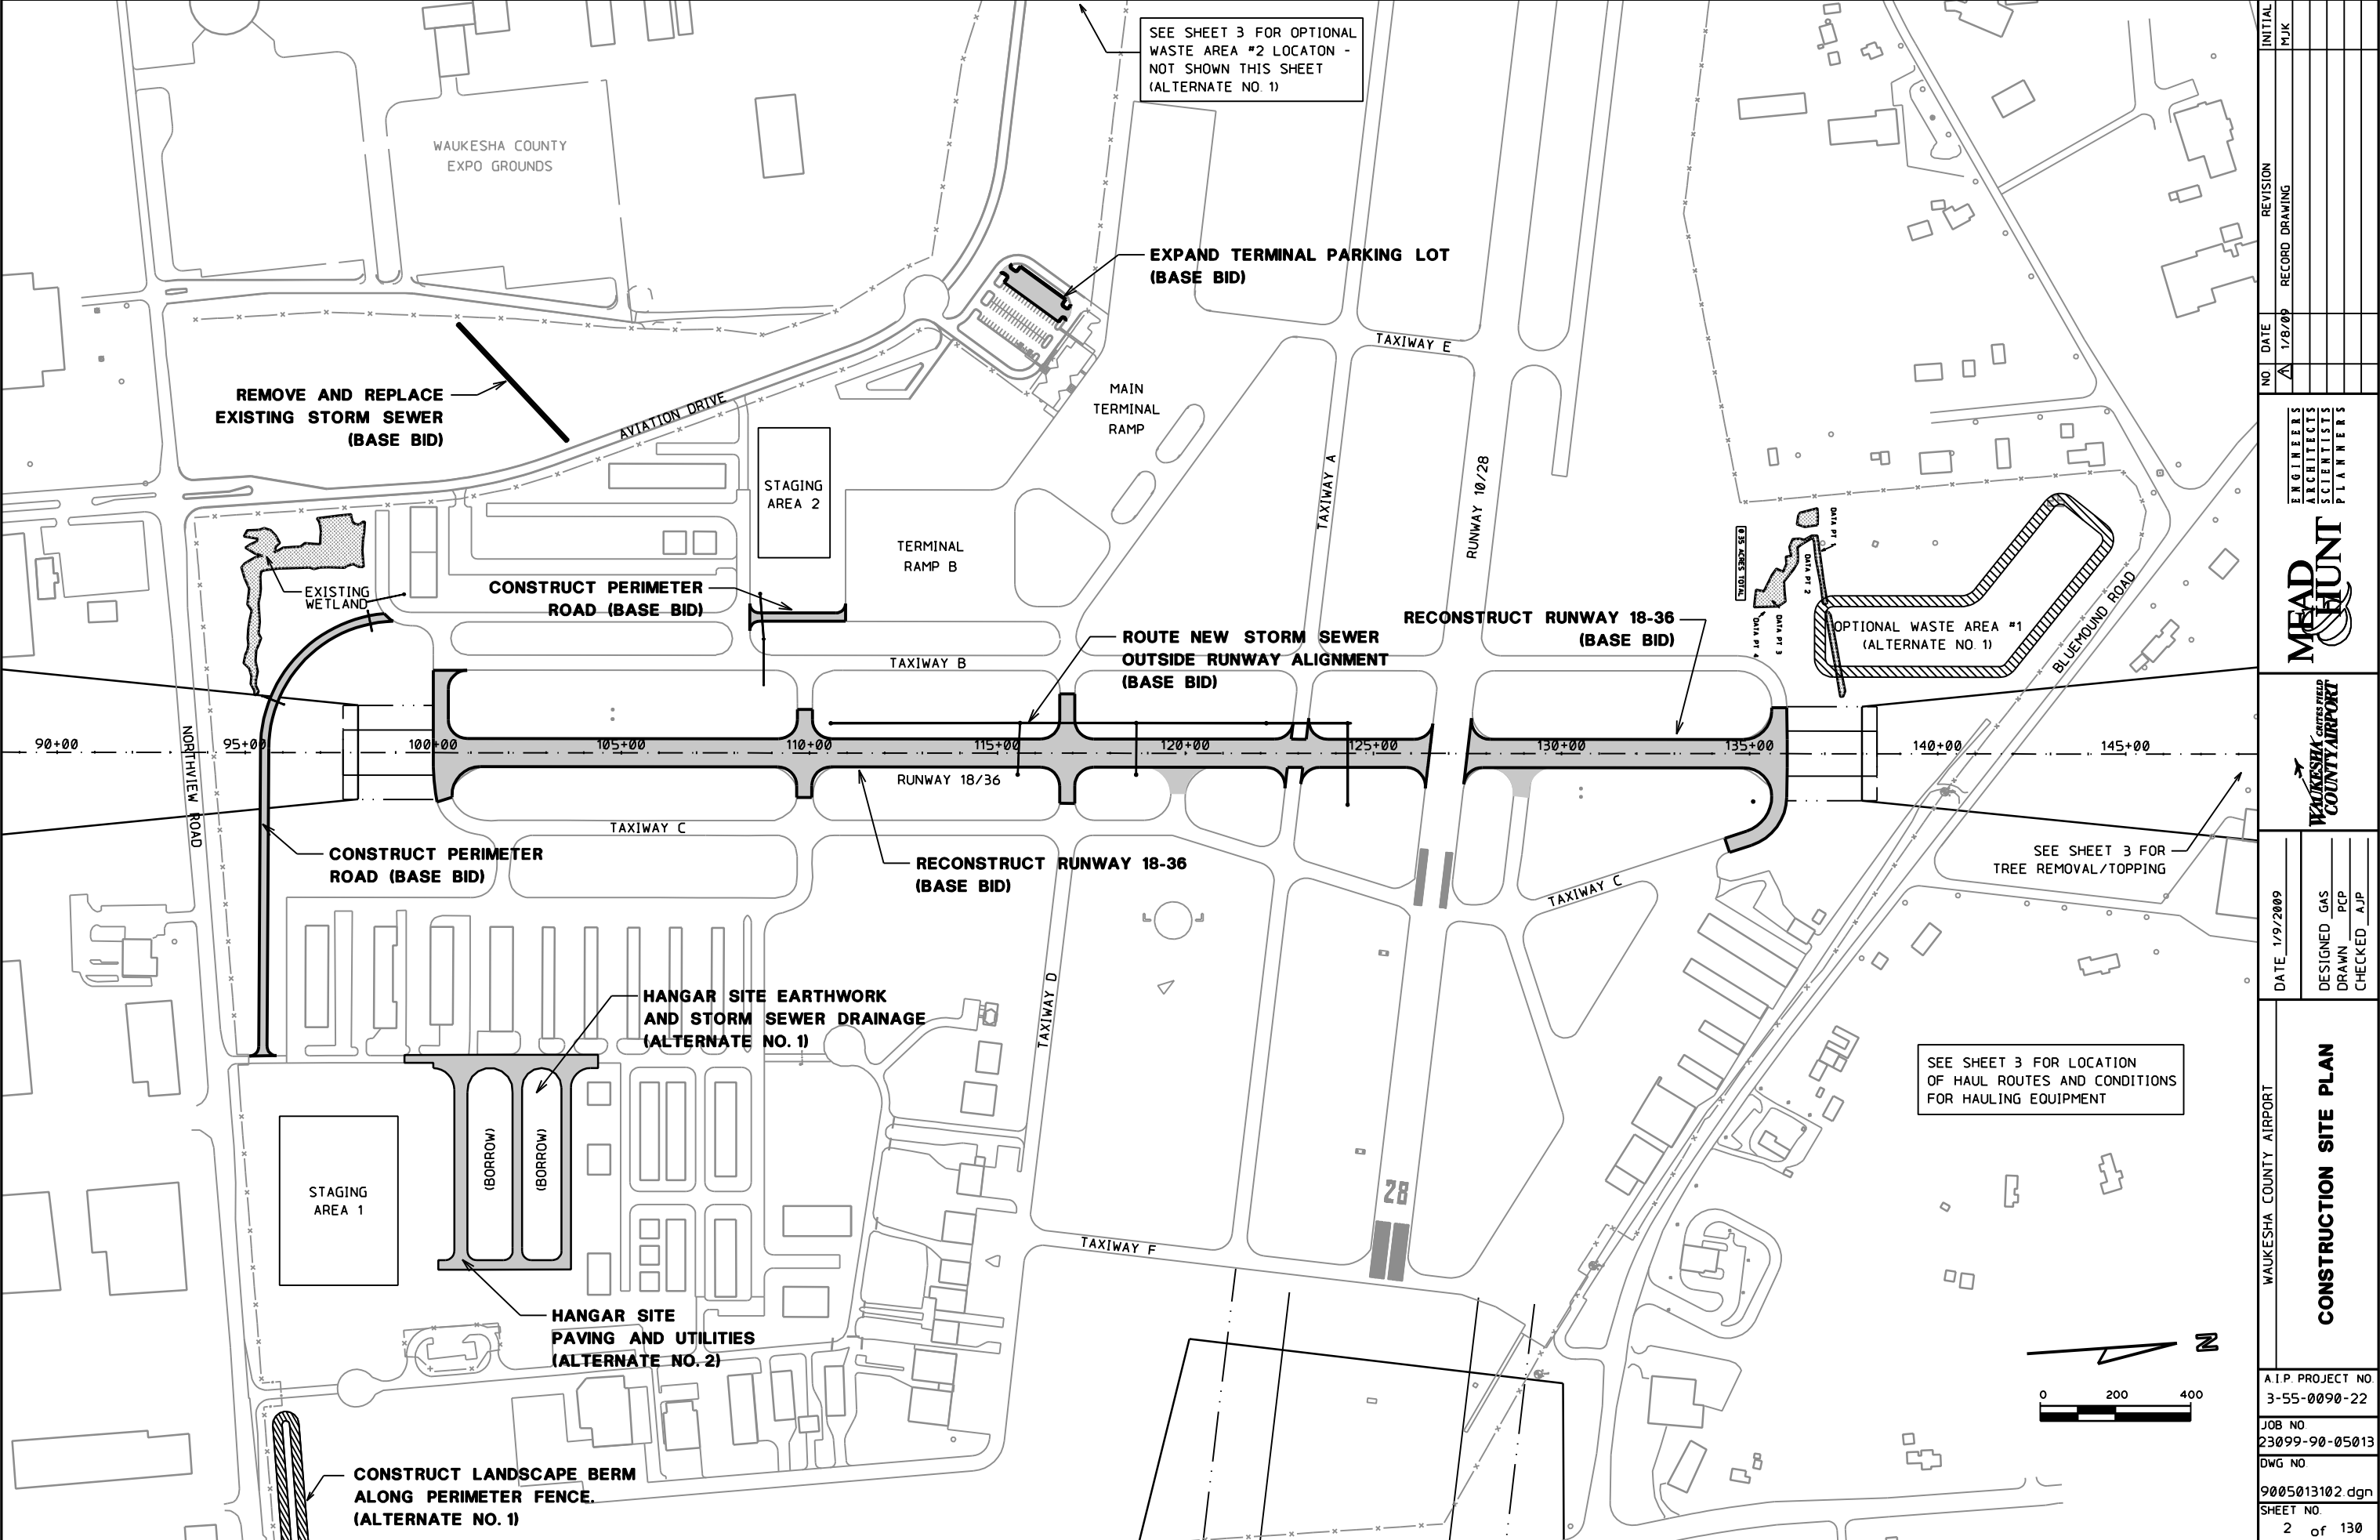

ENGINEERS ARCHITECTS SCIENTISTS PLANNERS	NO.	DATE	REVISION	INITIAL
	A	1/8/09	RECORD DRAWING	MJK
MEAD HUNT	DATE 1/9/2009			
	DESIGNED	GAS	PCP	AJP
CONSTRUCTION SITE PLAN				
A.I.P. PROJECT NO. 3-55-0090-22				
JOB NO. 23099-90-05013				
DWG NO. 9005013102.dgn				
SHEET NO. 2 of 130				

(STATE PLANE - NAD 83)

①	43 02 27.972	88 14 56.463	WASTE AREA #2
②	43 02 39.065	88 14 02.420	WASTER AREA #1
③	43 02 38.014	88 13 59.604	RUNWAY 18 END (EL = 906.02)
④	43 02 31.752	88 14 01.198	CORNER OF WORK AREA AT 10/28
⑤	43 02 31.504	88 13 59.606	CORNER OF WORK AREA AT 10/28
⑥	43 02 26.799	88 14 01.815	CORNER OF WORK AREA AT 10/28
⑦	43 02 26.552	88 14 00.223	CORNER OF WORK AREA AT 10/28
⑧	43 02 06.200	88 13 52.711	NW CORNER OF HANGAR AREA WOR
⑨	43 02 01.132	88 13 53.331	SW CORNER OF HANGAR AREA WOR
⑩	43 02 02.603	88 14 04.025	RUNWAY 36 END (EL = 910.79)
⑪	43 02 11.174	88 14 07.347	EDGE OF PERIM ROAD WORK AREA


X = LIGHTED CLOSURE CROSS (SEE NEXT SHEET)

XXX = LIGHTED CONSTRUCTION BUCKET (SEE NEXT SHEET)

OFA ——— = OBJECT FREE AREA

RSA ——— = RUNWAY SAFETY AREA

- - - - = CONSTRUCTION HAUL ROUTES

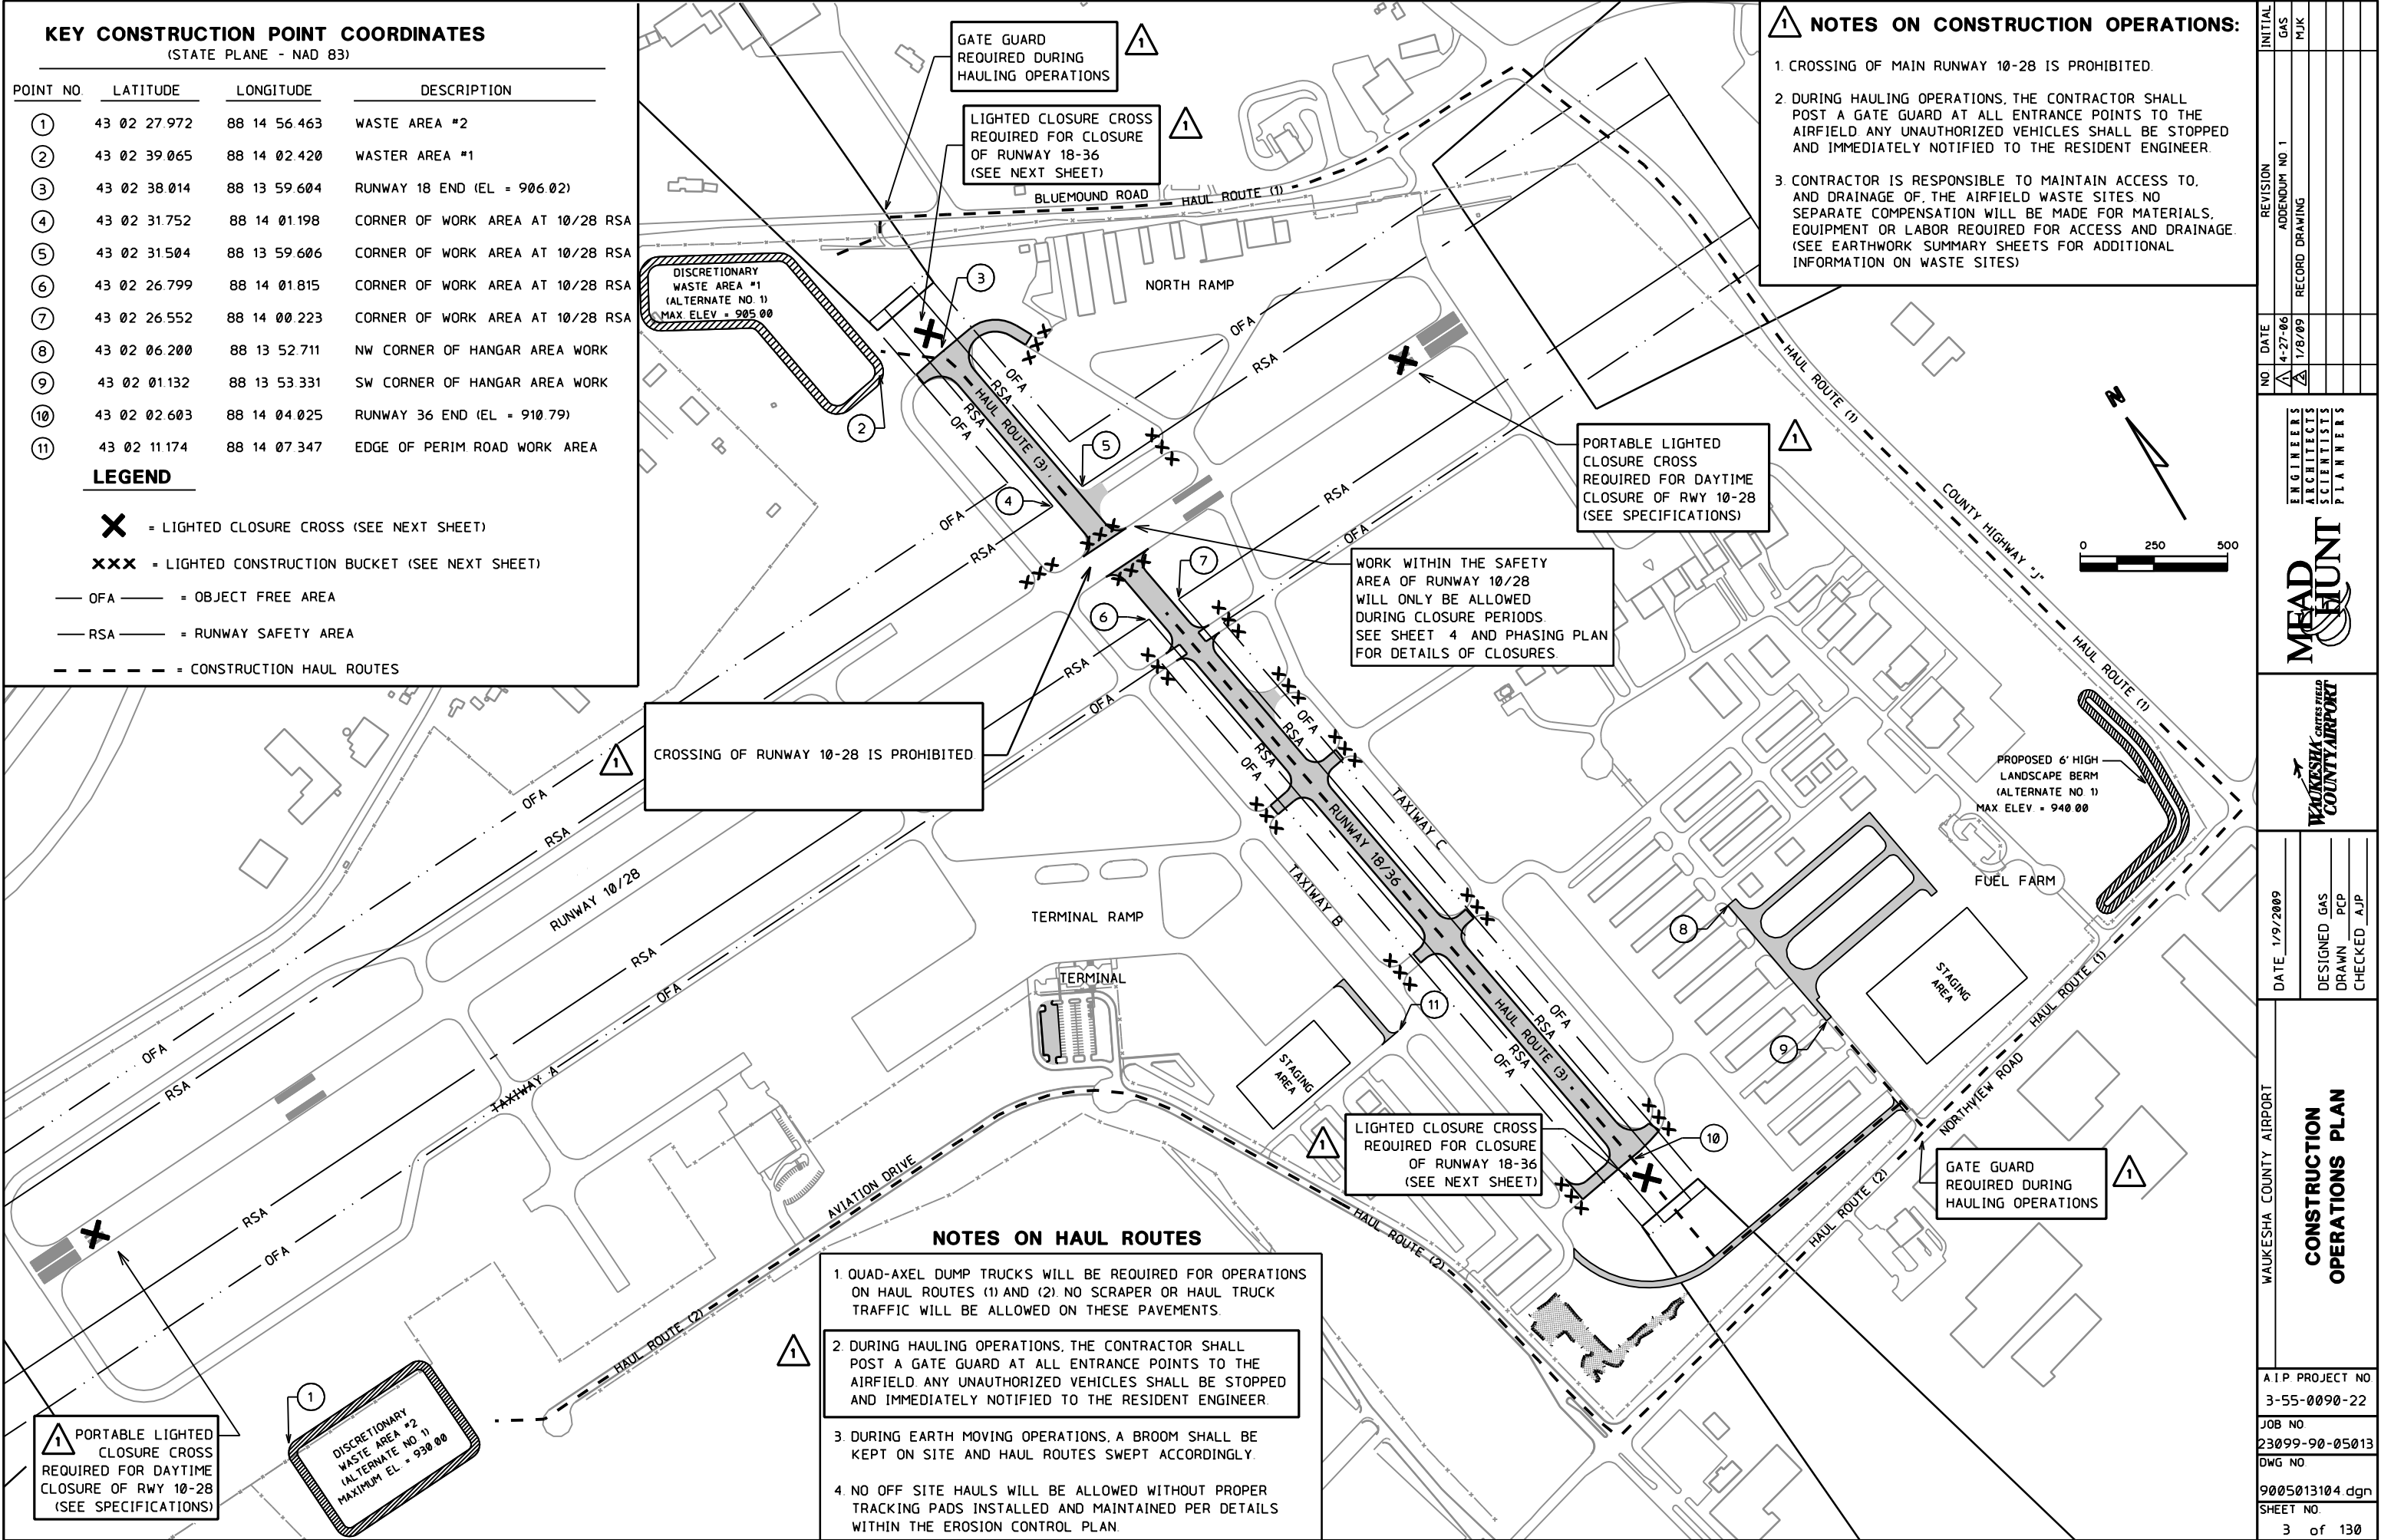

1. CROSSING OF MAIN RUNWAY 10-28 IS PROHIBITED.
2. DURING HAULING OPERATIONS, THE CONTRACTOR SHALL POST A GATE GUARD AT ALL ENTRANCE POINTS TO THE AIRFIELD ANY UNAUTHORIZED VEHICLES SHALL BE STOPPED AND IMMEDIATELY NOTIFIED TO THE RESIDENT ENGINEER.
3. CONTRACTOR IS RESPONSIBLE TO MAINTAIN ACCESS TO, AND DRAINAGE OF, THE AIRFIELD WASTE SITES NO SEPARATE COMPENSATION WILL BE MADE FOR MATERIALS, EQUIPMENT OR LABOR REQUIRED FOR ACCESS AND DRAINAGE (SEE EARTHWORK SUMMARY SHEETS FOR ADDITIONAL INFORMATION ON WASTE SITES)

NO	DATE	REVISION	INITIAL
1	4-27-06	ADDENDUM NO. 1	GAS
2	1/8/09	RECORD DRAWING	MJK

MEAD
& HUNT
ENGINEERS
ARCHITECTS
SCIENTISTS
PLANNERS



DATE 1/9/2009

DESIGNED GAS

DRAWN PCP

CHECKED AJP

CONSTRUCTION OPERATIONS PLAN


A.I.P. PROJECT NO	3-55-0090-22
JOB NO.	23099-90-05013
DWG NO	9005013104.dgn
SHEET NO.	3 of 130

X:\23099-90\06017\tech\cadd\drawings\AS-BUILTS\HANGAR AREA\23099-90-04004 Land Desktop.dwg\23099-90-04004101.dwg



Project: 23099-90-04004 Land Desktop Horizontal Alignment PI Station Report. Alignment: TAXILANE A Desc:				
PI Station	Northing	Easting	Distance	Direction
99+04.43	382181.4815	2441247.3362	795.7054	S 86-03-36 E
107+00.14	382126.8061	2442041.1609		
Project: 23099-90-04004 Land Desktop Horizontal Alignment PI Station Report. Alignment: TAXILANE B Desc:				
PI Station	Northing	Easting	Distance	Direction
99+04.41	382051.7888	2441238.4035	795.7054	S 86-03-36 E
107+00.12	381997.1134	2442032.2282		
Project: 23099-90-04004 Land Desktop Horizontal Alignment PI Station Report. Alignment: TAXILANE C Desc:				
PI Station	Northing	Easting	Distance	Direction
99+04.38	381902.1433	2441228.0965	795.7054	S 86-03-36 E
107+00.09	381847.4679	2442021.9212		
Project: 23099-90-04004 Land Desktop Horizontal Alignment PI Station Report. Alignment: PHASE 1 TXY E Desc:				
PI Station	Northing	Easting	Distance	Direction
47+00	382473.7494	2441369.7898	730.0762	S 03-56-00 W
54+30.08	381745.3927	2441319.7113		
Project: 23099-90-04004 Land Desktop Horizontal Alignment PI Station Report. Alignment: Phase 1 Road W Desc:				
PI Station	Northing	Easting	Distance	Direction
49+00	382237.0631	2441895.7434	575.0000	S 03-55-55 W
54+75	381663.4165	2441856.3150		

POINT	STATION	OFFSET	ALIGNMENT	RADIUS
A	49+14.9	L17.5'	PHASE 1 TXY E	25'
B	100+76.5	L65'	TAXILANE A	52.5'
C	100+76.5	R65'	TAXILANE A	52.5'
D	105+10	R37.5'	TAXILANE A	25'
E	105+10	L37.5'	TAXILANE B	25'
F	105+10	R37.5'	TAXILANE B	25'
G	100+84	R72.5'	TAXILANE B	60'
H	105+10	L42.5'	TAXILANE C	25'
I	100+81	R75'	TAXILANE C	57.5'
J	105+10	R42.5'	TAXILANE C	25'
K	105+60	L12.5'	TAXILANE A	-
L	53+40	L12.5'	PHASE 1 ROAD W	-
M	54+30	L3.1'	PHASE 1 TXY E	-
N				
O				
P				

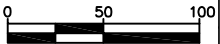

INITIAL
MJK

REVISION
AS BUILT

DATE
12/08

NO.
A

MEAD
HUNT

WAUKESHA COUNTY AIRPORT

DATE \$DATE\$

DESIGNED MJK
DRAWN MJK
CHECKED GAS

WAUKESHA COUNTY AIRPORT


HANGAR AREA
PROJECT LAYOUT
ALTERNATE NO. 1 AND NO. 2





A.I.P. PROJECT NO.
3-55-0090-22

JOB NO.
23099-90-04004

DWG NO.
9004004101.dwg

SHEET NO.
9 of 130

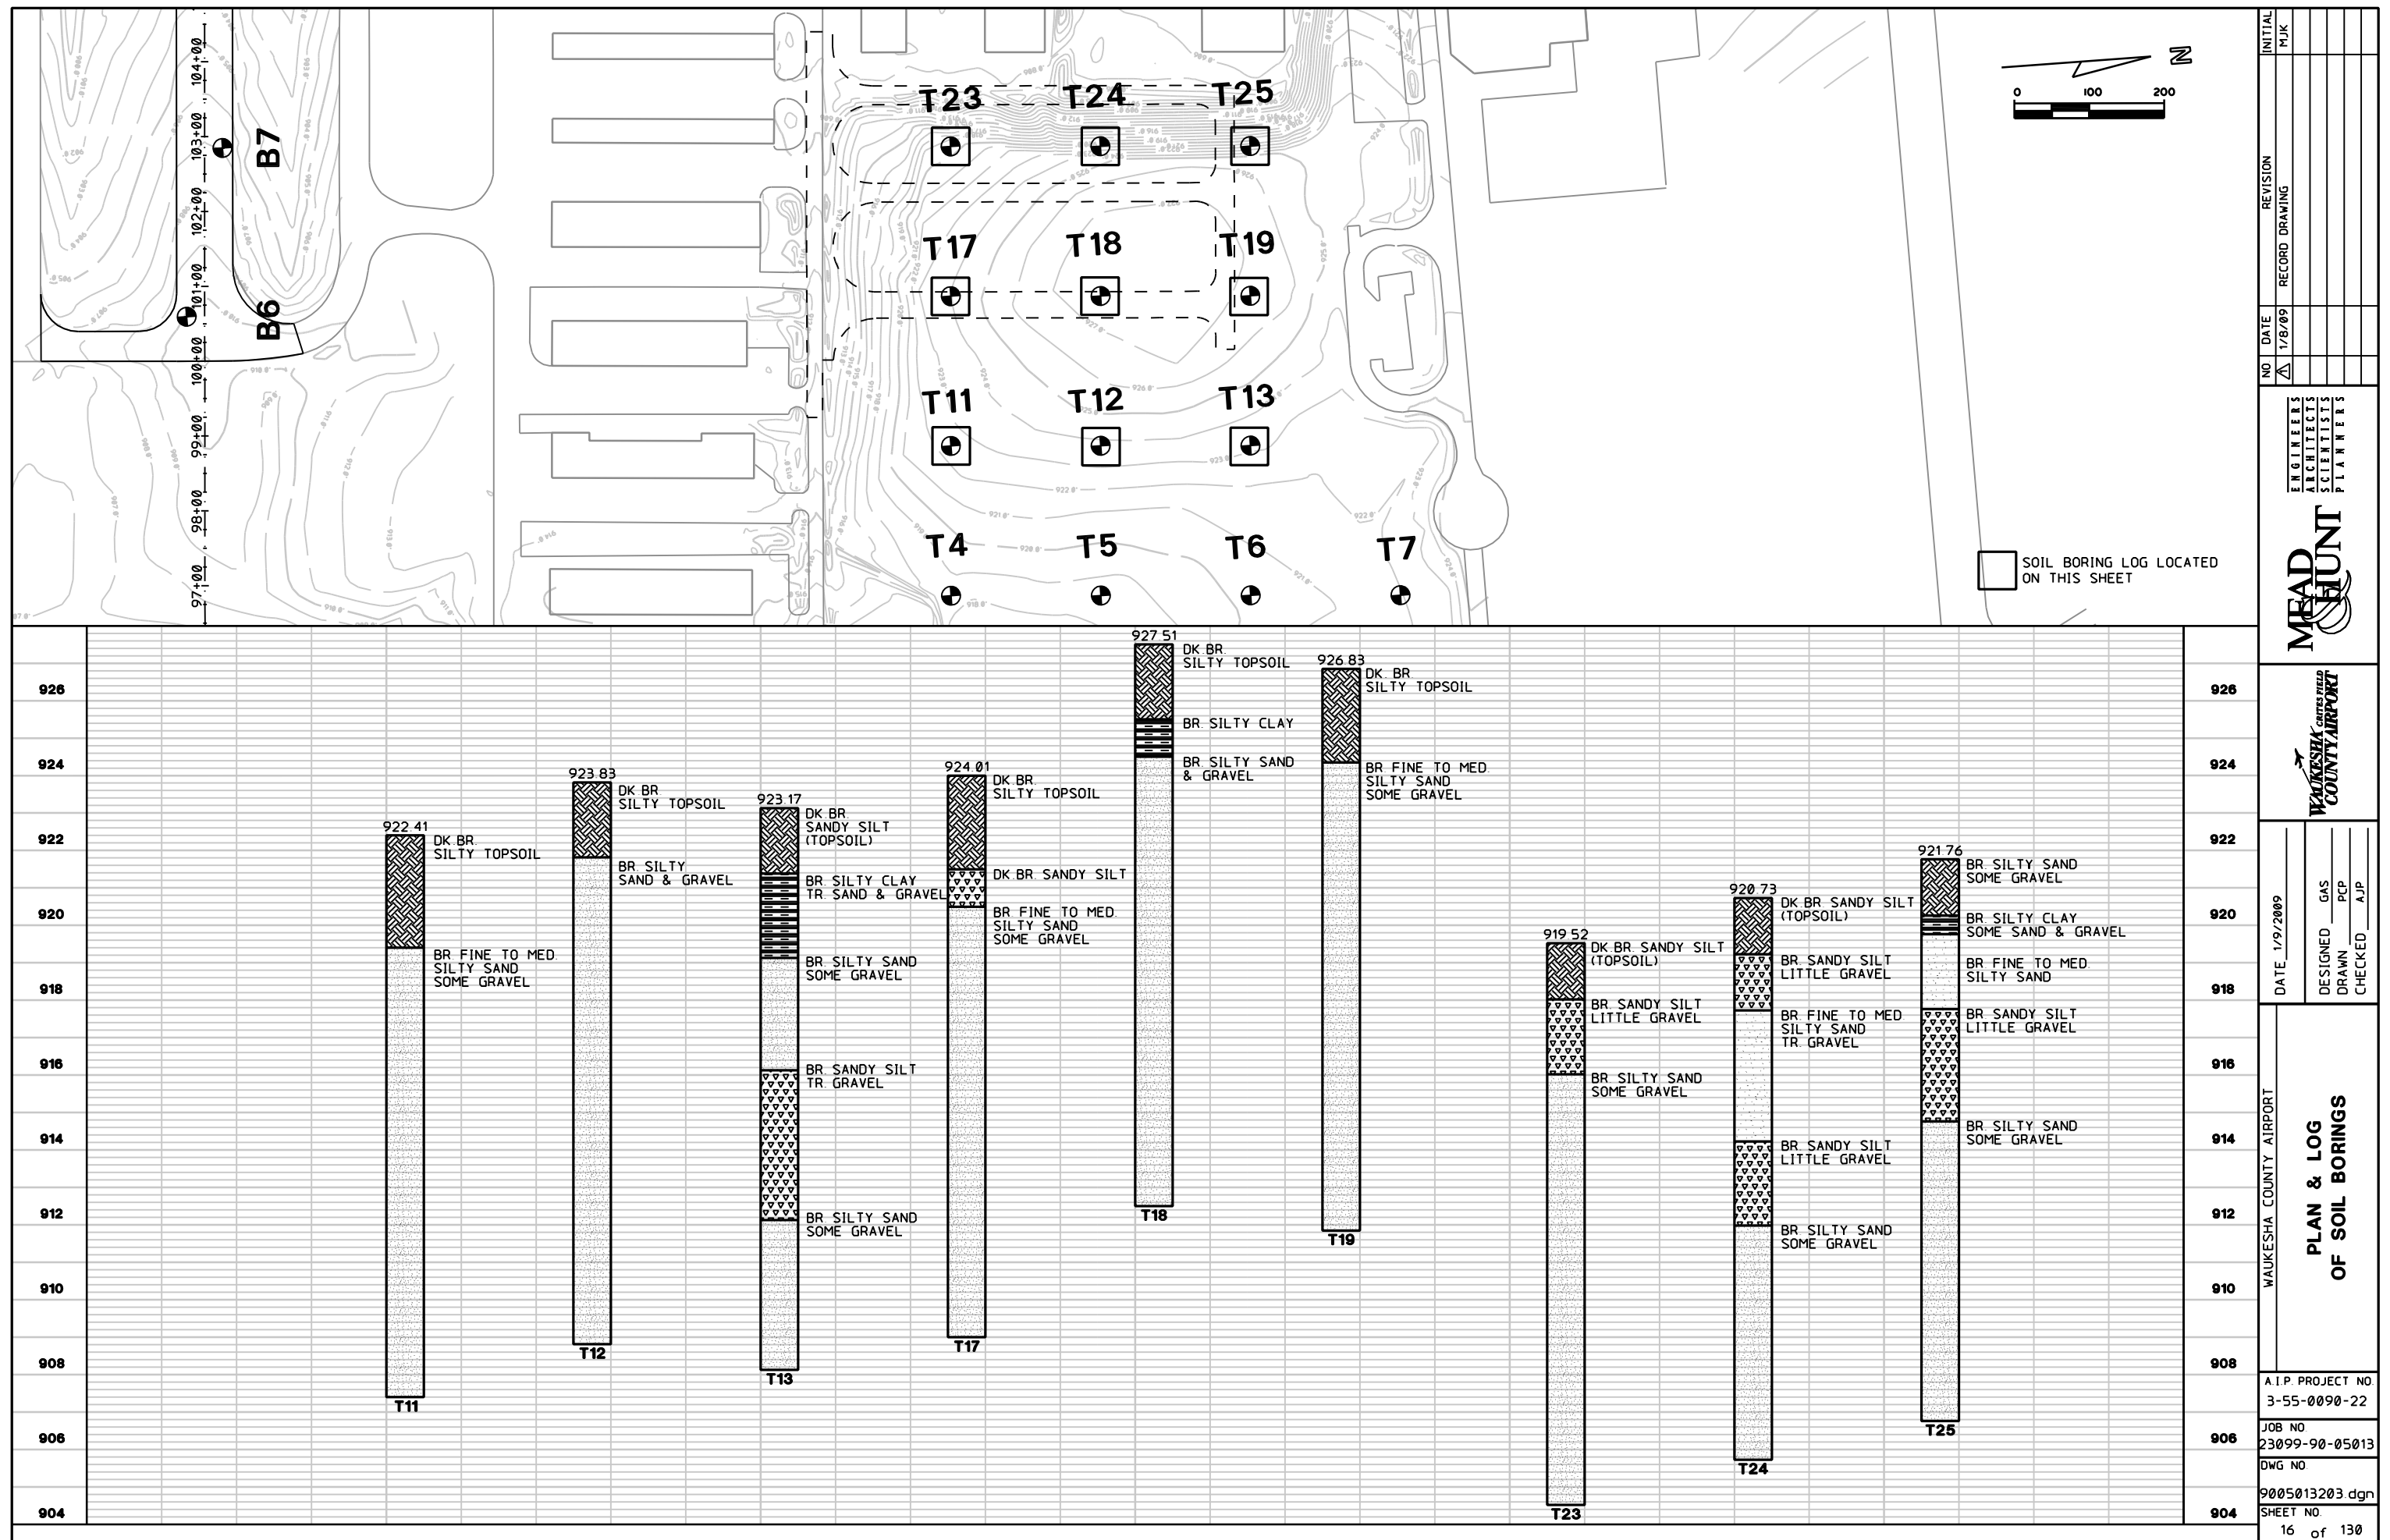



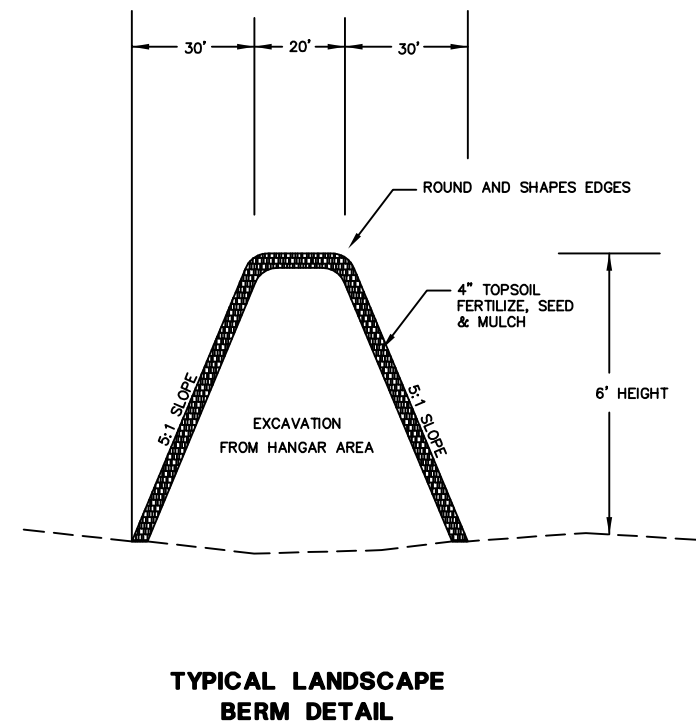
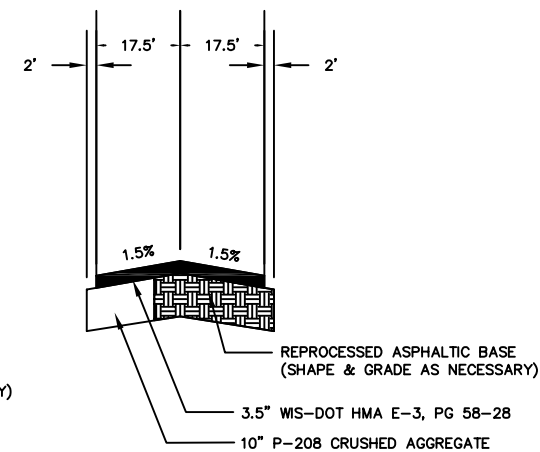
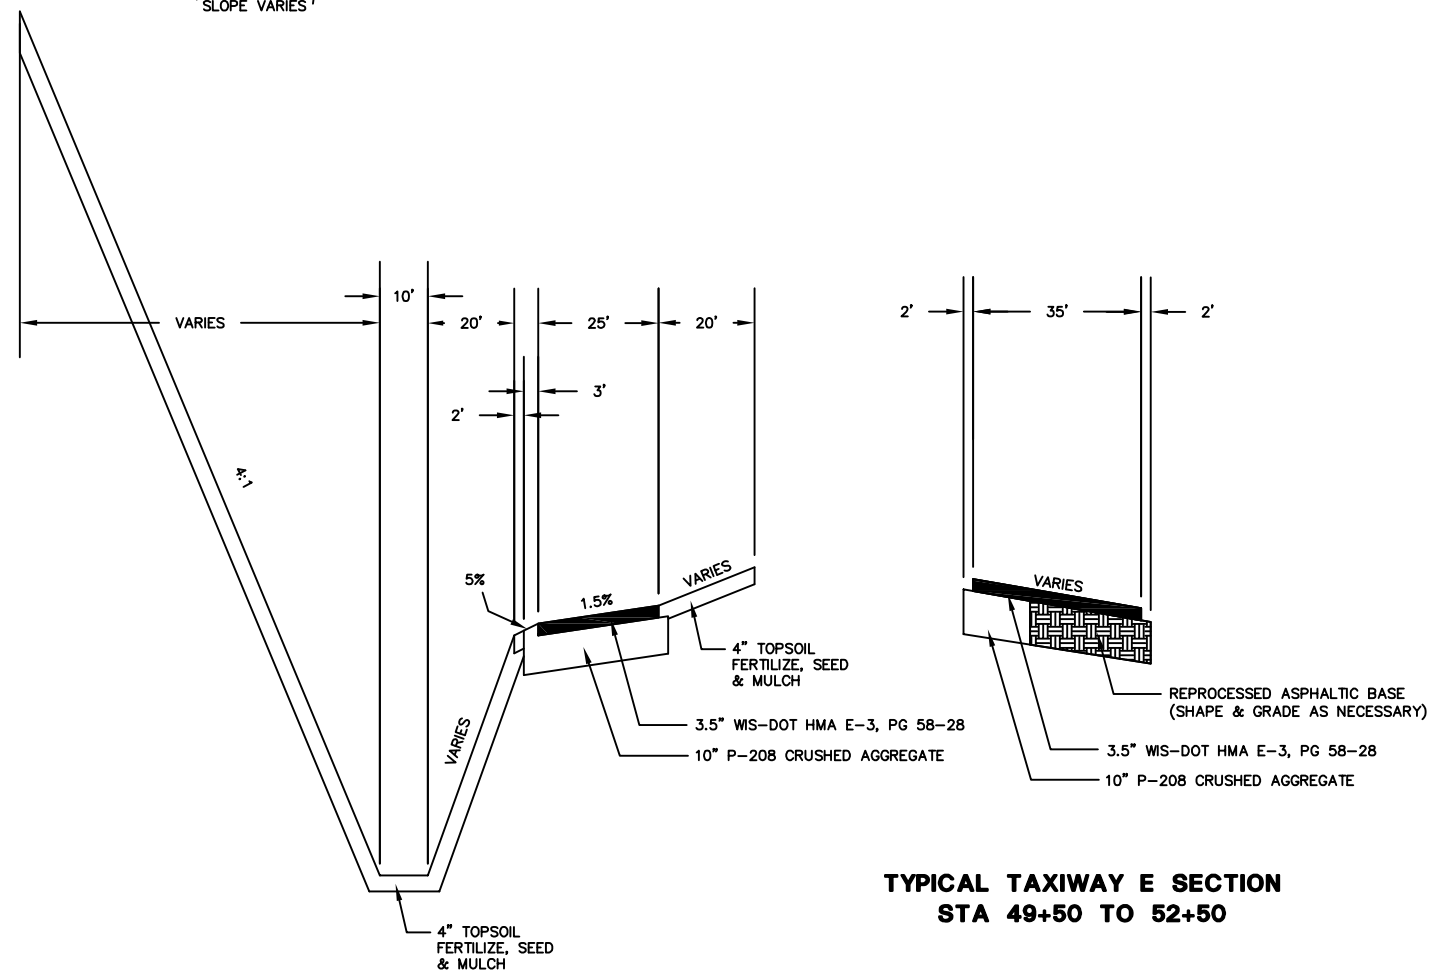
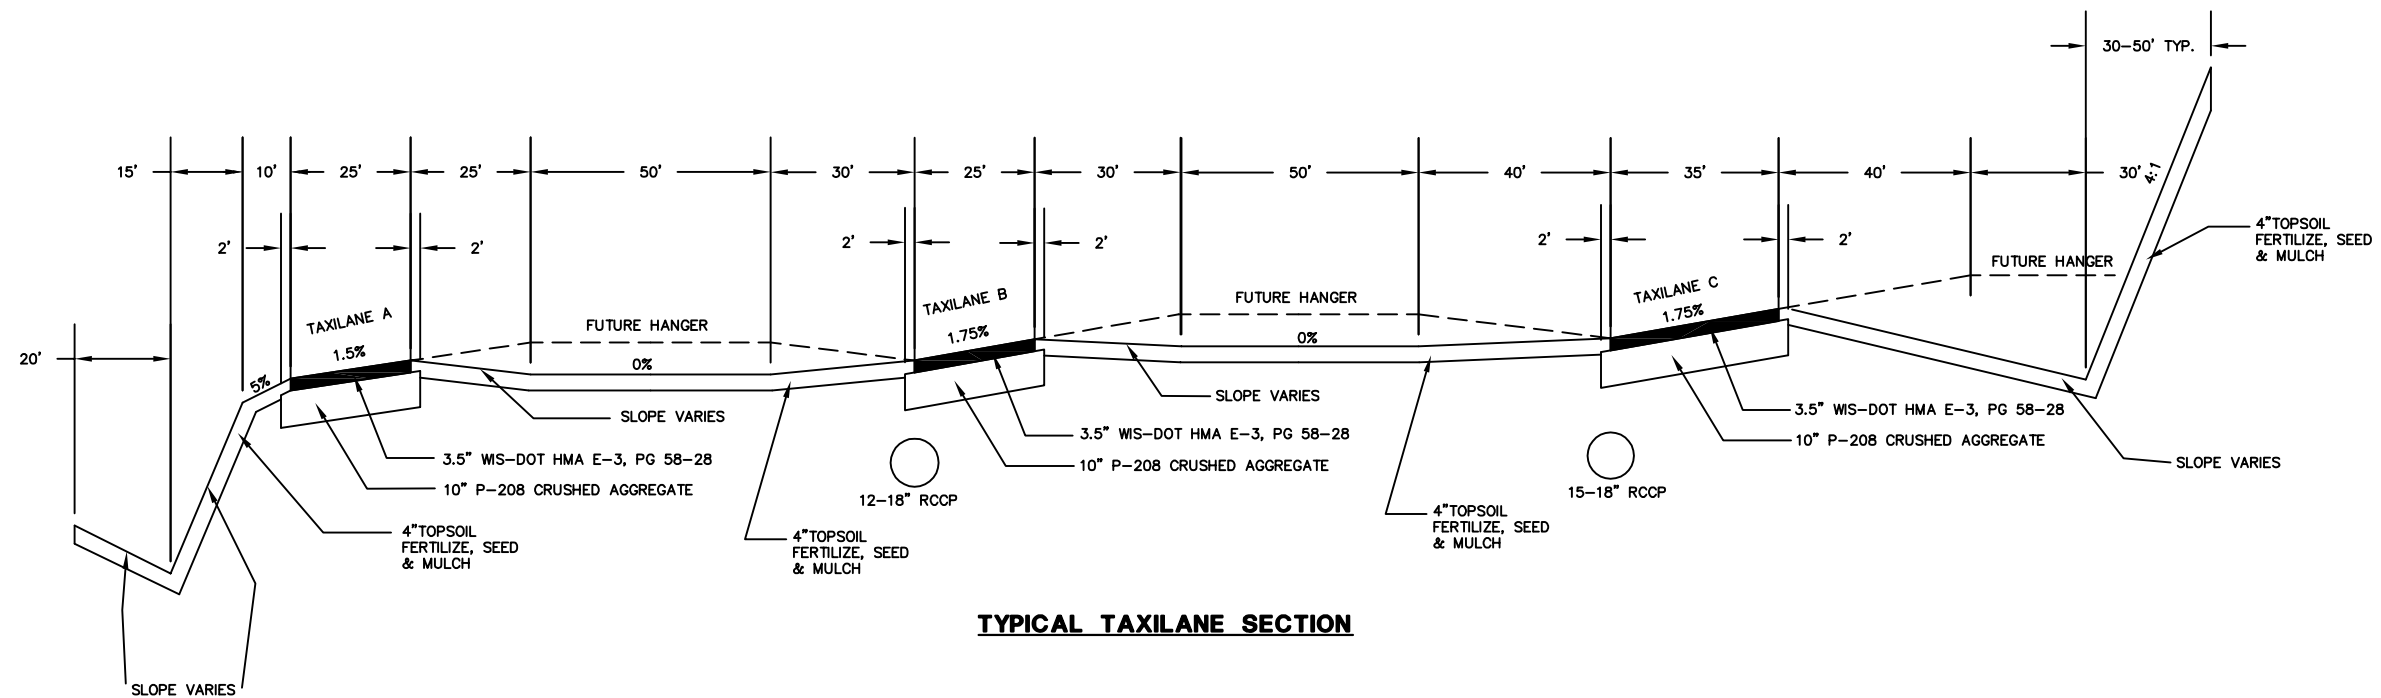


Waukesha County Airport TYPICAL SECTIONS		I.P. PROJECT NO 3-55-0090-22	
DATE 01/13/06		DESIGNED MJK DRAWN MJK CHECKED GAS	
			
SHEET NO. 18 of 130		DWG NO. 33099-90-04004.dwg	









THE DISCRETIONARY CONSTRUCTION SEQUENCE IS INCLUDED FOR INFORMATIONAL PURPOSES ONLY. THE CONTRACTOR IS SOLELY RESPONSIBLE FOR DESIGN AND EXECUTION OF THE CONSTRUCTION SEQUENCE AND CONSTRUCTION SAFETY.

DISCRETIONARY CONSTRUCTION SEQUENCE PROVIDED WITHIN THESE PLANS IS CONCEPTUAL IN NATURE AND AT THE CONTRACTOR'S OPTION DESCRIPTIONS AND GRAPHICS REPRESENTING DISCRETIONARY OPERATIONS DO NOT ADDRESS ALL CONTRACT REQUIREMENTS AND SHALL NOT BE CONSTRUED TO LIMIT THE CONTRACTOR'S RESPONSIBILITIES. NO REPRESENTATION, WARRANTY, OR GUARANTEE IS MADE THAT THE DISCRETIONARY CONSTRUCTION SEQUENCE PRESENTED WITHIN THESE PLANS IS COMPREHENSIVE.

SEE SPECIAL PROVISIONS FOR ADDITIONAL REQUIREMENTS

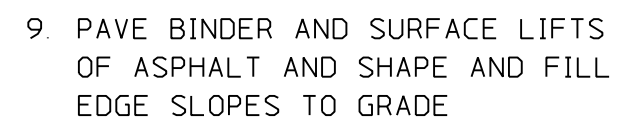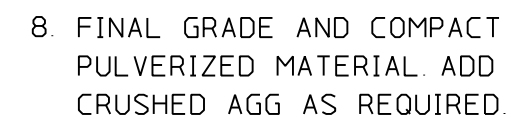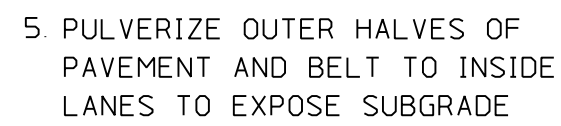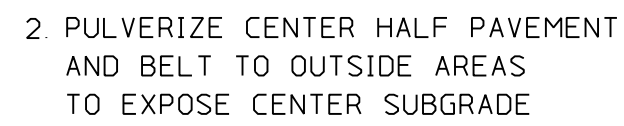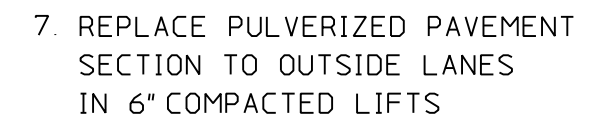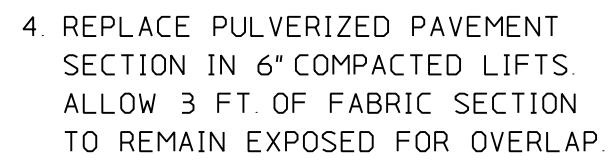

WAUKESHA COUNTY AIRPORT ALTERNATE NO. 4 DISCRETIONARY CONSTRUCTION SEQUENCE		DATE 1/8/2009 DESIGNED GAS DRAWN PCP CHECKED AJP			ENGINEERS ARCHITECTS SCIENTISTS PLANNERS	NO DATE REVISION INITIAL
A.I.P. PROJECT NO 3-55-0090-22						
JOB NO 23099-90-05013						
DWG NO 9005013230 dgn						
SHEET NO 19 of 130						

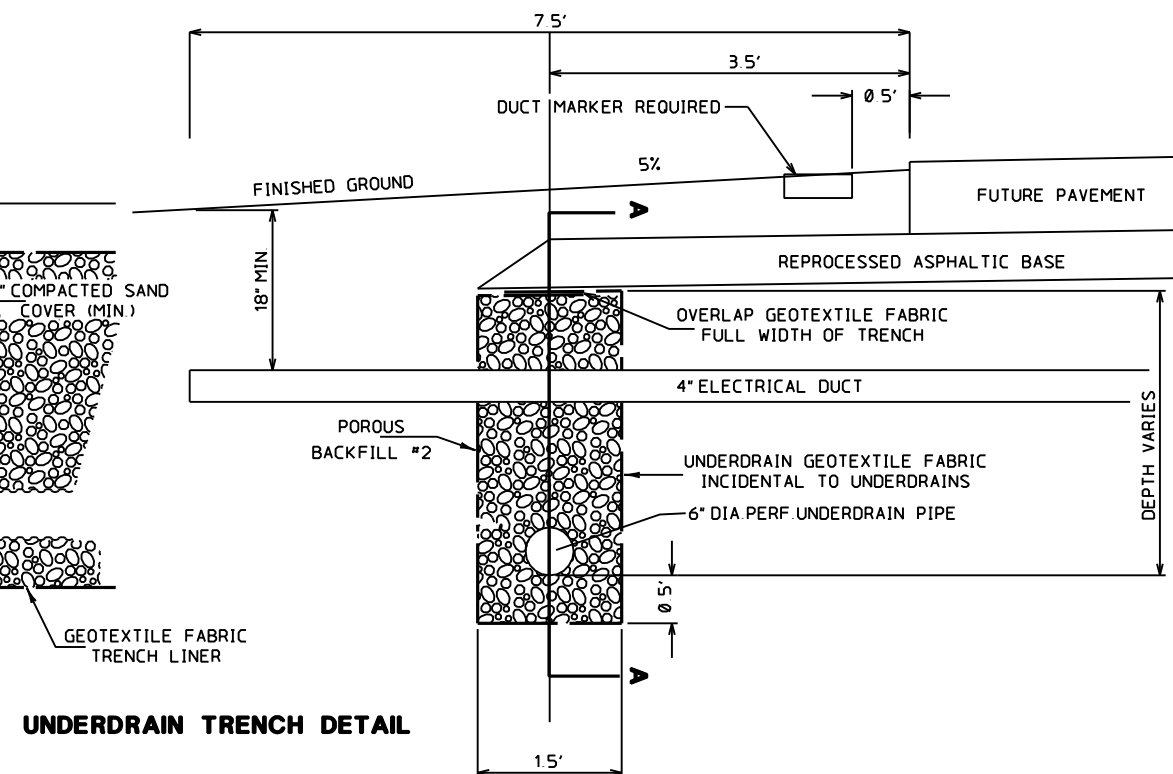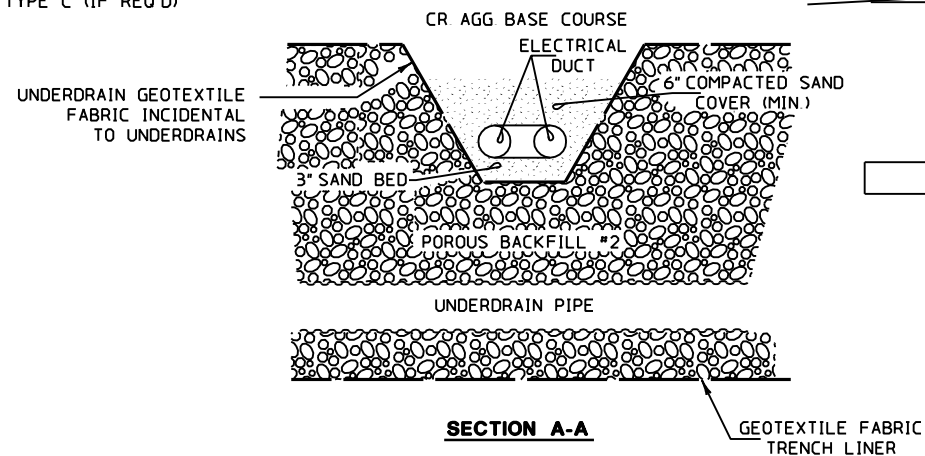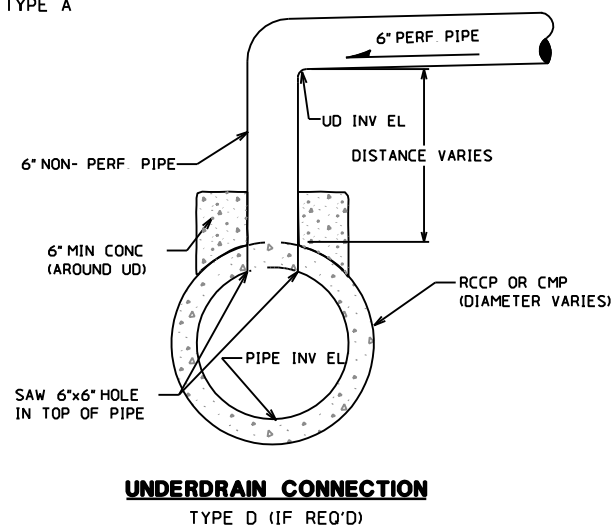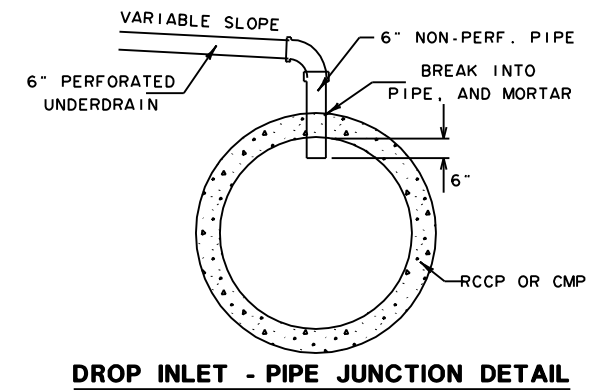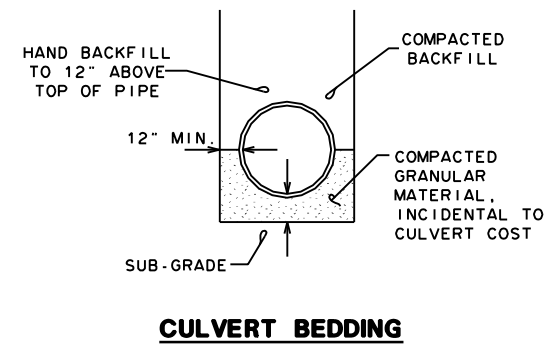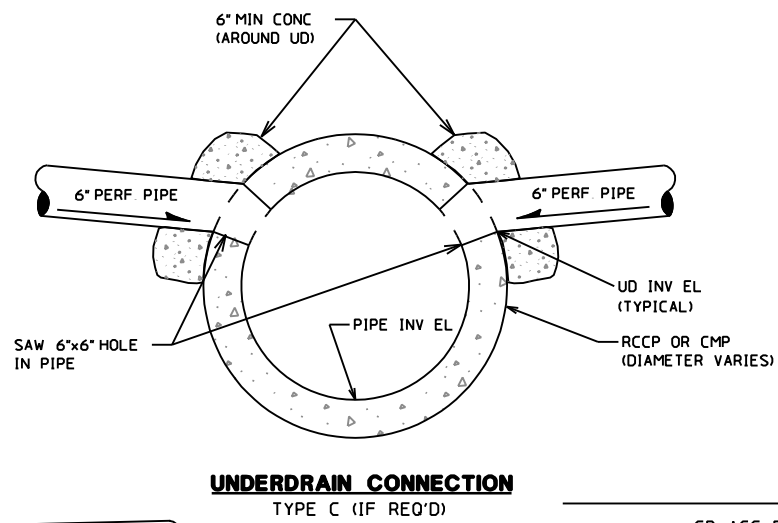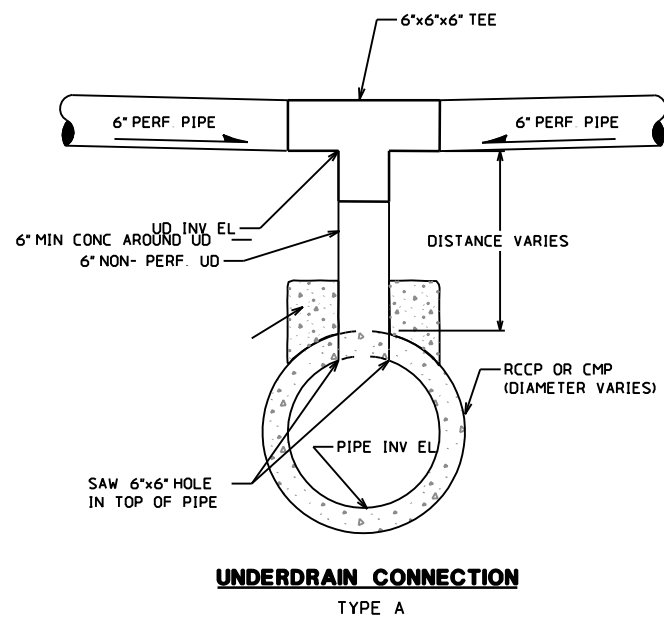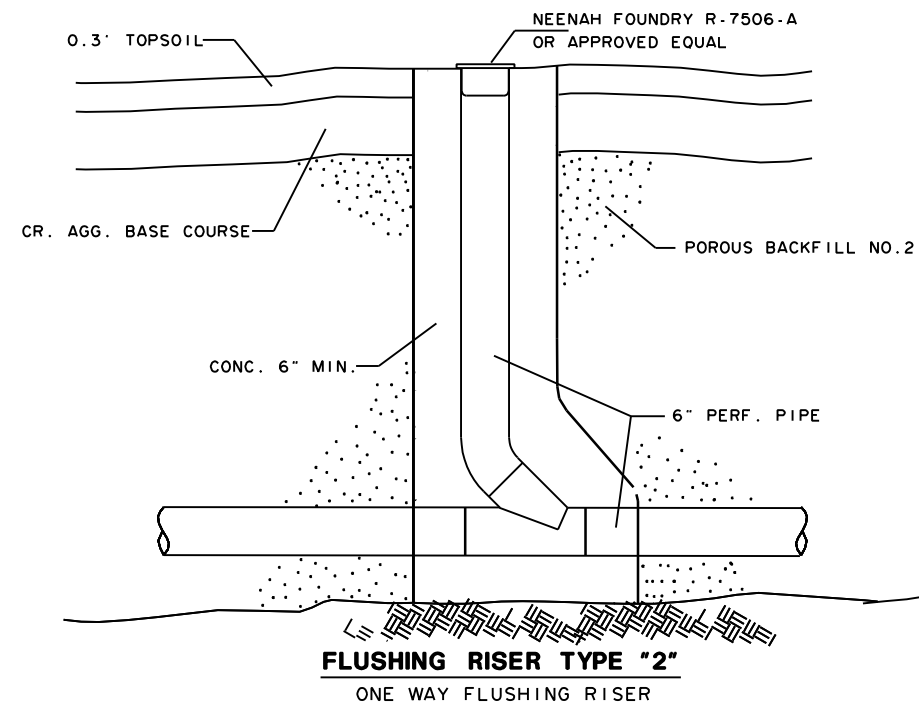

WAUKESHA COUNTY AIRPORT DRAINAGE DETAILS		DATE 1/8/2009		DESIGNED <u>DNE</u> DRAWN <u>TJR</u> CHECKED <u>AJP</u>		 MEAD & ELIANT ENGINEERS ARCHITECTS SCIENTISTS PLANNERS		RECORD DRAWING		REVISION		DATE		NO.		INITIAL											
A.I.P. PROJECT NO. 3-55-0090-22														JOB NO. 23099-90-05013													
DWG NO. 9005013240.dgn																											
SHEET NO. 20 of 130																											




PLAN VIEW

PLACEMENT OF STRAW BARRIER IN DRAINAGE WAY



FABRIC SHALL BE PLACED AT THE ENGINEERS DIRECTION
MANUFACTURED ALTERNATIVES APPROVED AND LISTED ON THE
DEPARTMENT'S EROSION CONTROL PRODUCT ACCEPTABILITY LIST
MAY BE SUBSTITUTED FOR THE INLET TYPE SPECIFIED
WHEN REMOVING OR MAINTAINING INLET PROTECTION. CARE SHALL
BE GIVEN SO THAT SEDIMENT TRAPPED ON THE GEOTEXTILE
FABRIC DOES NOT FALL INTO THE INLET, ANY MATERIAL FALLING
INTO THE INLET SHALL BE REMOVED IMMEDIATELY.

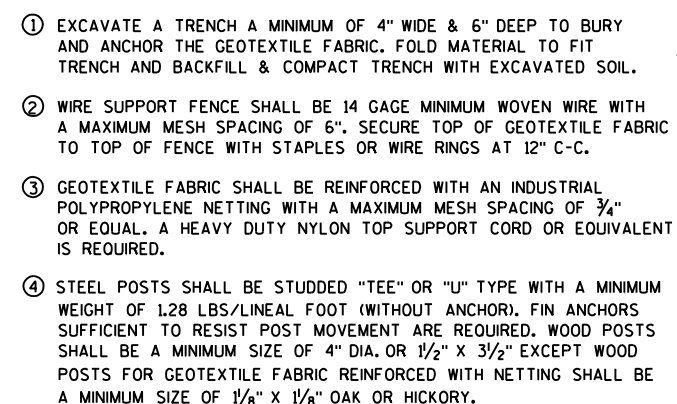

SILT FENCE DETAIL



NOTE: ALL EROSION CONTROL MEASURES TO CONFORM WITH
WISCONSIN DEPT. OF NATURAL RESOURCES
BEST MANAGEMENT PRACTICE HANDBOOK

WAUKESHA COUNTY AIRPORT		DATE 1/8/2009	DESIGNED GAS		 MEAD HUNT ENGINEERS ARCHITECTS SCIENTISTS PLANNERS	NO	DATE 1/8/09	REVISION	INITIAL	
DRAINAGE & EROSION CONTROL DETAILS		DRAWN PCP		RECORD DRAWING						MJK
		CHECKED AJP								
A.I.P. PROJECT NO. 3-55-0090-22		JOB NO. 23099-90-0501		DWG NO. 9005013241.dgn		SHEET NO. 22 of 130				





NO.	SIZE/TYPE	LENGTH	SLOPE
P1	12" RCCP	120'	0.5%
P2	15" RCCP	120'	0.5%
P3	18" RCCP	120'	0.5%
P4	18" RCCP	70'	0.5%
P5	15" RCCP	160'	0.5%
P6	18" RCCP	175'	0.7%
P7	18" RCCP	160'	0.5%
P8	21" RCCP	140'	0.5%
P9	21" RCCP	85'	1.4% 2.4-0
P10	24" RCCP	260'	0.3%
P11	24" RCCP	260'	0.6%
P12	24" RCCP	75'	0.7%
P13	36" RCCP	60'	0.2%
P14	12" CMP	30'	0.5%



A.I.P. PROJECT NO. 3-55-0090-22		WAUKESHA COUNTY AIRPORT		DATE \$DATE\$ DESIGNED MJK DRAWN MJK CHECKED GAS						NO. DATE 4/27/06 REVISION ADDENDUM NO. 1 AS BUILT		INITIAL	
JOB NO. 23099-90-04004													
DWG NO. 90040004124.dwg													
SHEET NO. 32 of 130													


X:\23099-90\06017\tech\cadd\drawings\AS-BUILT\HANGAR AREA\23099-90-04004 Land Desktop\dwg\23099-90-04004400.dwg



Jan 08, 2009 - 9:19pm

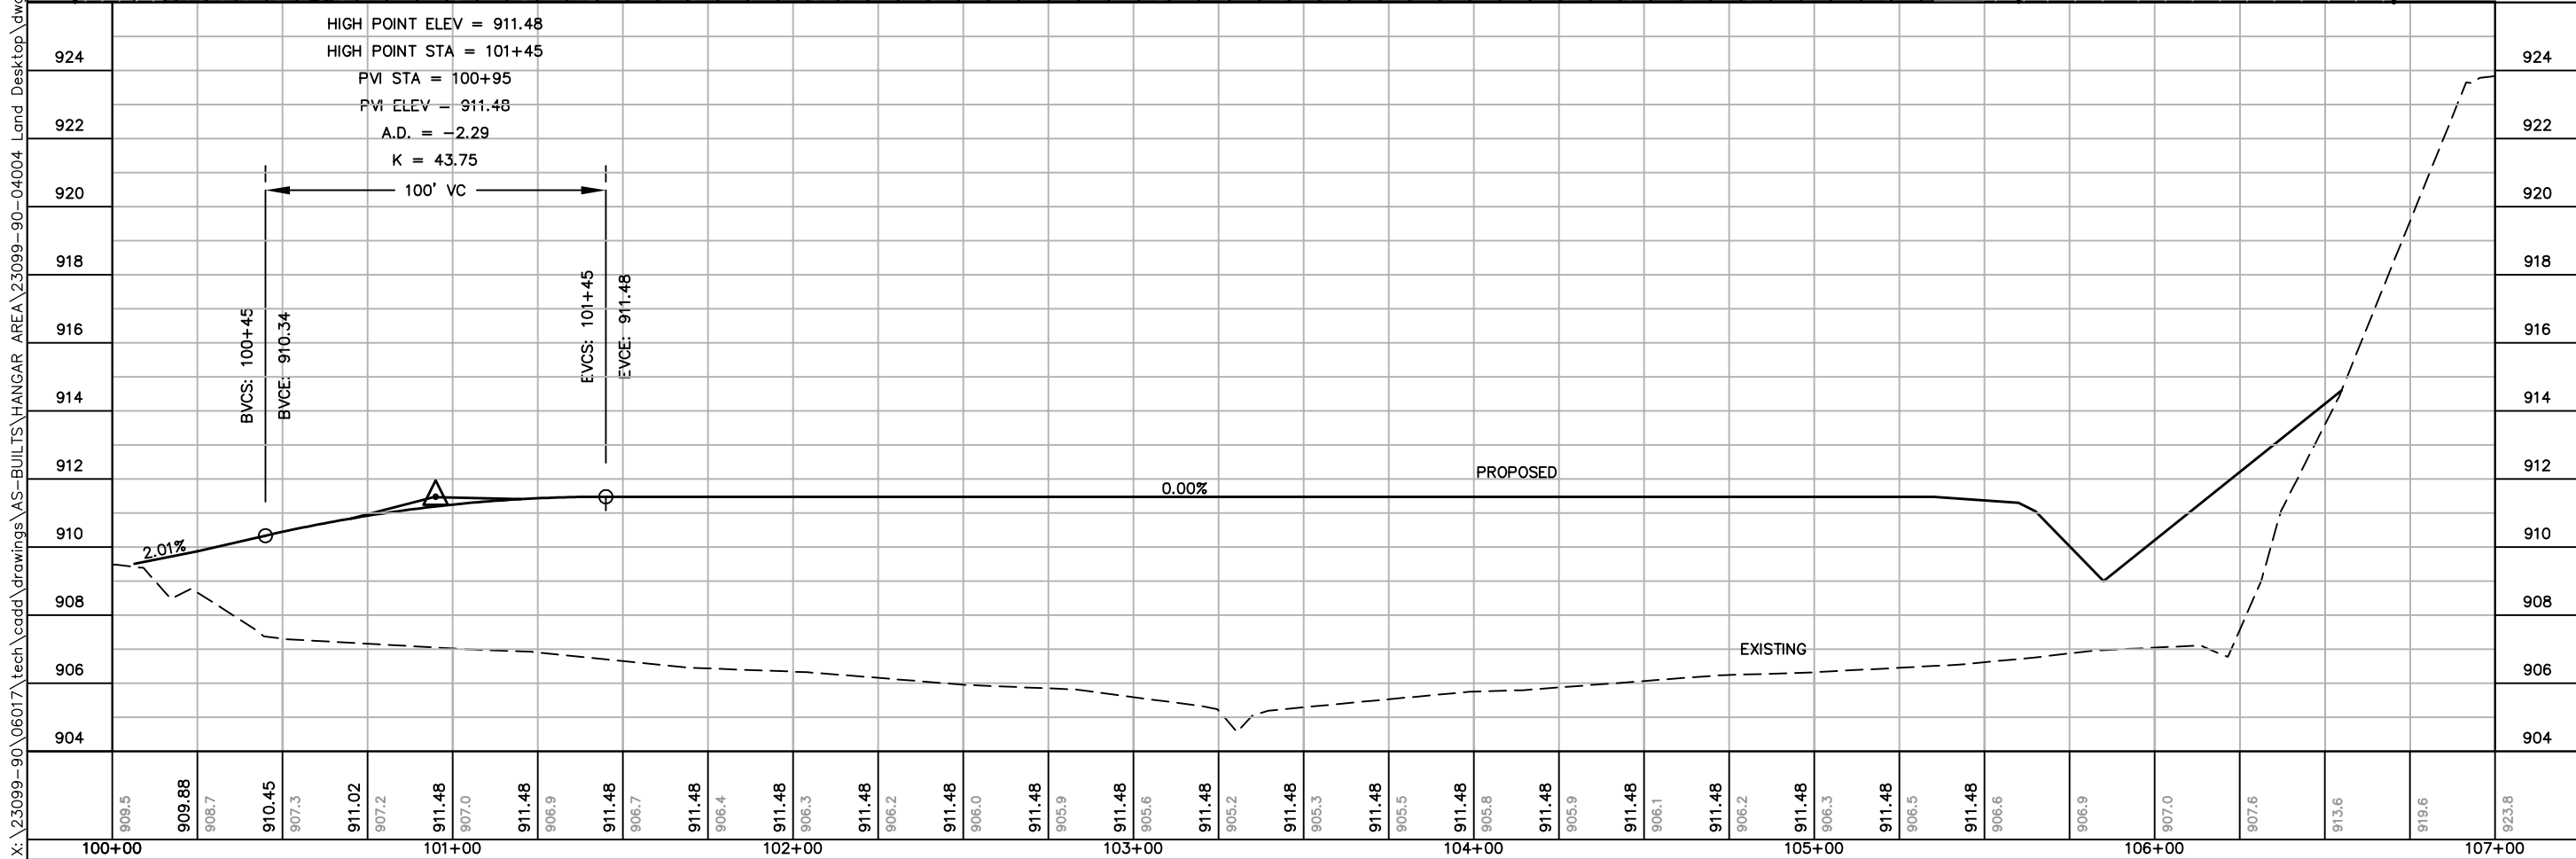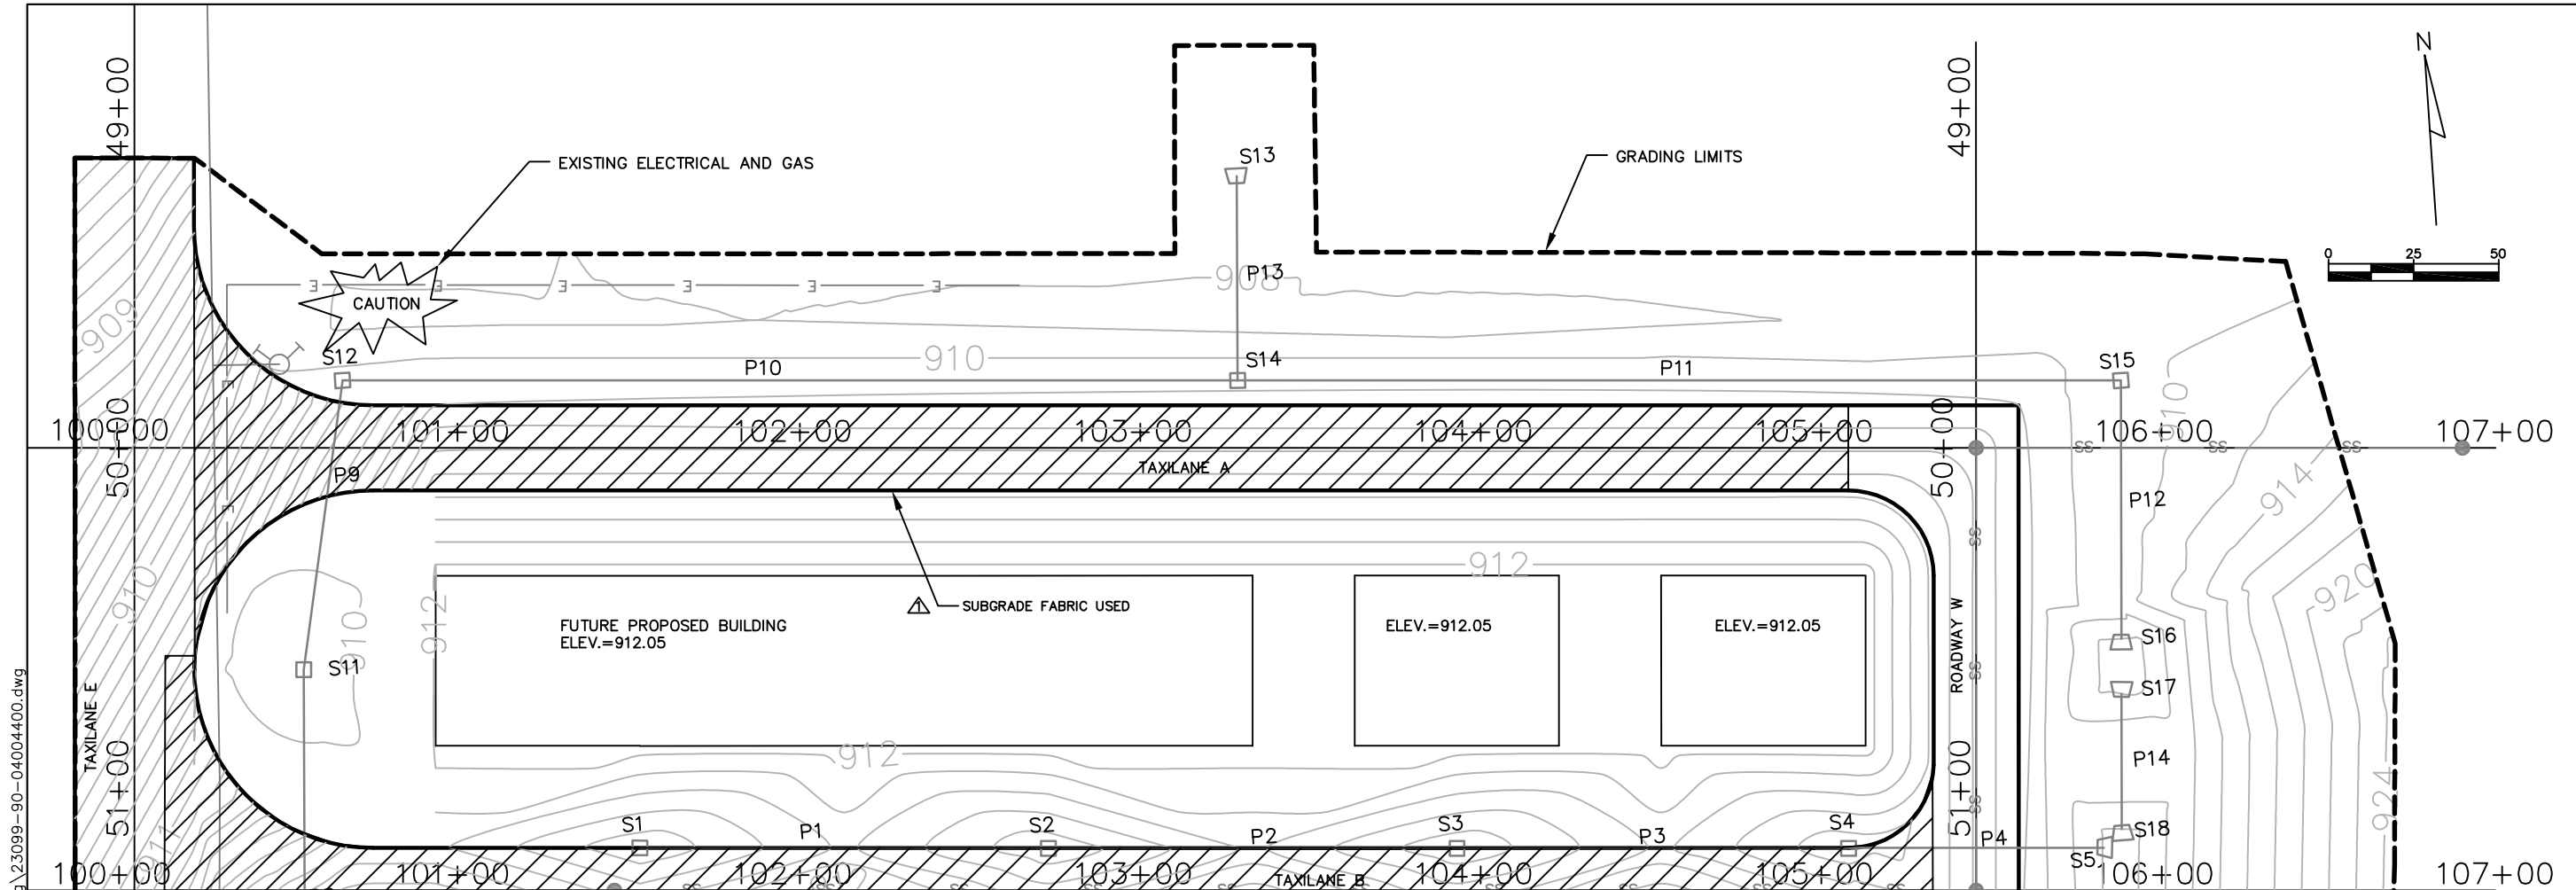


WAUKESHA COUNTY AIRPORT		DATE \$DATE\$		NO.		DATE		REVISION		INITIAL	
HANGAR AREA		DESIGNED MJK		12/08		AS-BUILT				MJK	
PLAN/PROFILE TAXILANE A		DRAWN MJK									
ALTERNATE NO. 1 AND NO. 2		CHECKED GAS									
A.I.P. PROJECT NO. 3-55-0090-22		WAUKESHA COUNTY AIRPORT		MEAD & HUNT							
JOB NO. 23099-90-04004		DESIGNED MJK									
DWG NO. 9004004400.dwg		DRAWN MJK									
SHEET NO. 39 of 130		CHECKED GAS									

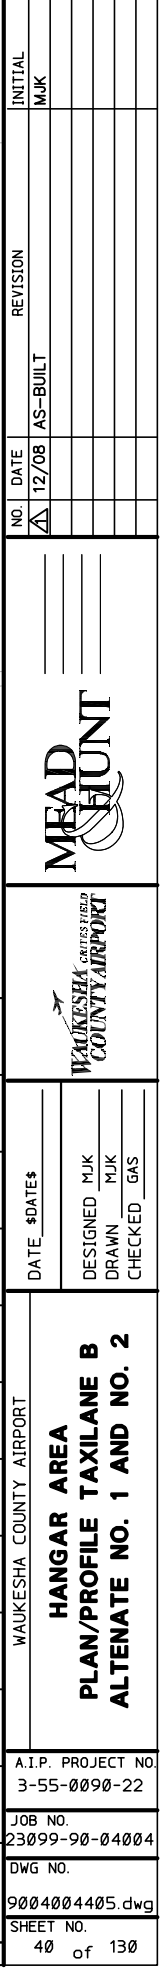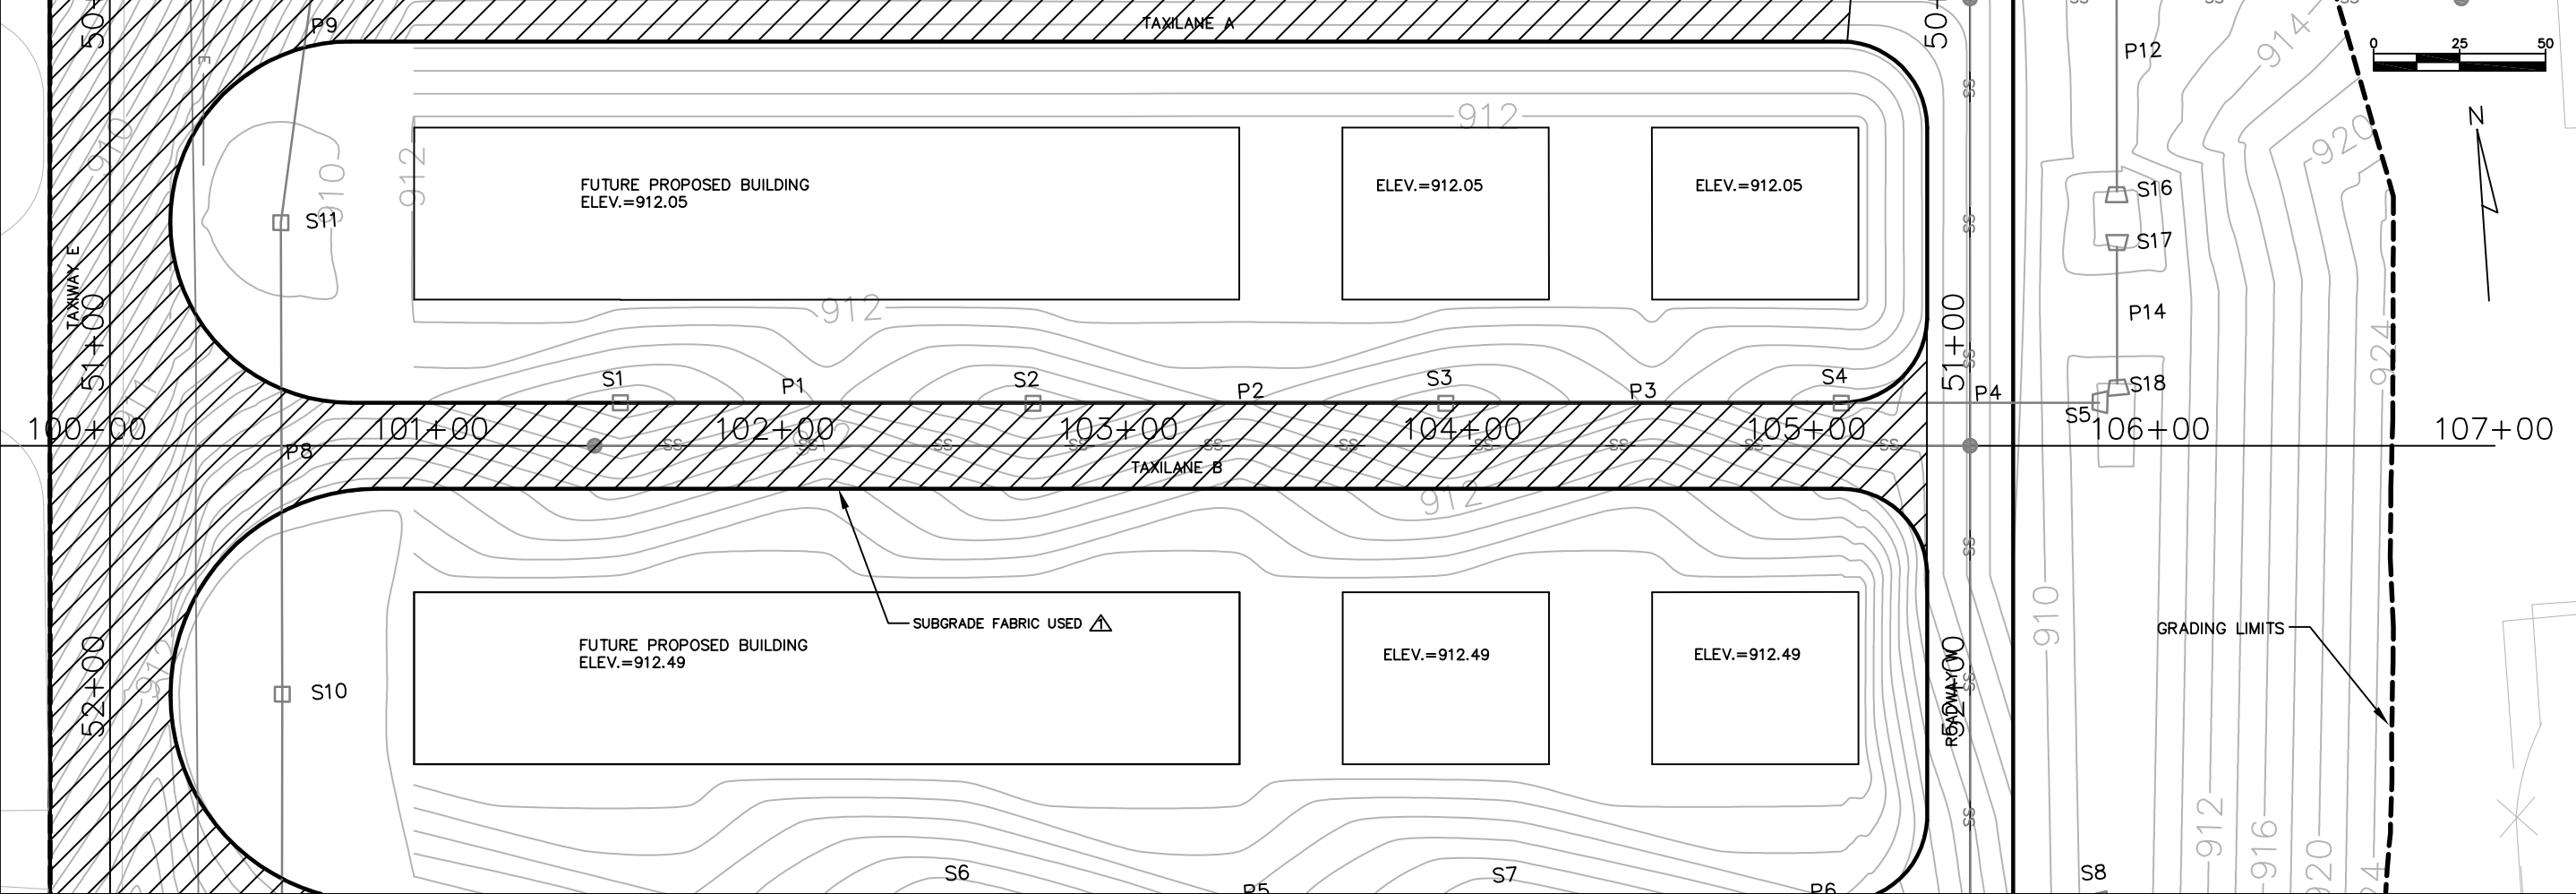


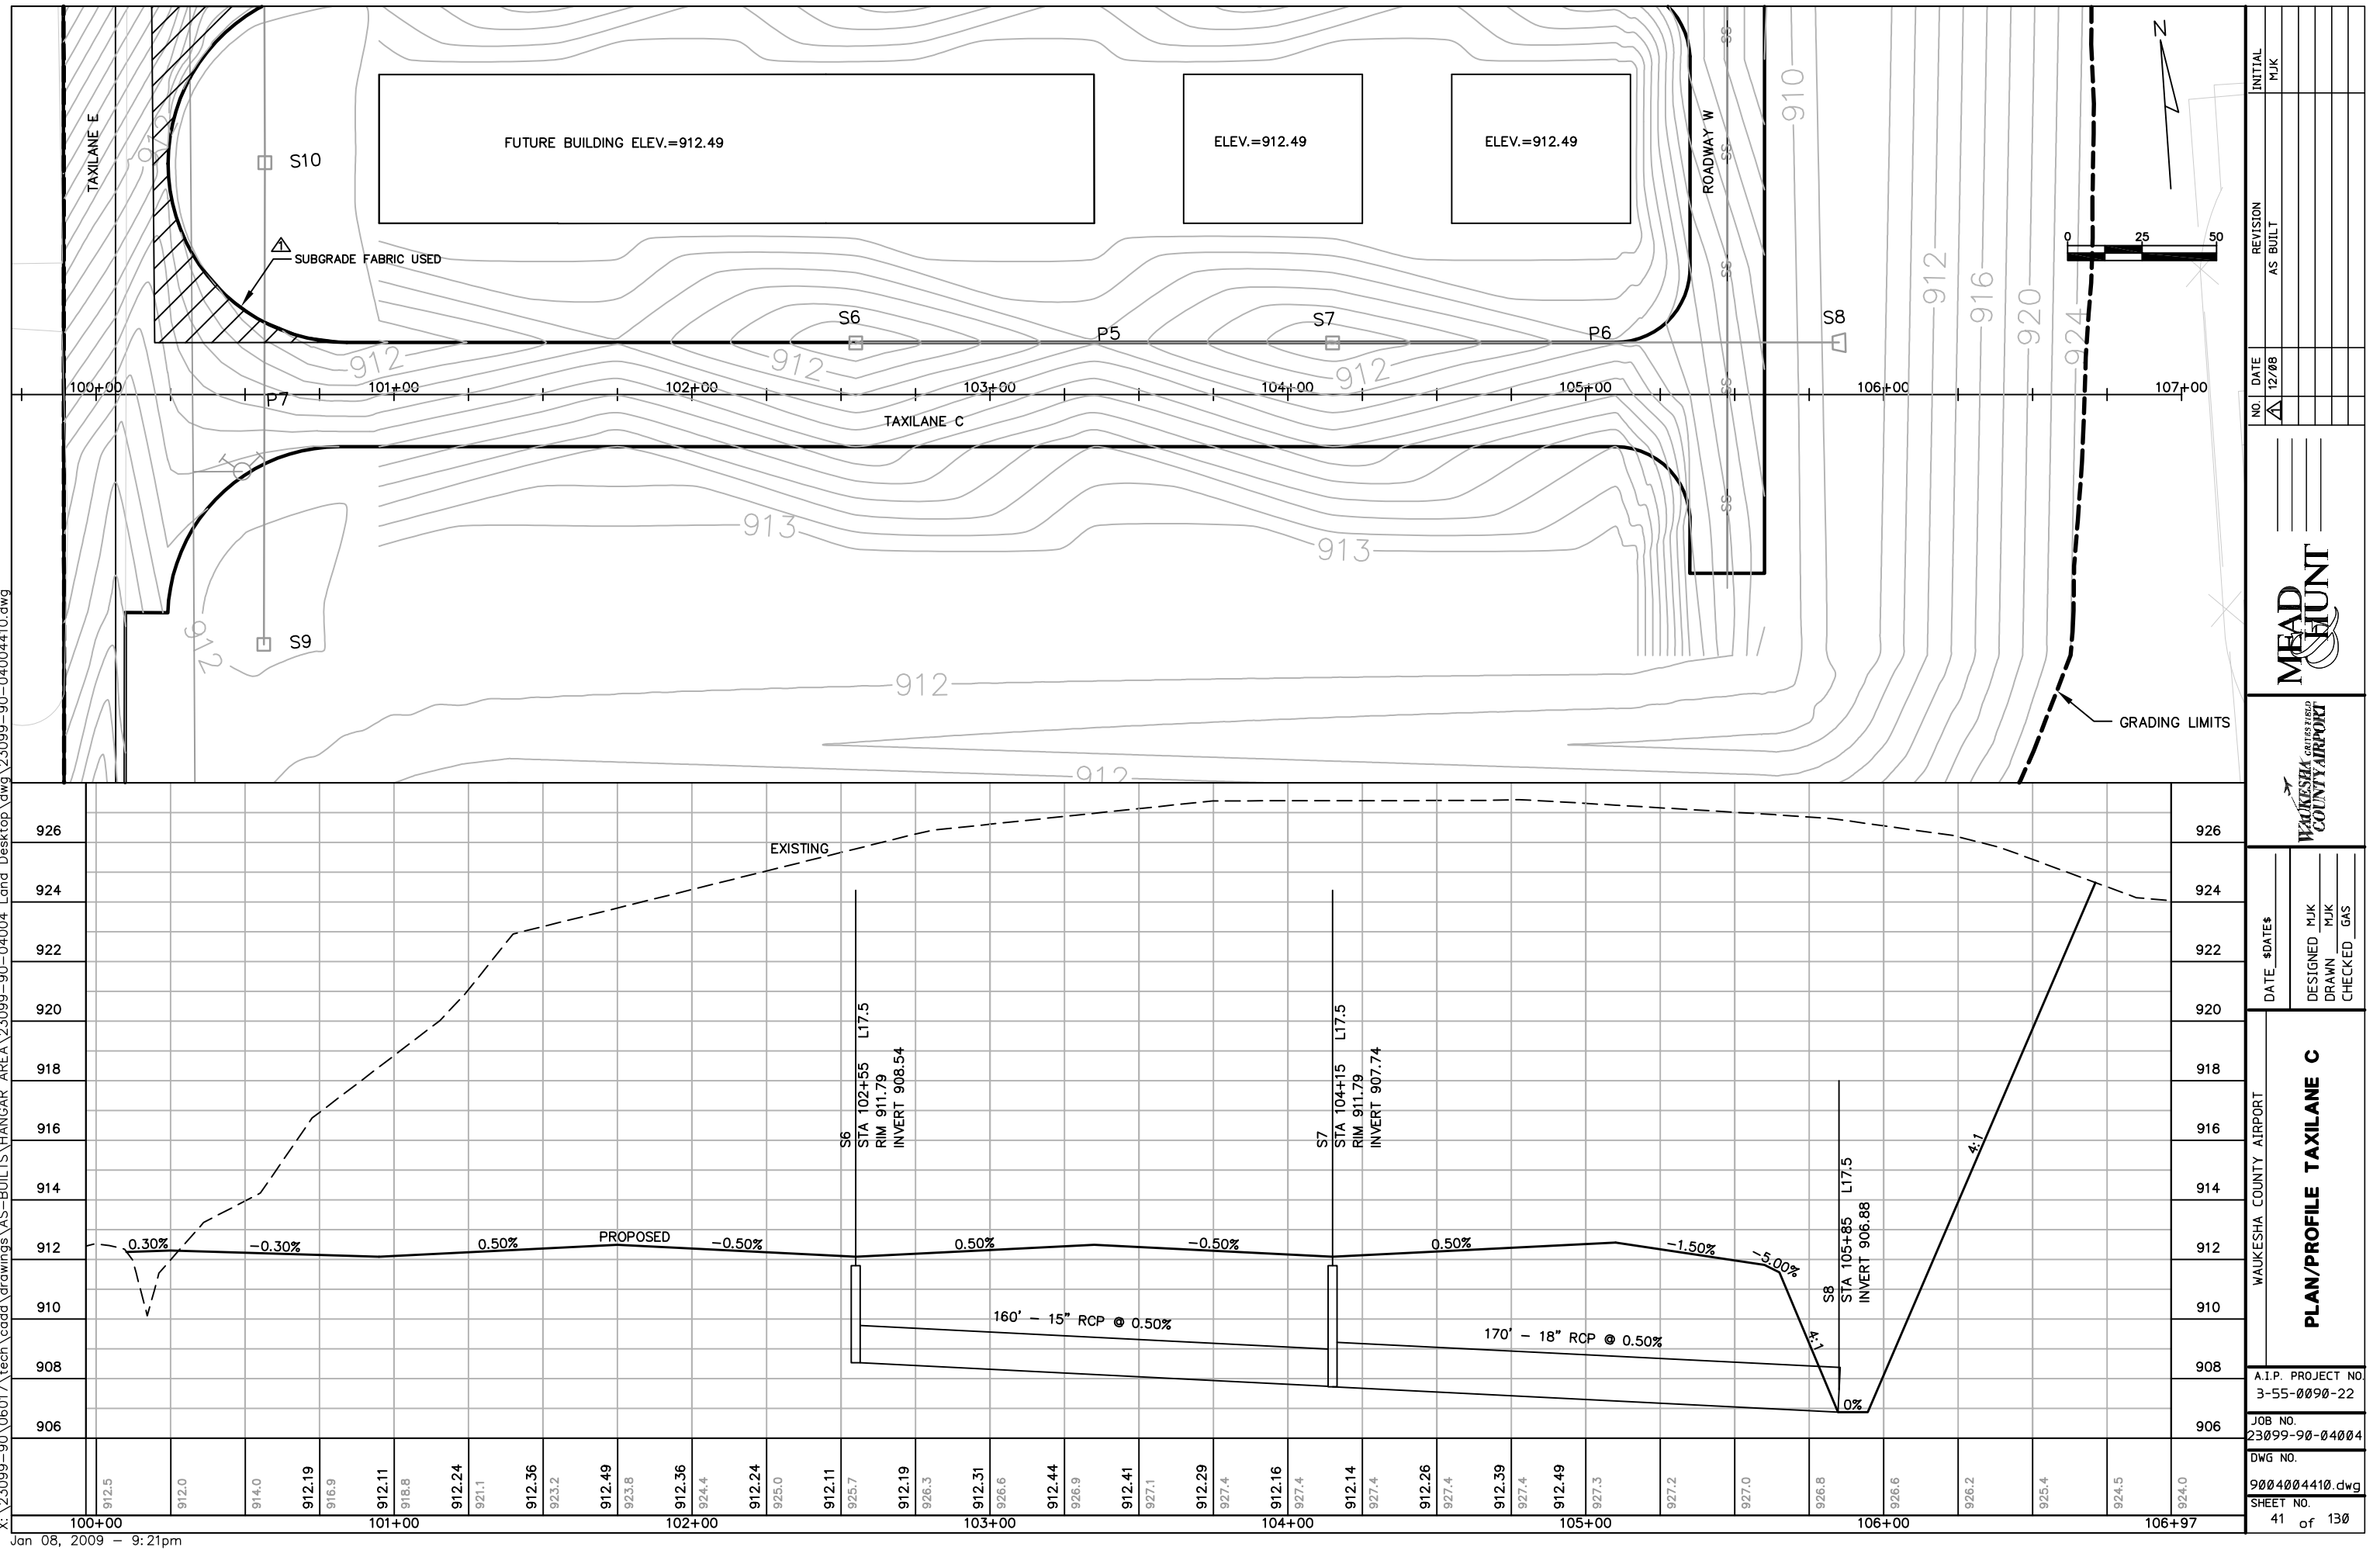

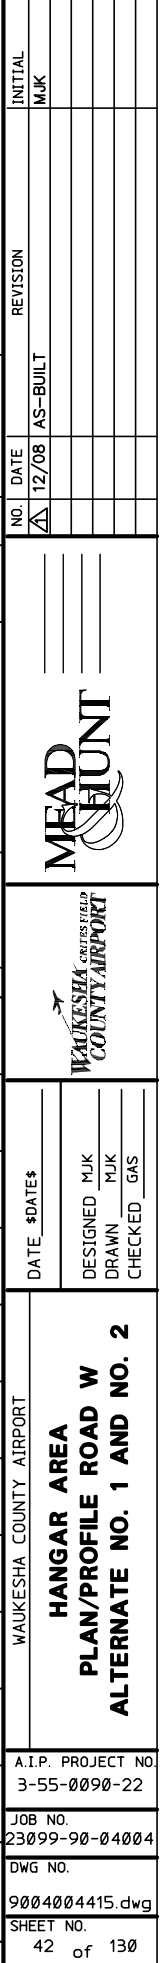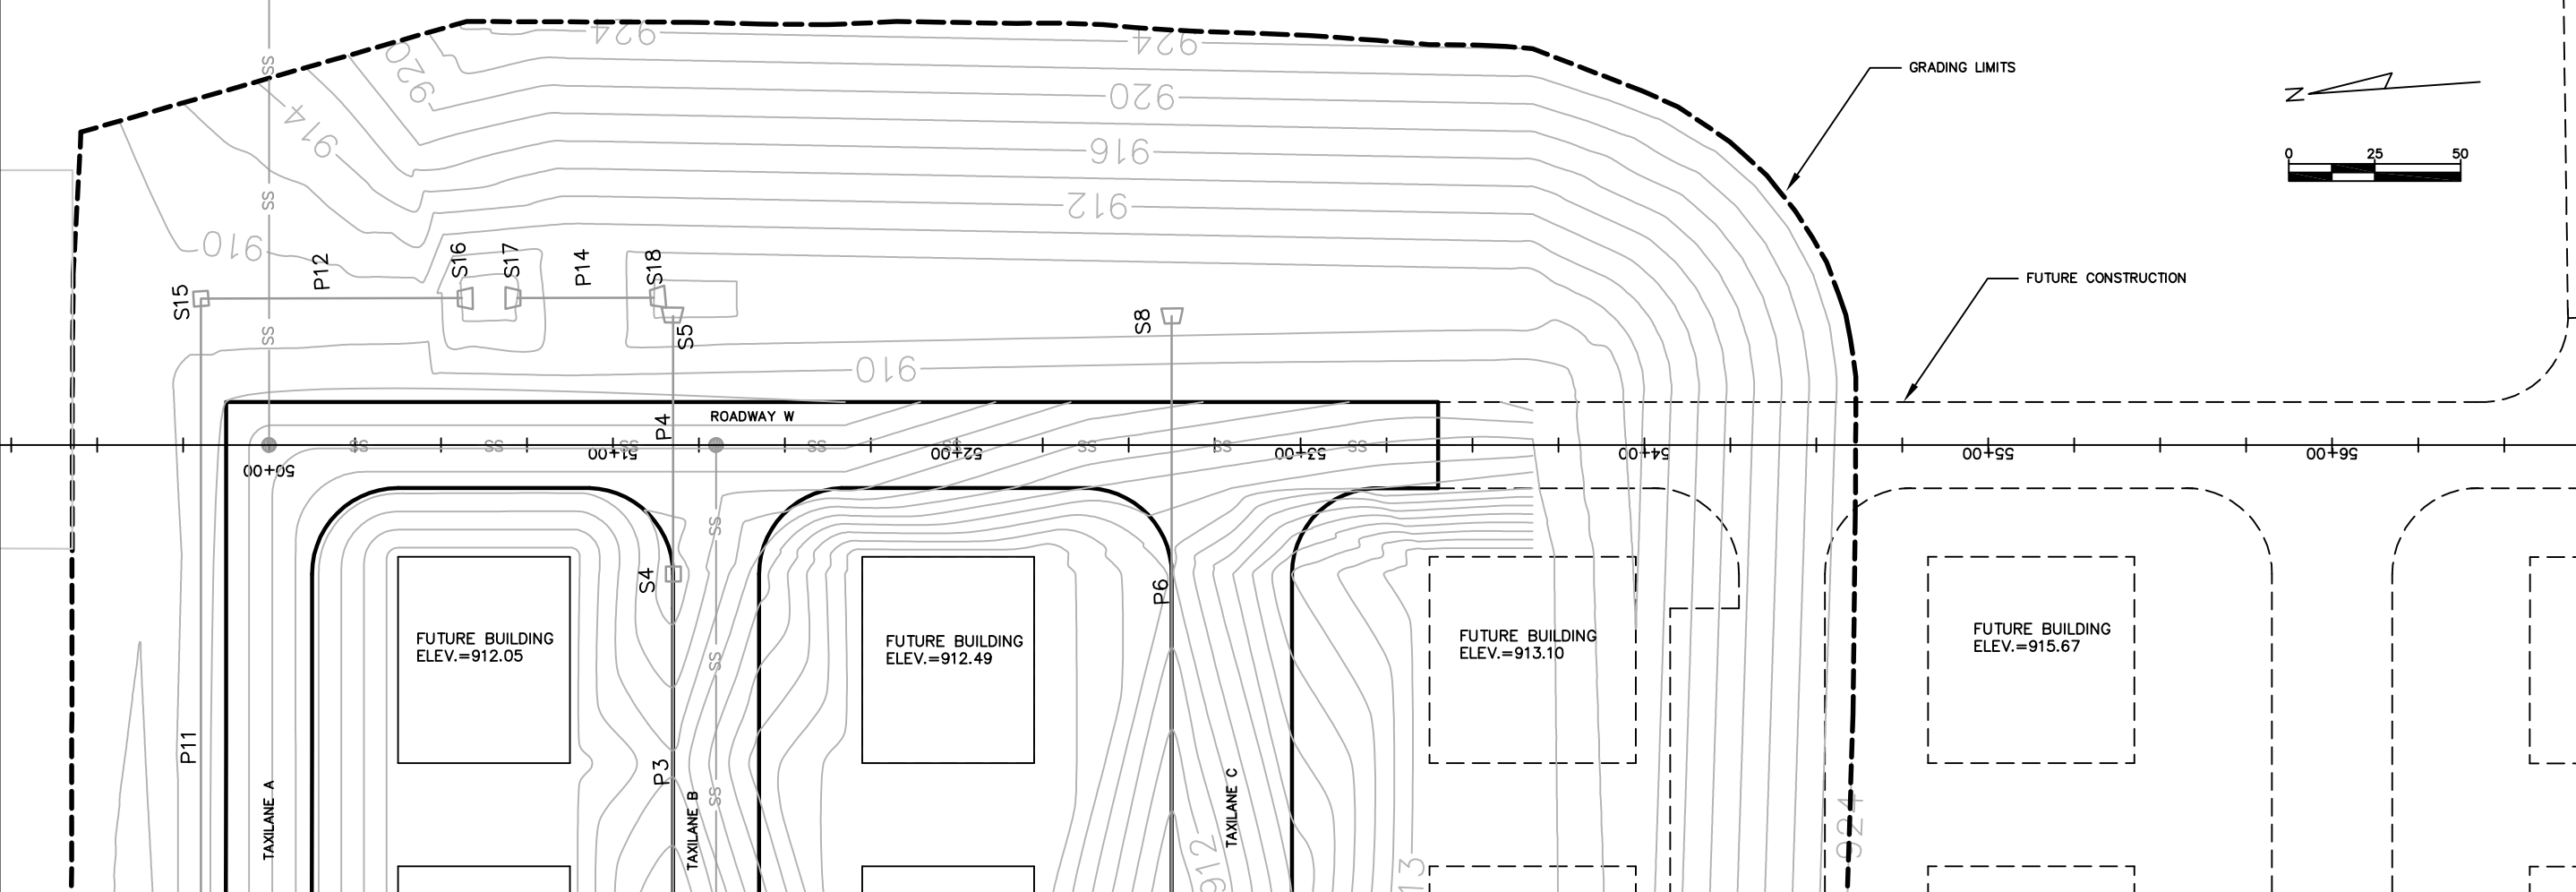

X:\23099-90\06017\tech\cadd\drawings\AS-BUILT\HANGAR AREA\23099-90-04004.Land Desktop\dwg\23099-90-04004420.dwg

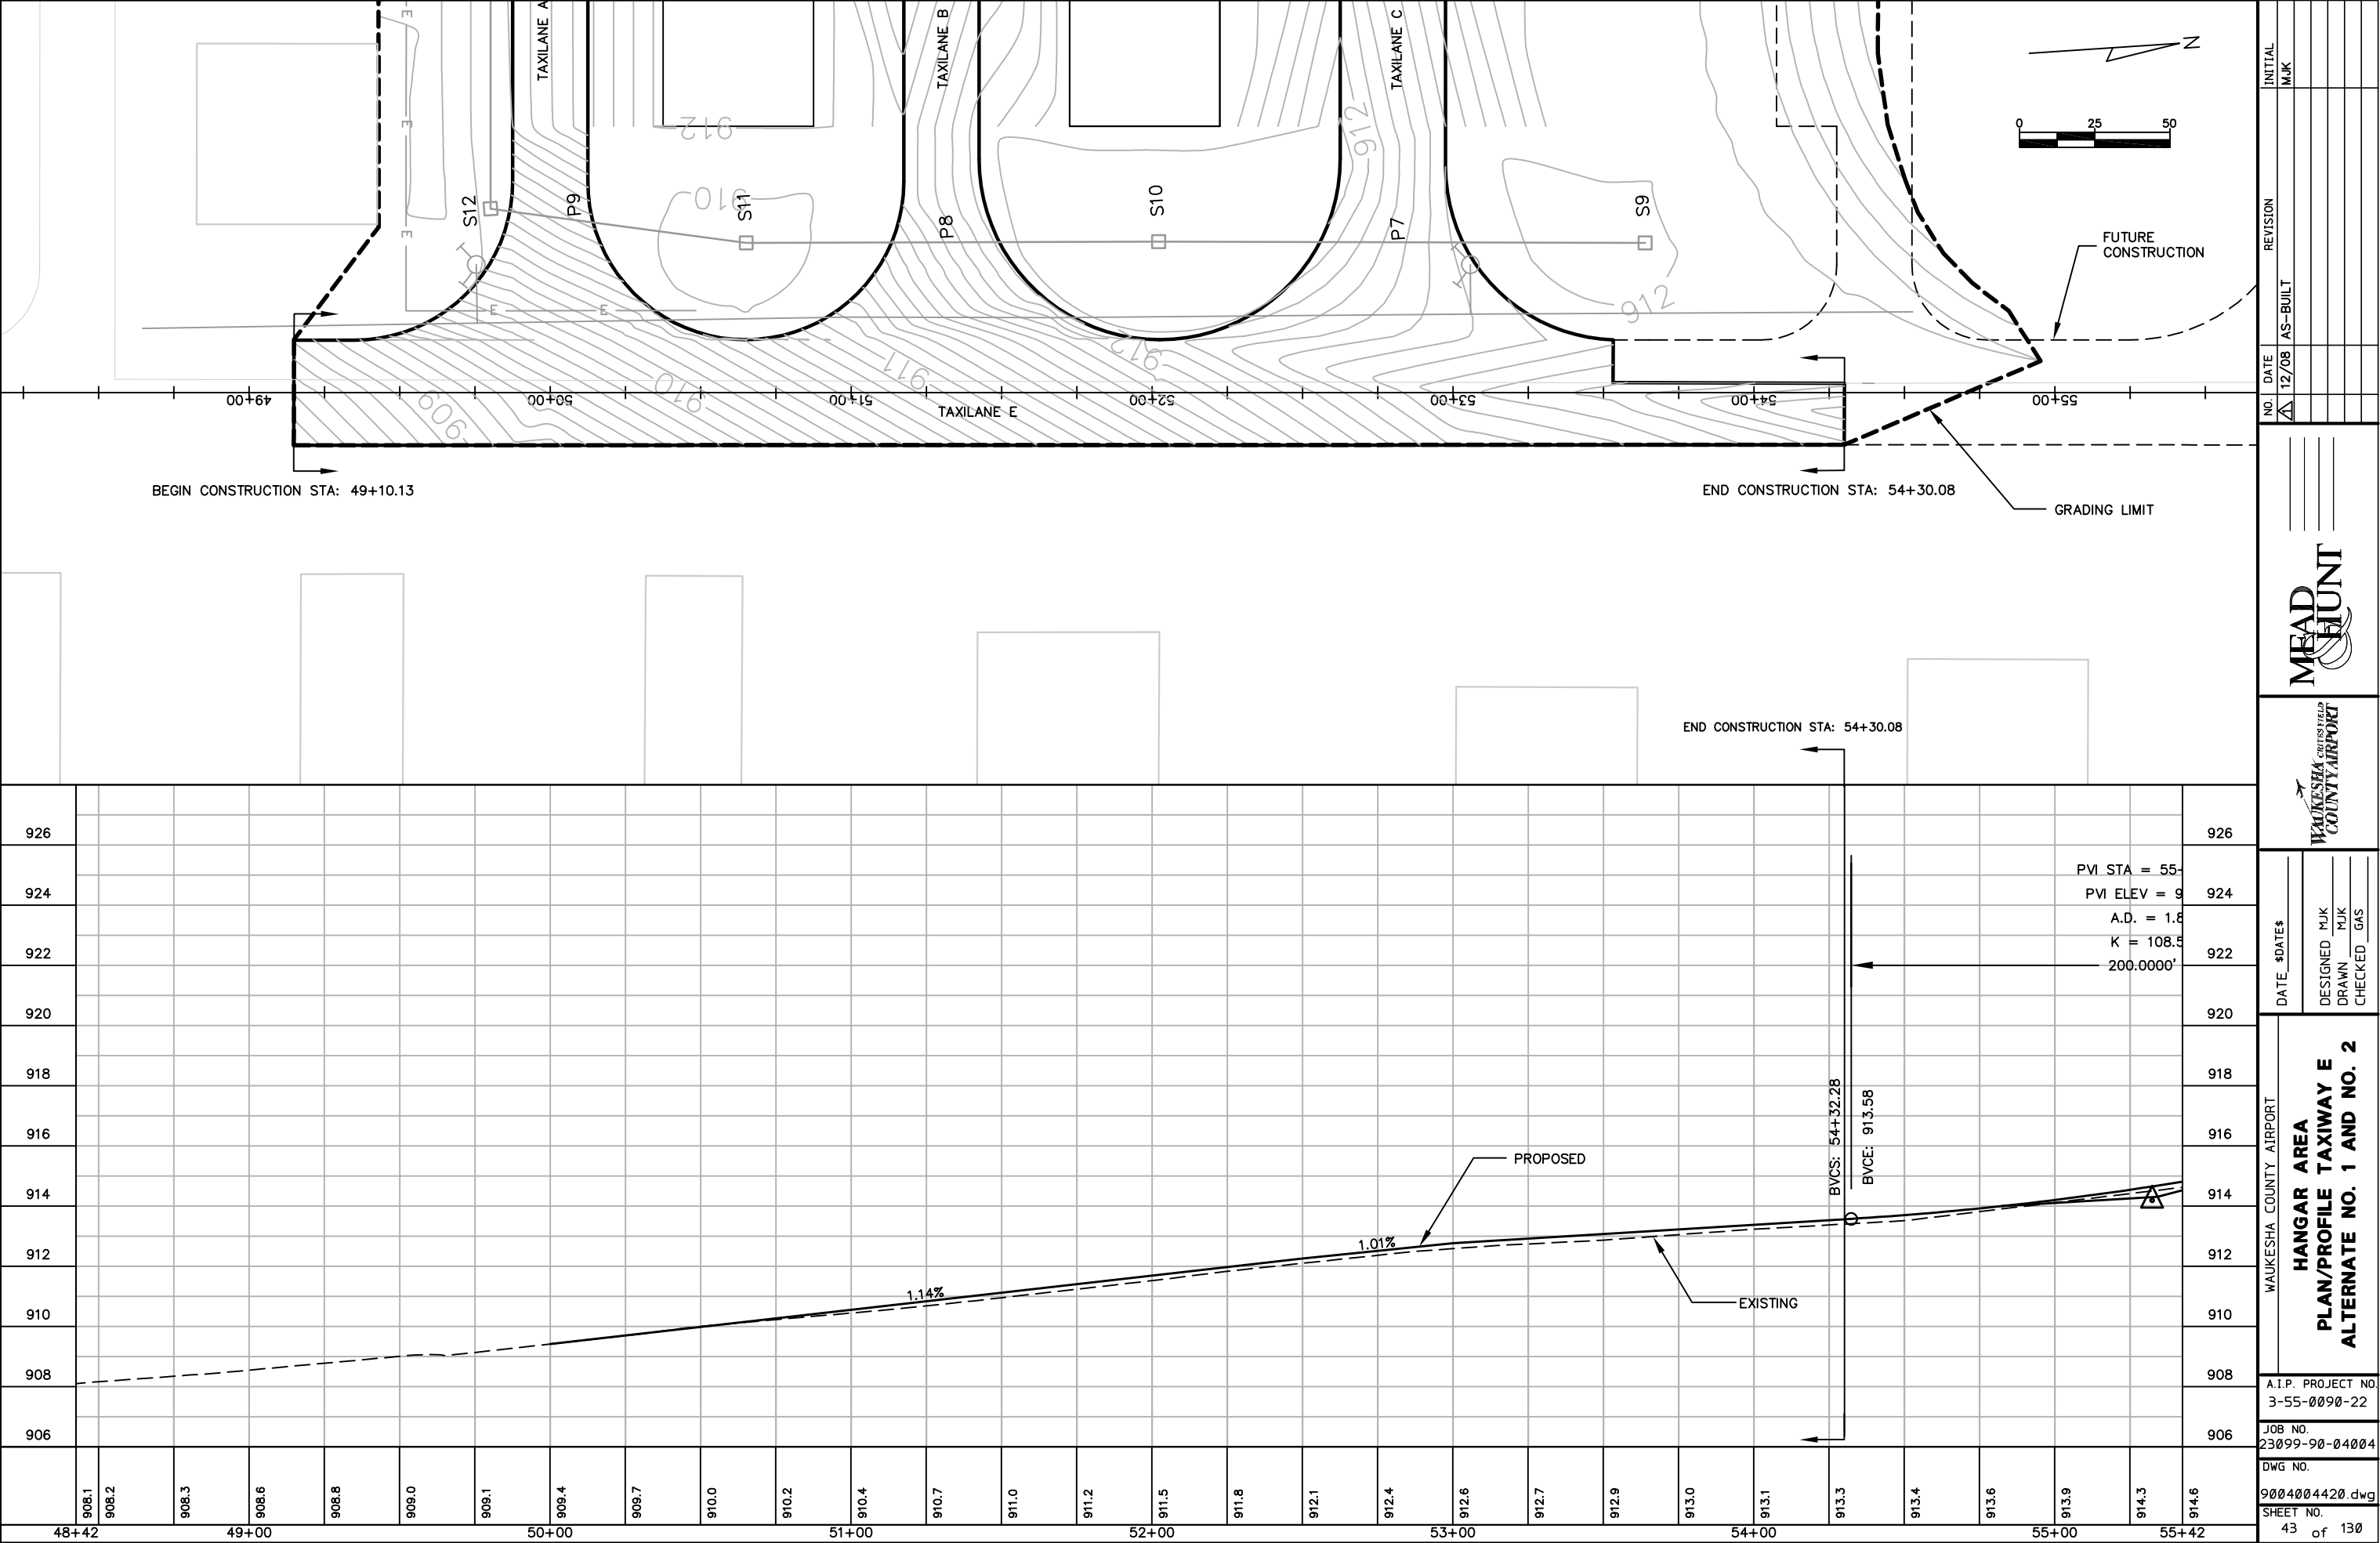

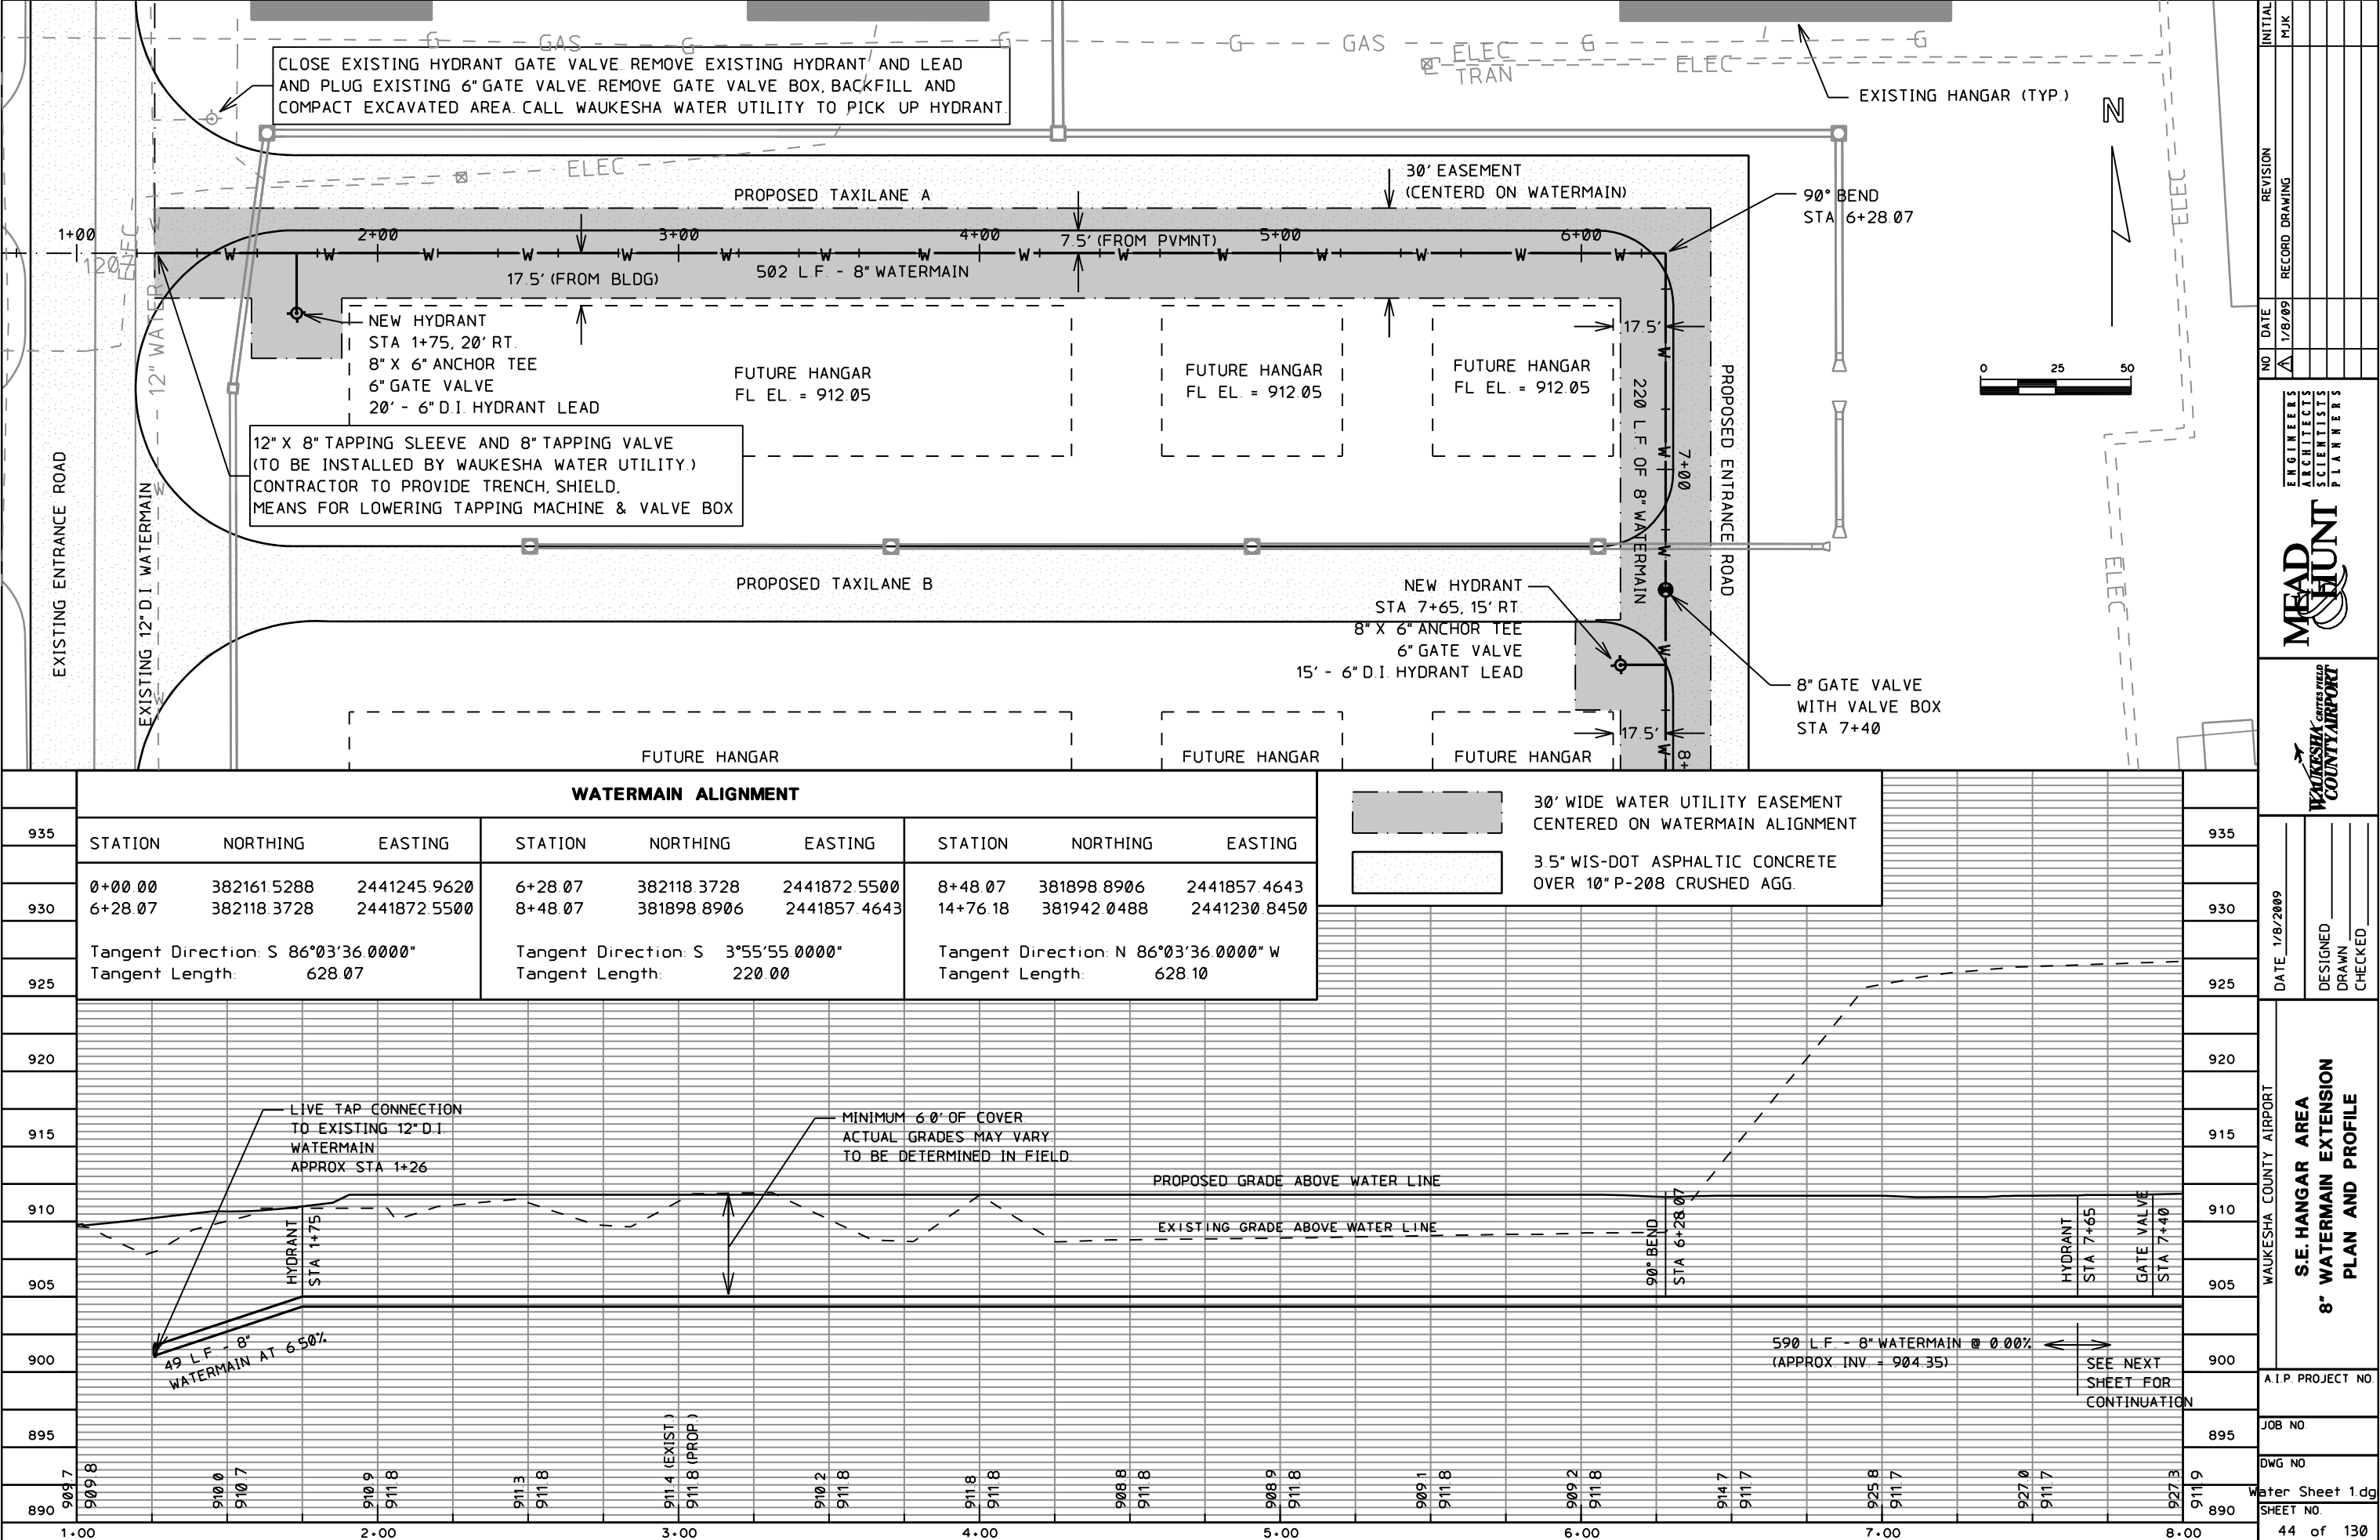

INITIAL
PJK

REVISION
RECORD DRAWING

DATE
1/8/09

NO
A

ENGINEERS
ARCHITECTS
SCIENTISTS
PLANNERS

MEAD & HUNT

WAUKESHA COUNTY AIRPORT

DATE
1/8/2009

DESIGNED
DRAWN
CHECKED

WAUKESHA COUNTY AIRPORT

S.E. HANGAR AREA

8" WATERMAIN EXTENSION

PLAN AND PROFILE

A.I.P. PROJECT NO.


JOB NO.

DWG NO.

Water Sheet 1 dg


SHEET NO.

44 of 130

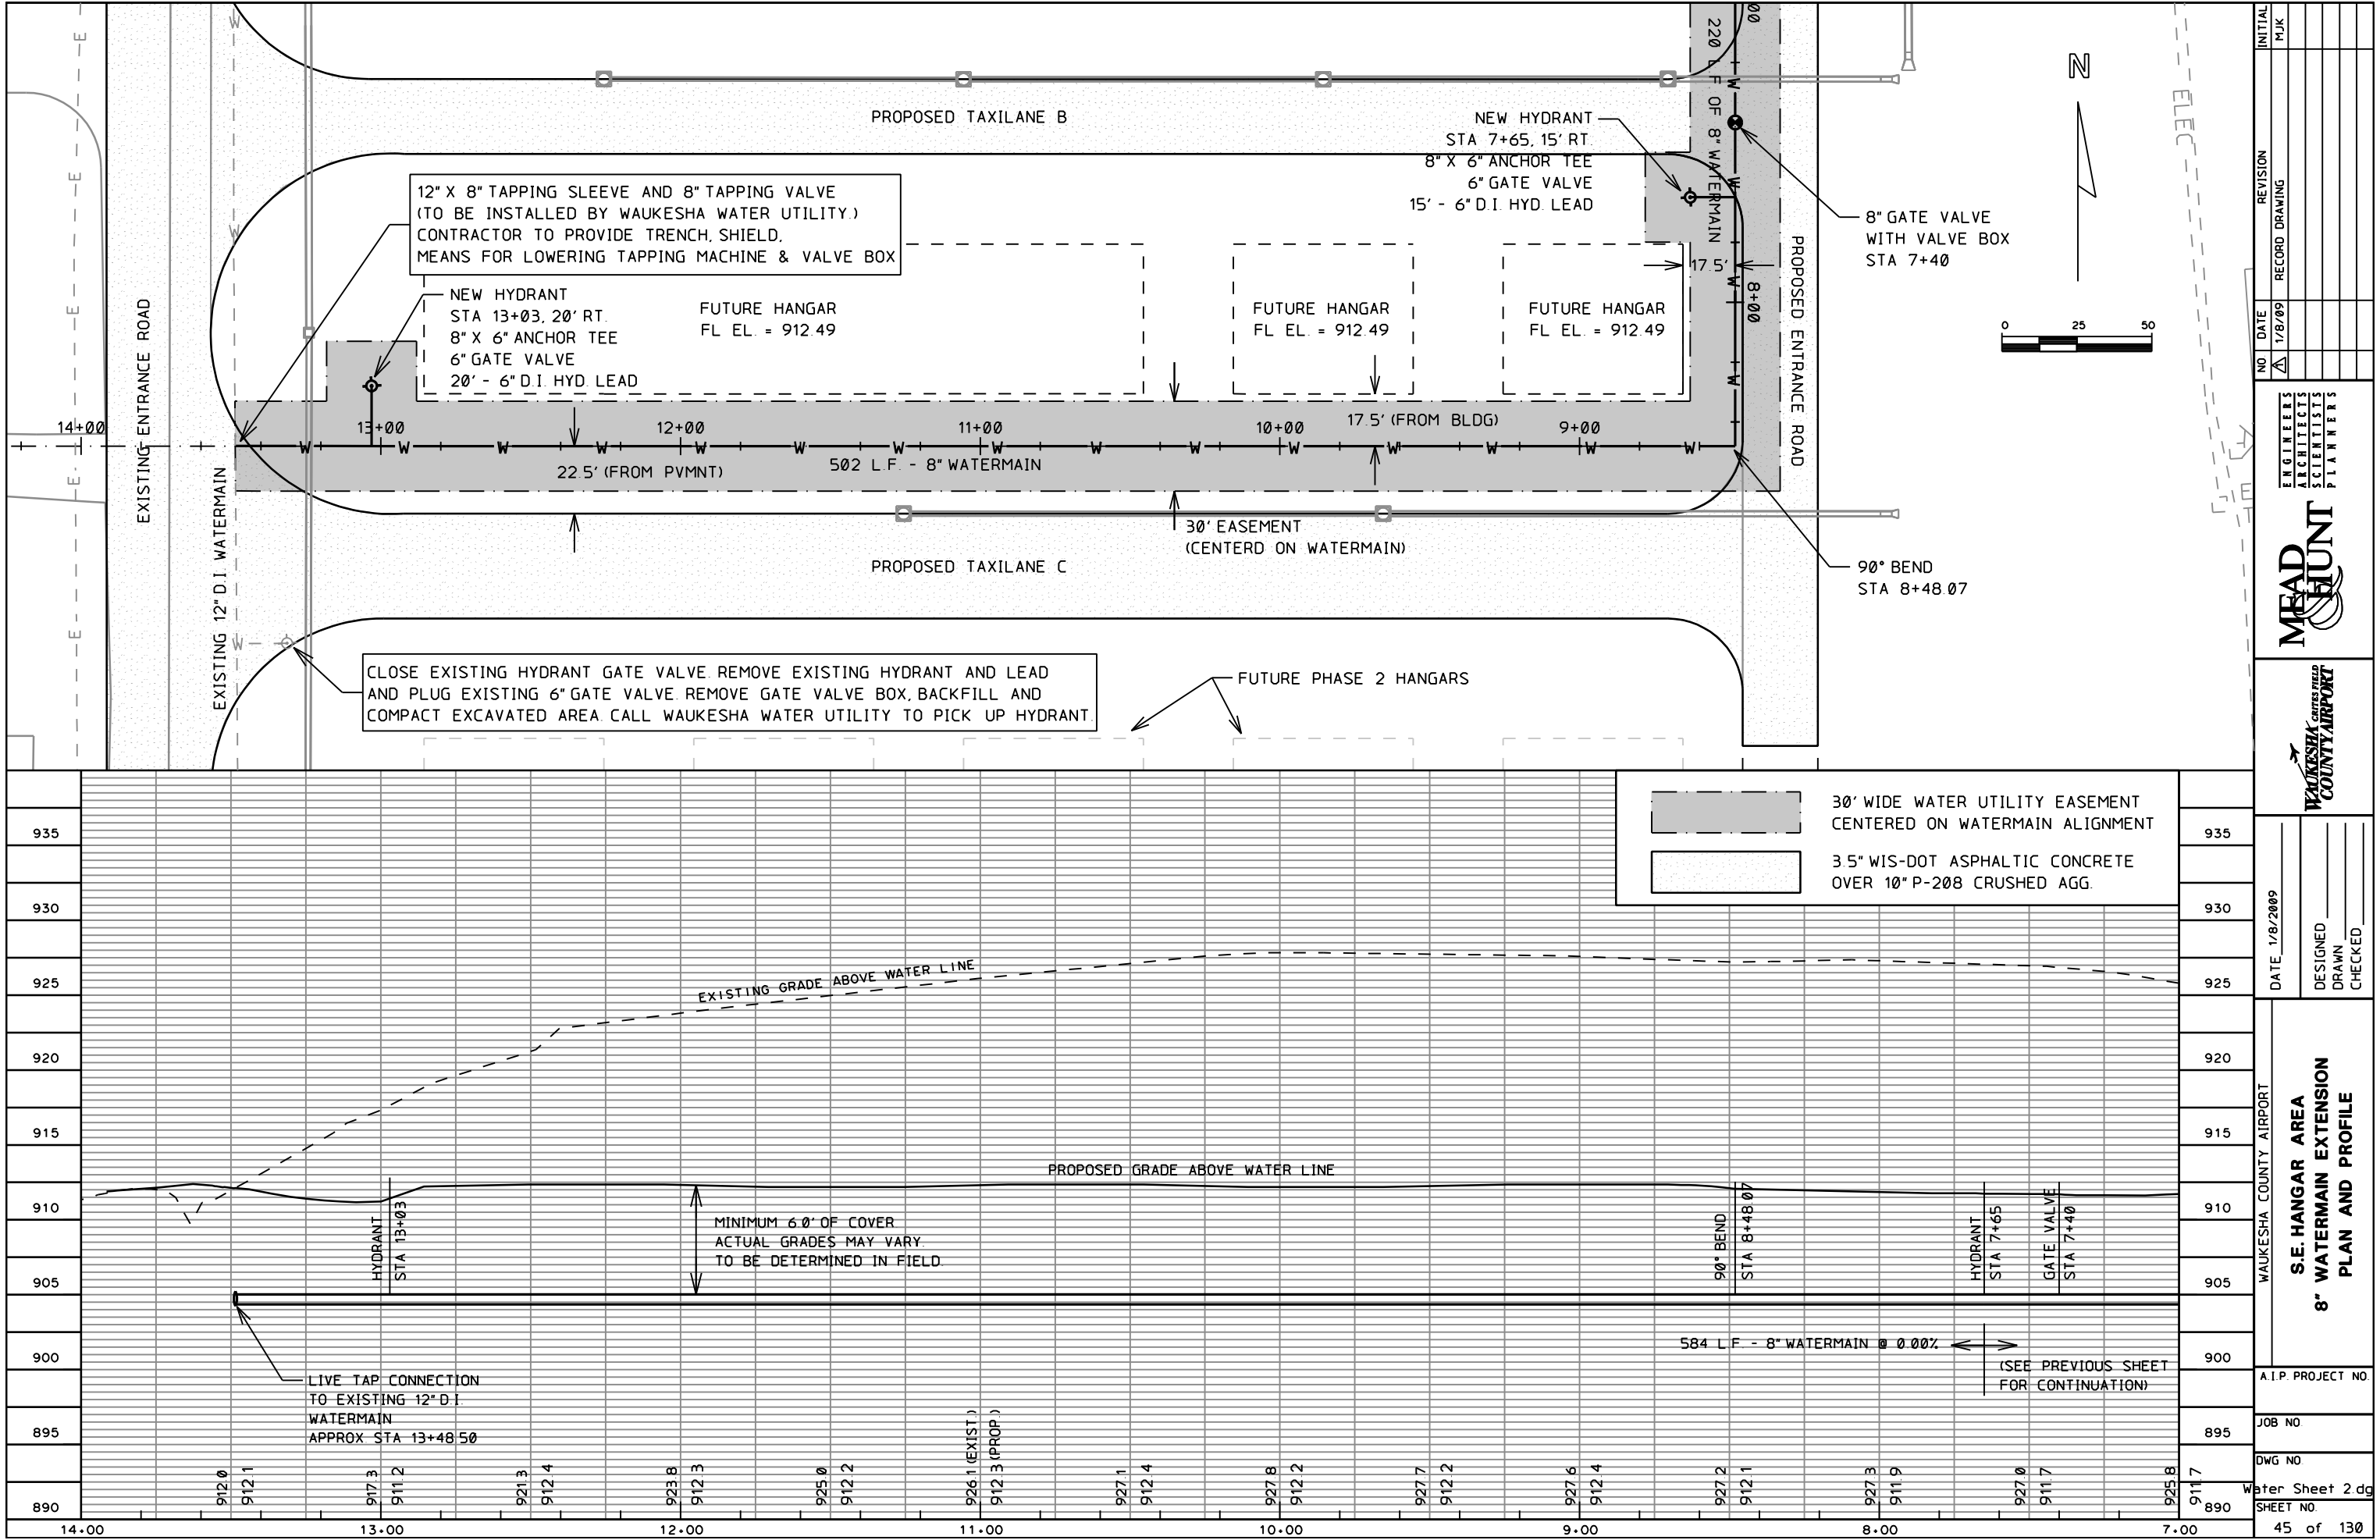


INITIAL	REVISION	DATE	NO.	DATE	NO.
MJK	RECORD DRAWING	1/8/09	1		
ENGINEERS ARCHITECTS SCIENTISTS PLANNERS					
MEAD & HUNT					
WAUKESHA COUNTY AIRPORT					
DATE 1/8/2009			DESIGNED DRAWN CHECKED		
S.E. HANGAR AREA 8" WATERMAIN EXTENSION PLAN AND PROFILE					
A.I.P. PROJECT NO.					
JOB NO.					
DWG NO.					
Water Sheet 2.dwg					
SHEET NO. 45 of 130					

X:\23099-90\06017\tech\cadd\drawings\AS-BUILTS\HANGAR AREA\23099-90-04004 Land Desktop.dwg\23099-90-04004106.dwg

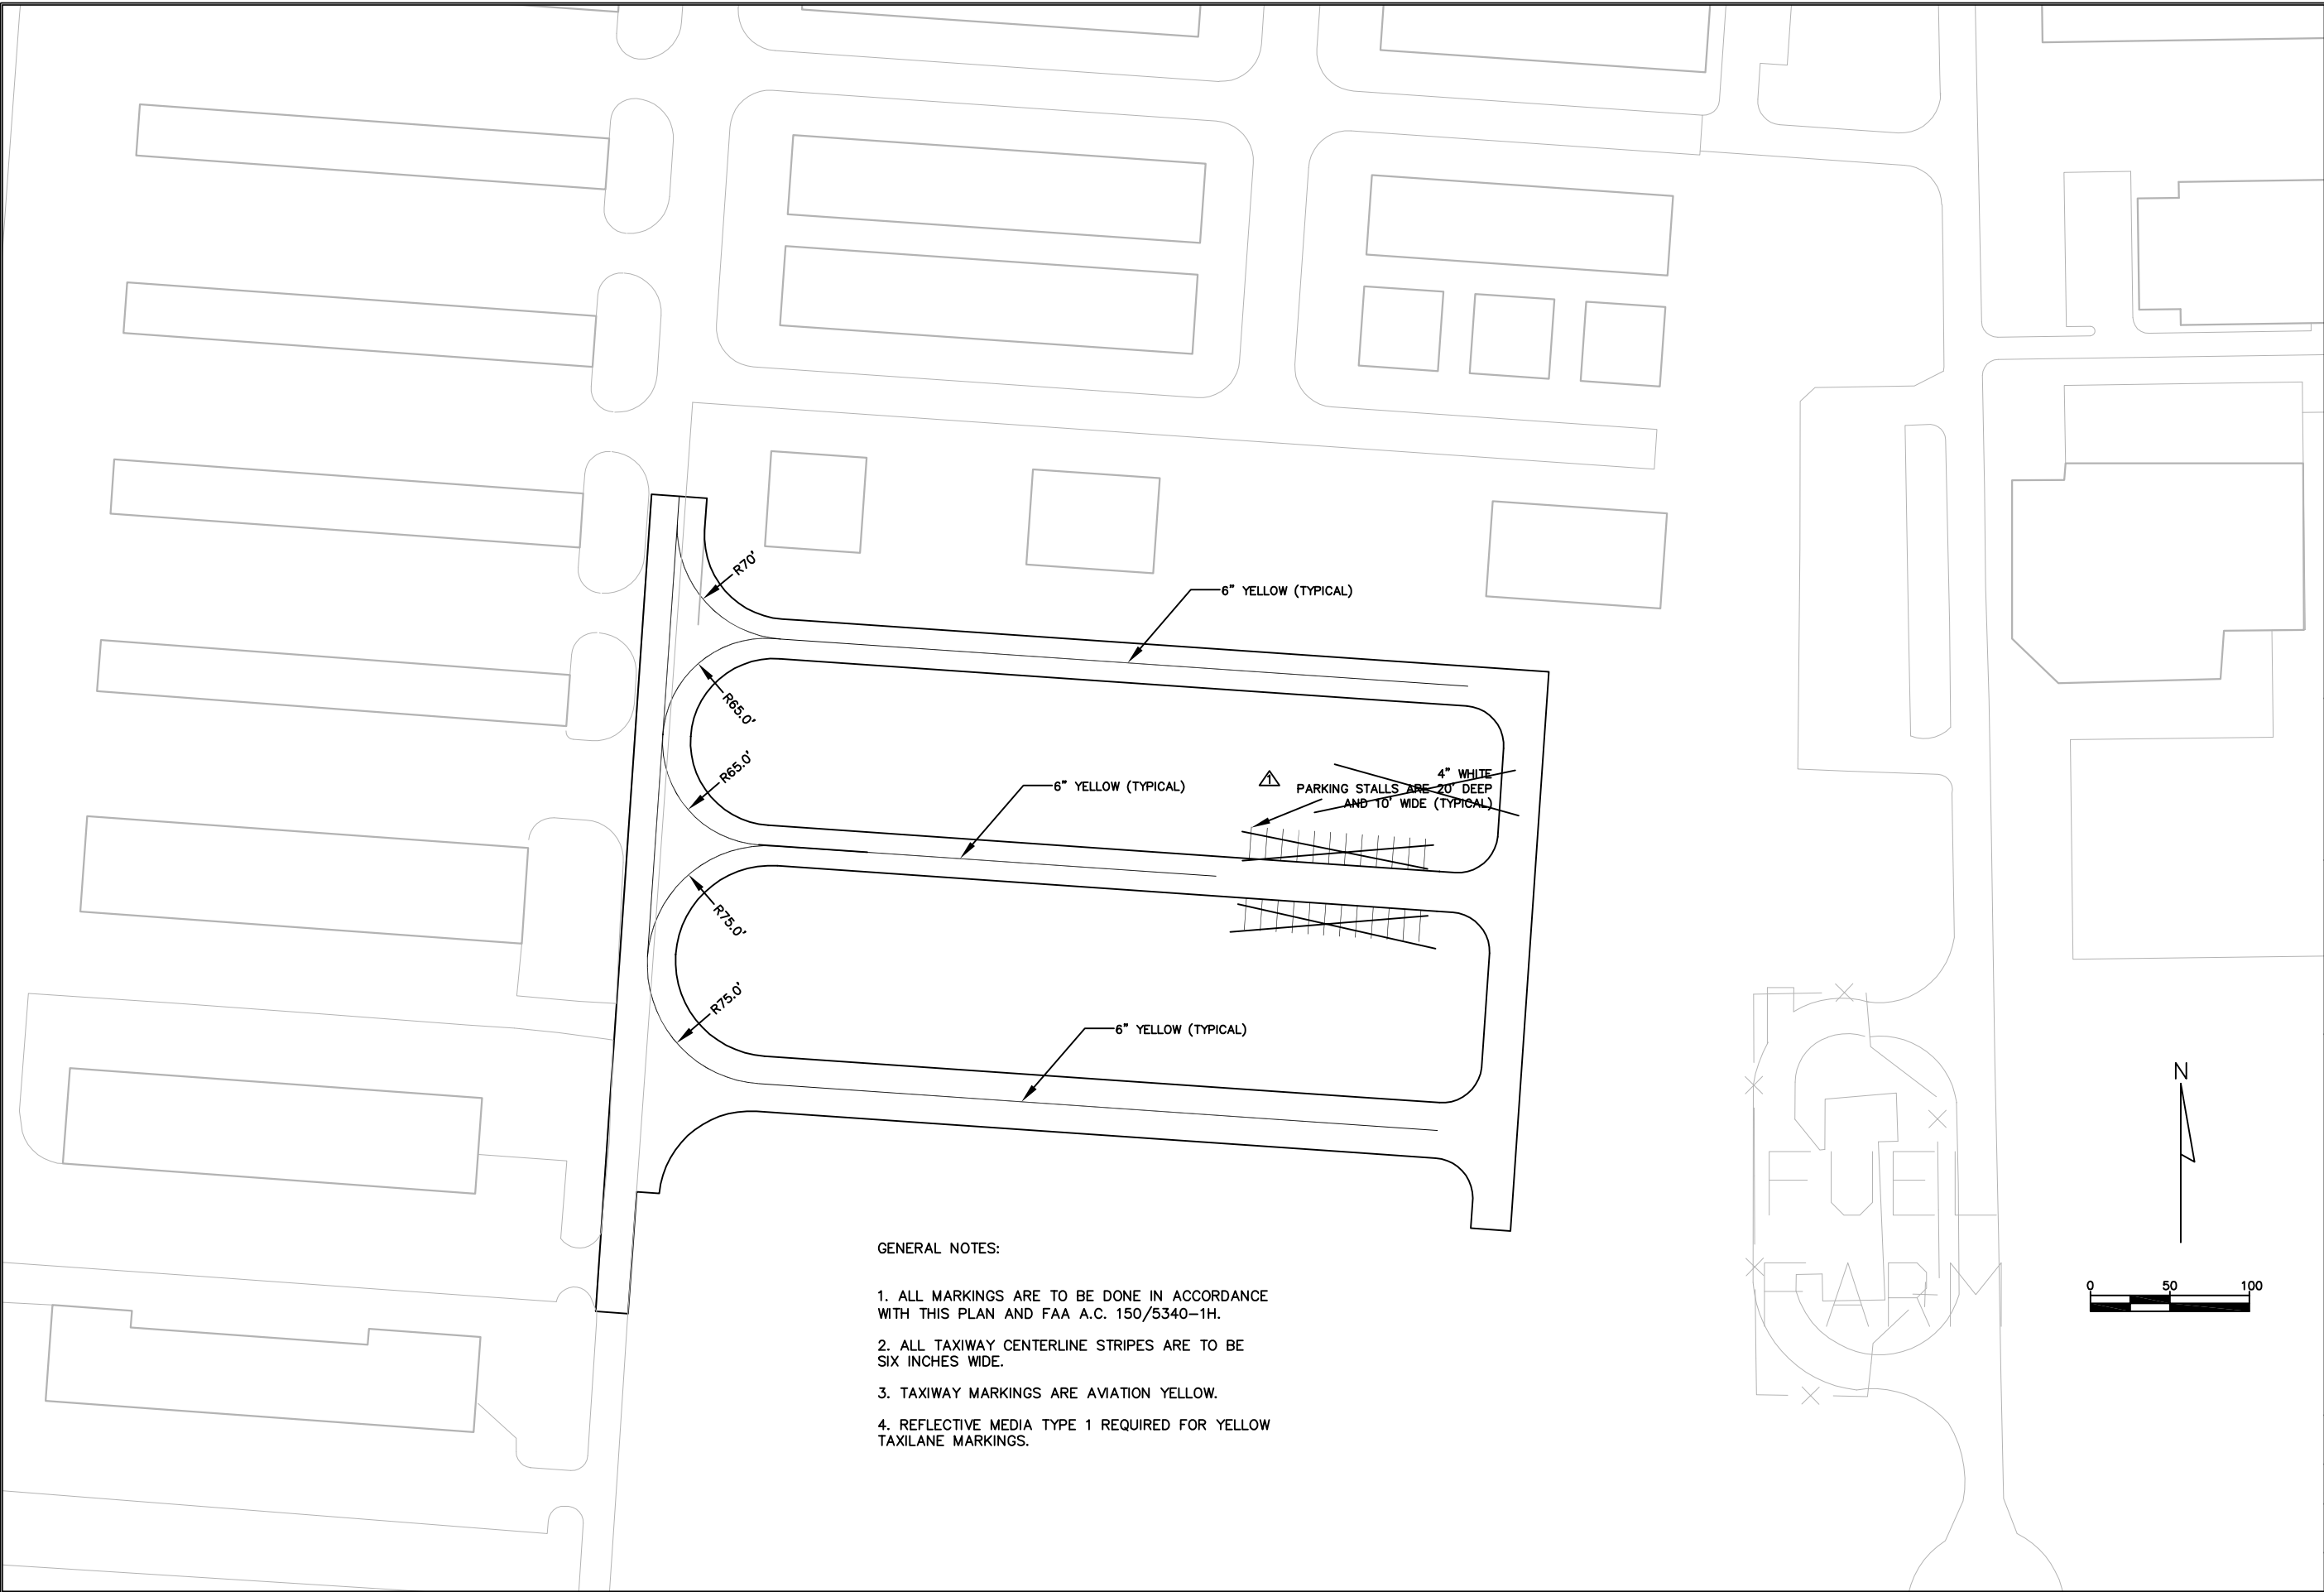


GENERAL NOTES:

1. ALL MARKINGS ARE TO BE DONE IN ACCORDANCE WITH THIS PLAN AND FAA A.C. 150/5340-1H.
2. ALL TAXIWAY CENTERLINE STRIPES ARE TO BE SIX INCHES WIDE.
3. TAXIWAY MARKINGS ARE AVIATION YELLOW.
4. REFLECTIVE MEDIA TYPE 1 REQUIRED FOR YELLOW TAXILANE MARKINGS.

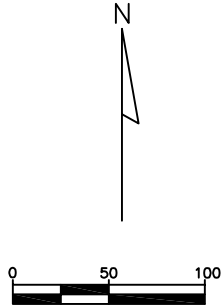

WAUKESHA COUNTY AIRPORT		DATE	\$DATE\$	MEAD & HUNT		NO.	DATE	REVISION	INITIAL
HANGAR AREA PROPOSED PAVEMENT MARKINGS ALTERNATE NO. 2		DESIGNED	MJK			A	12/08	AS BUILT	MJK
		DRAWN	MJK						
		CHECKED	GAS						
A.I.P. PROJECT NO. 3-55-0090-22		JOB NO. 23099-90-04004							
DWG NO. 9004004106.dwg									
SHEET NO. 53 of 130									


X:\23099-90\06017\tech\cadd\drawings\AS-BUILTS\HANGAR AREA\23099-90-04004 Land Desktop.dwg\23099-90-04004102.dwg

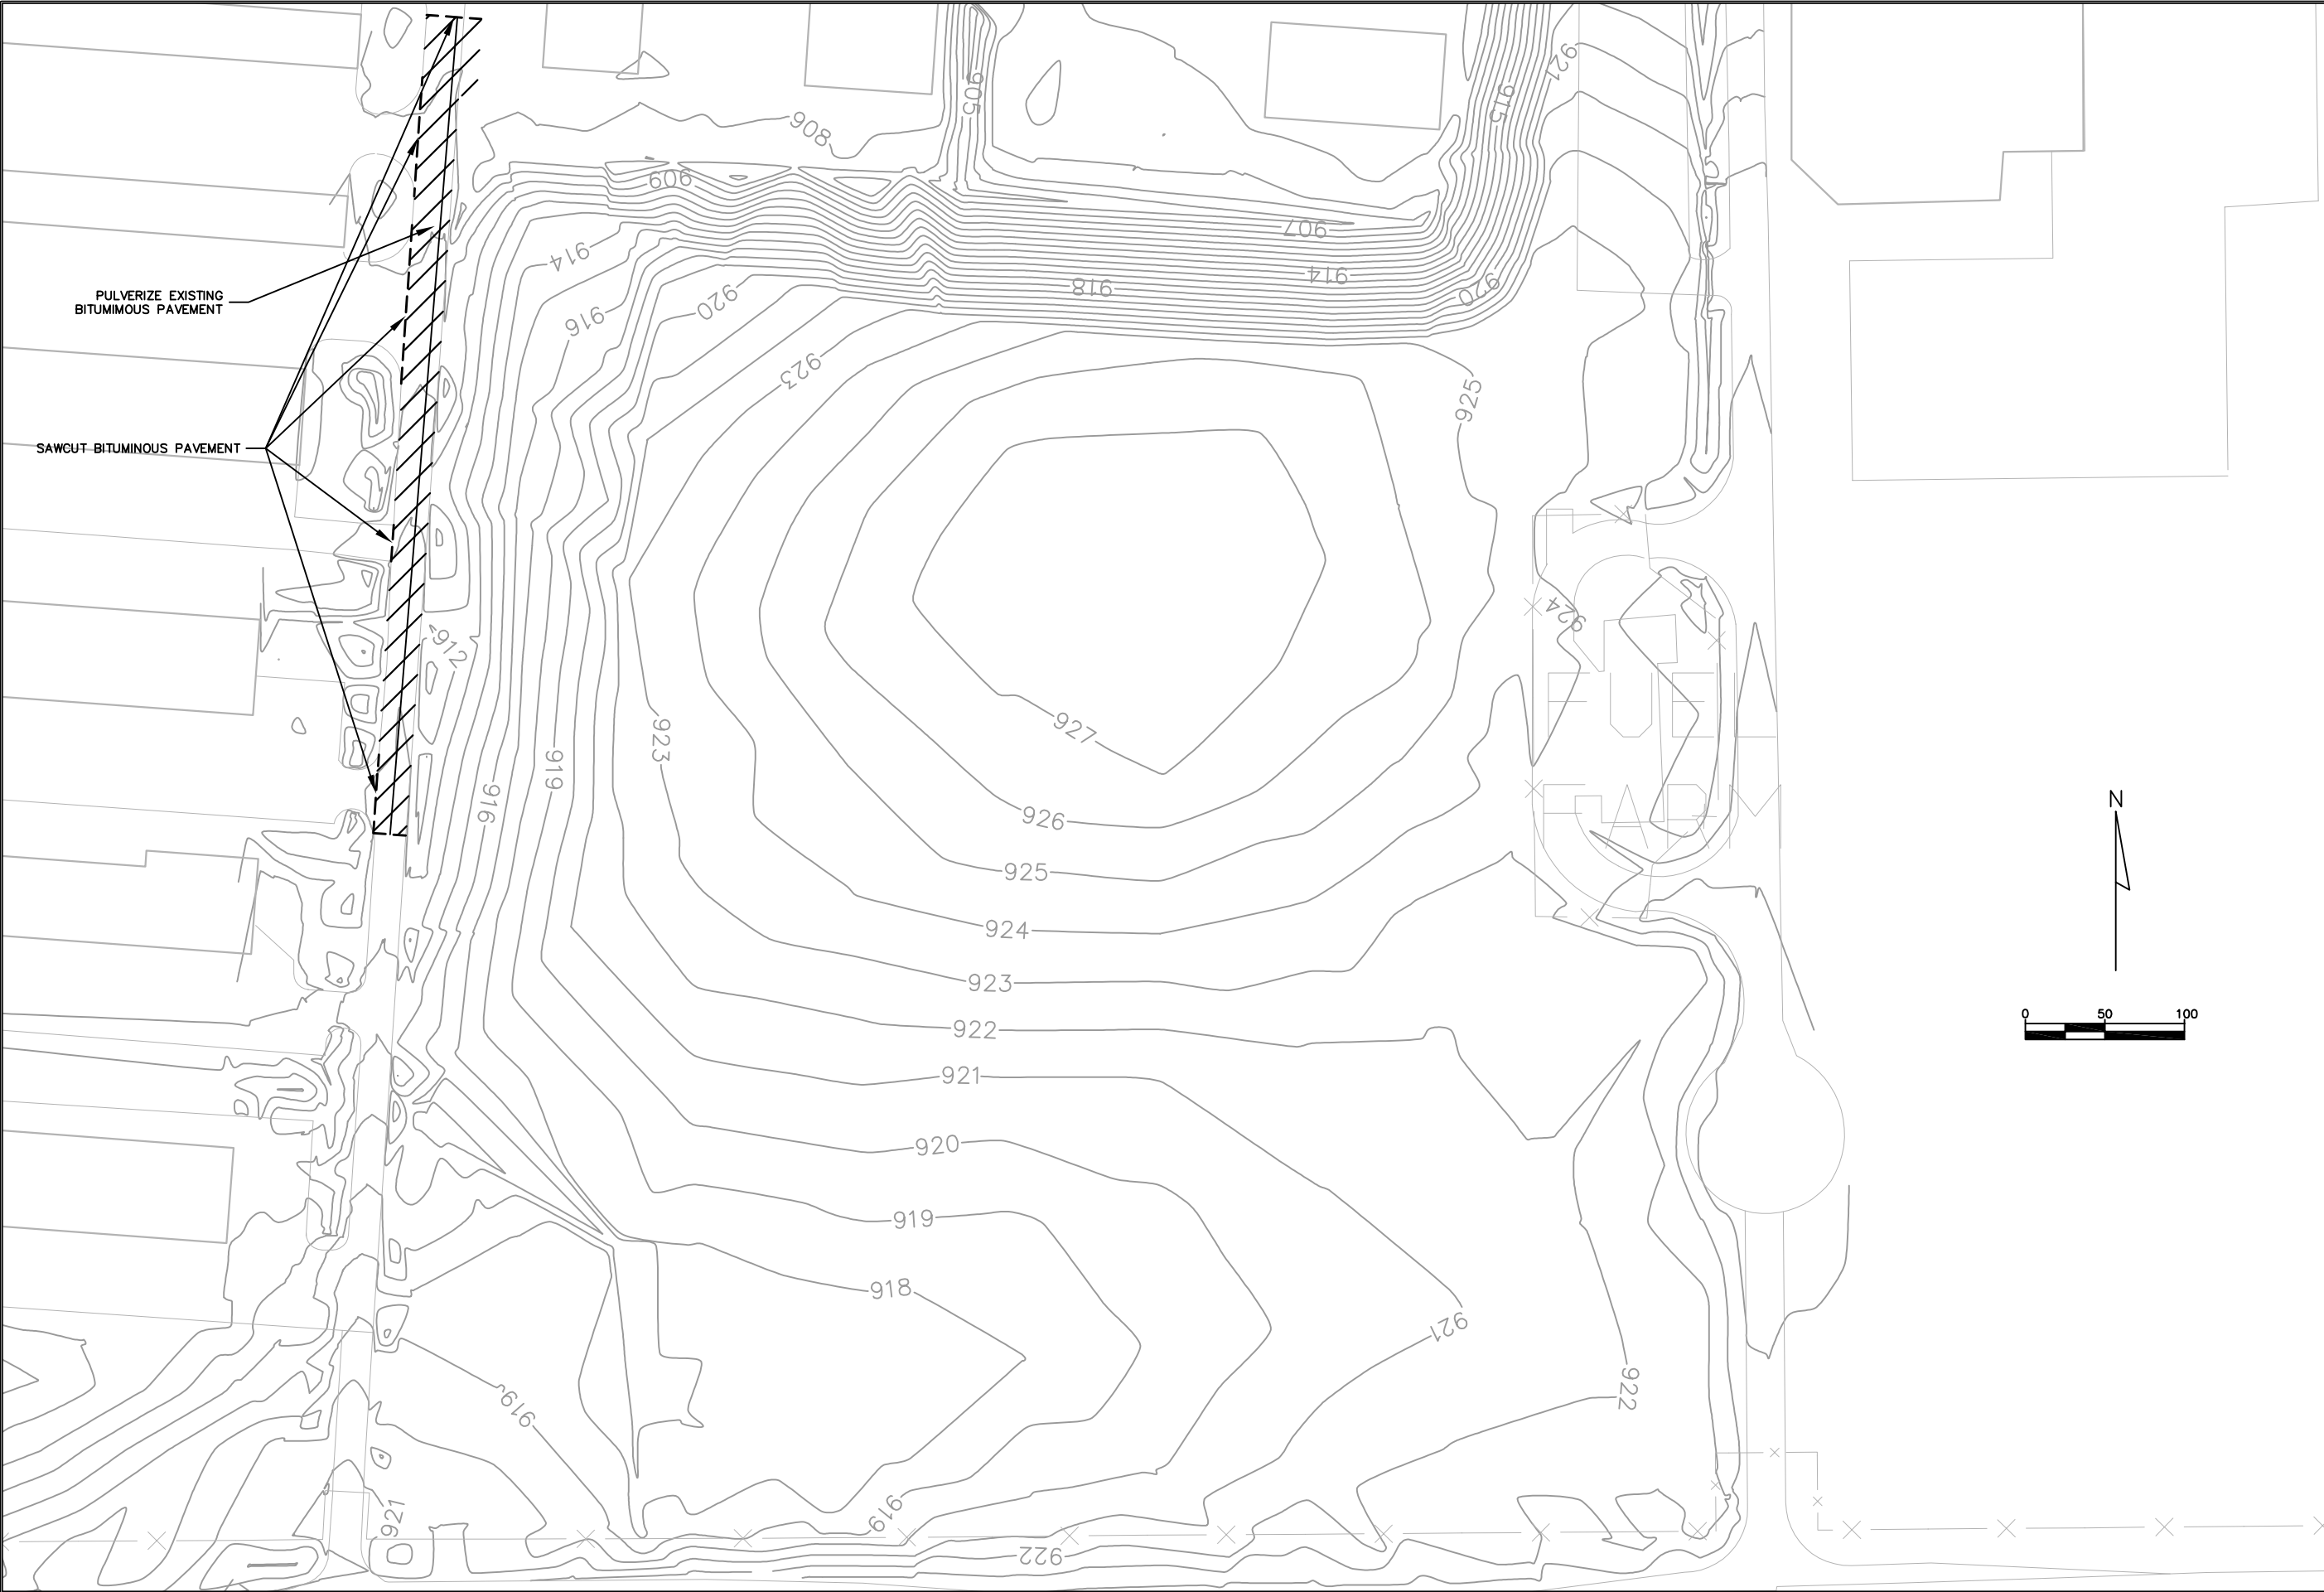

Jan 08, 2009 - 10:27pm

WAUKESHA COUNTY AIRPORT		DATE	\$DATE\$	WAUKESHA COUNTY AIRPORT		MEAD & HUNT		NO.	DATE	AS-BUILT	REVISION	INITIAL
HANGAR AREA		DESIGNED	MJK	WAUKESHA COUNTY AIRPORT				12/08				MJK
EXISTING CONTOURS & REMOVALS		DRAWN	MJK									
A.I.P. PROJECT NO.		CHECKED	GAS									
3-55-0090-22												
JOB NO.												
23099-90-04004												
DWG NO.												
9004004102.dwg												
SHEET NO.												
83 of 130												





x:\23099-90\06017\tech\cadd\drawings\AS-BUILTS\HANGAR AREA\23099-90-04004 Land Desktop.dwg\23099-90-04004103.dwg

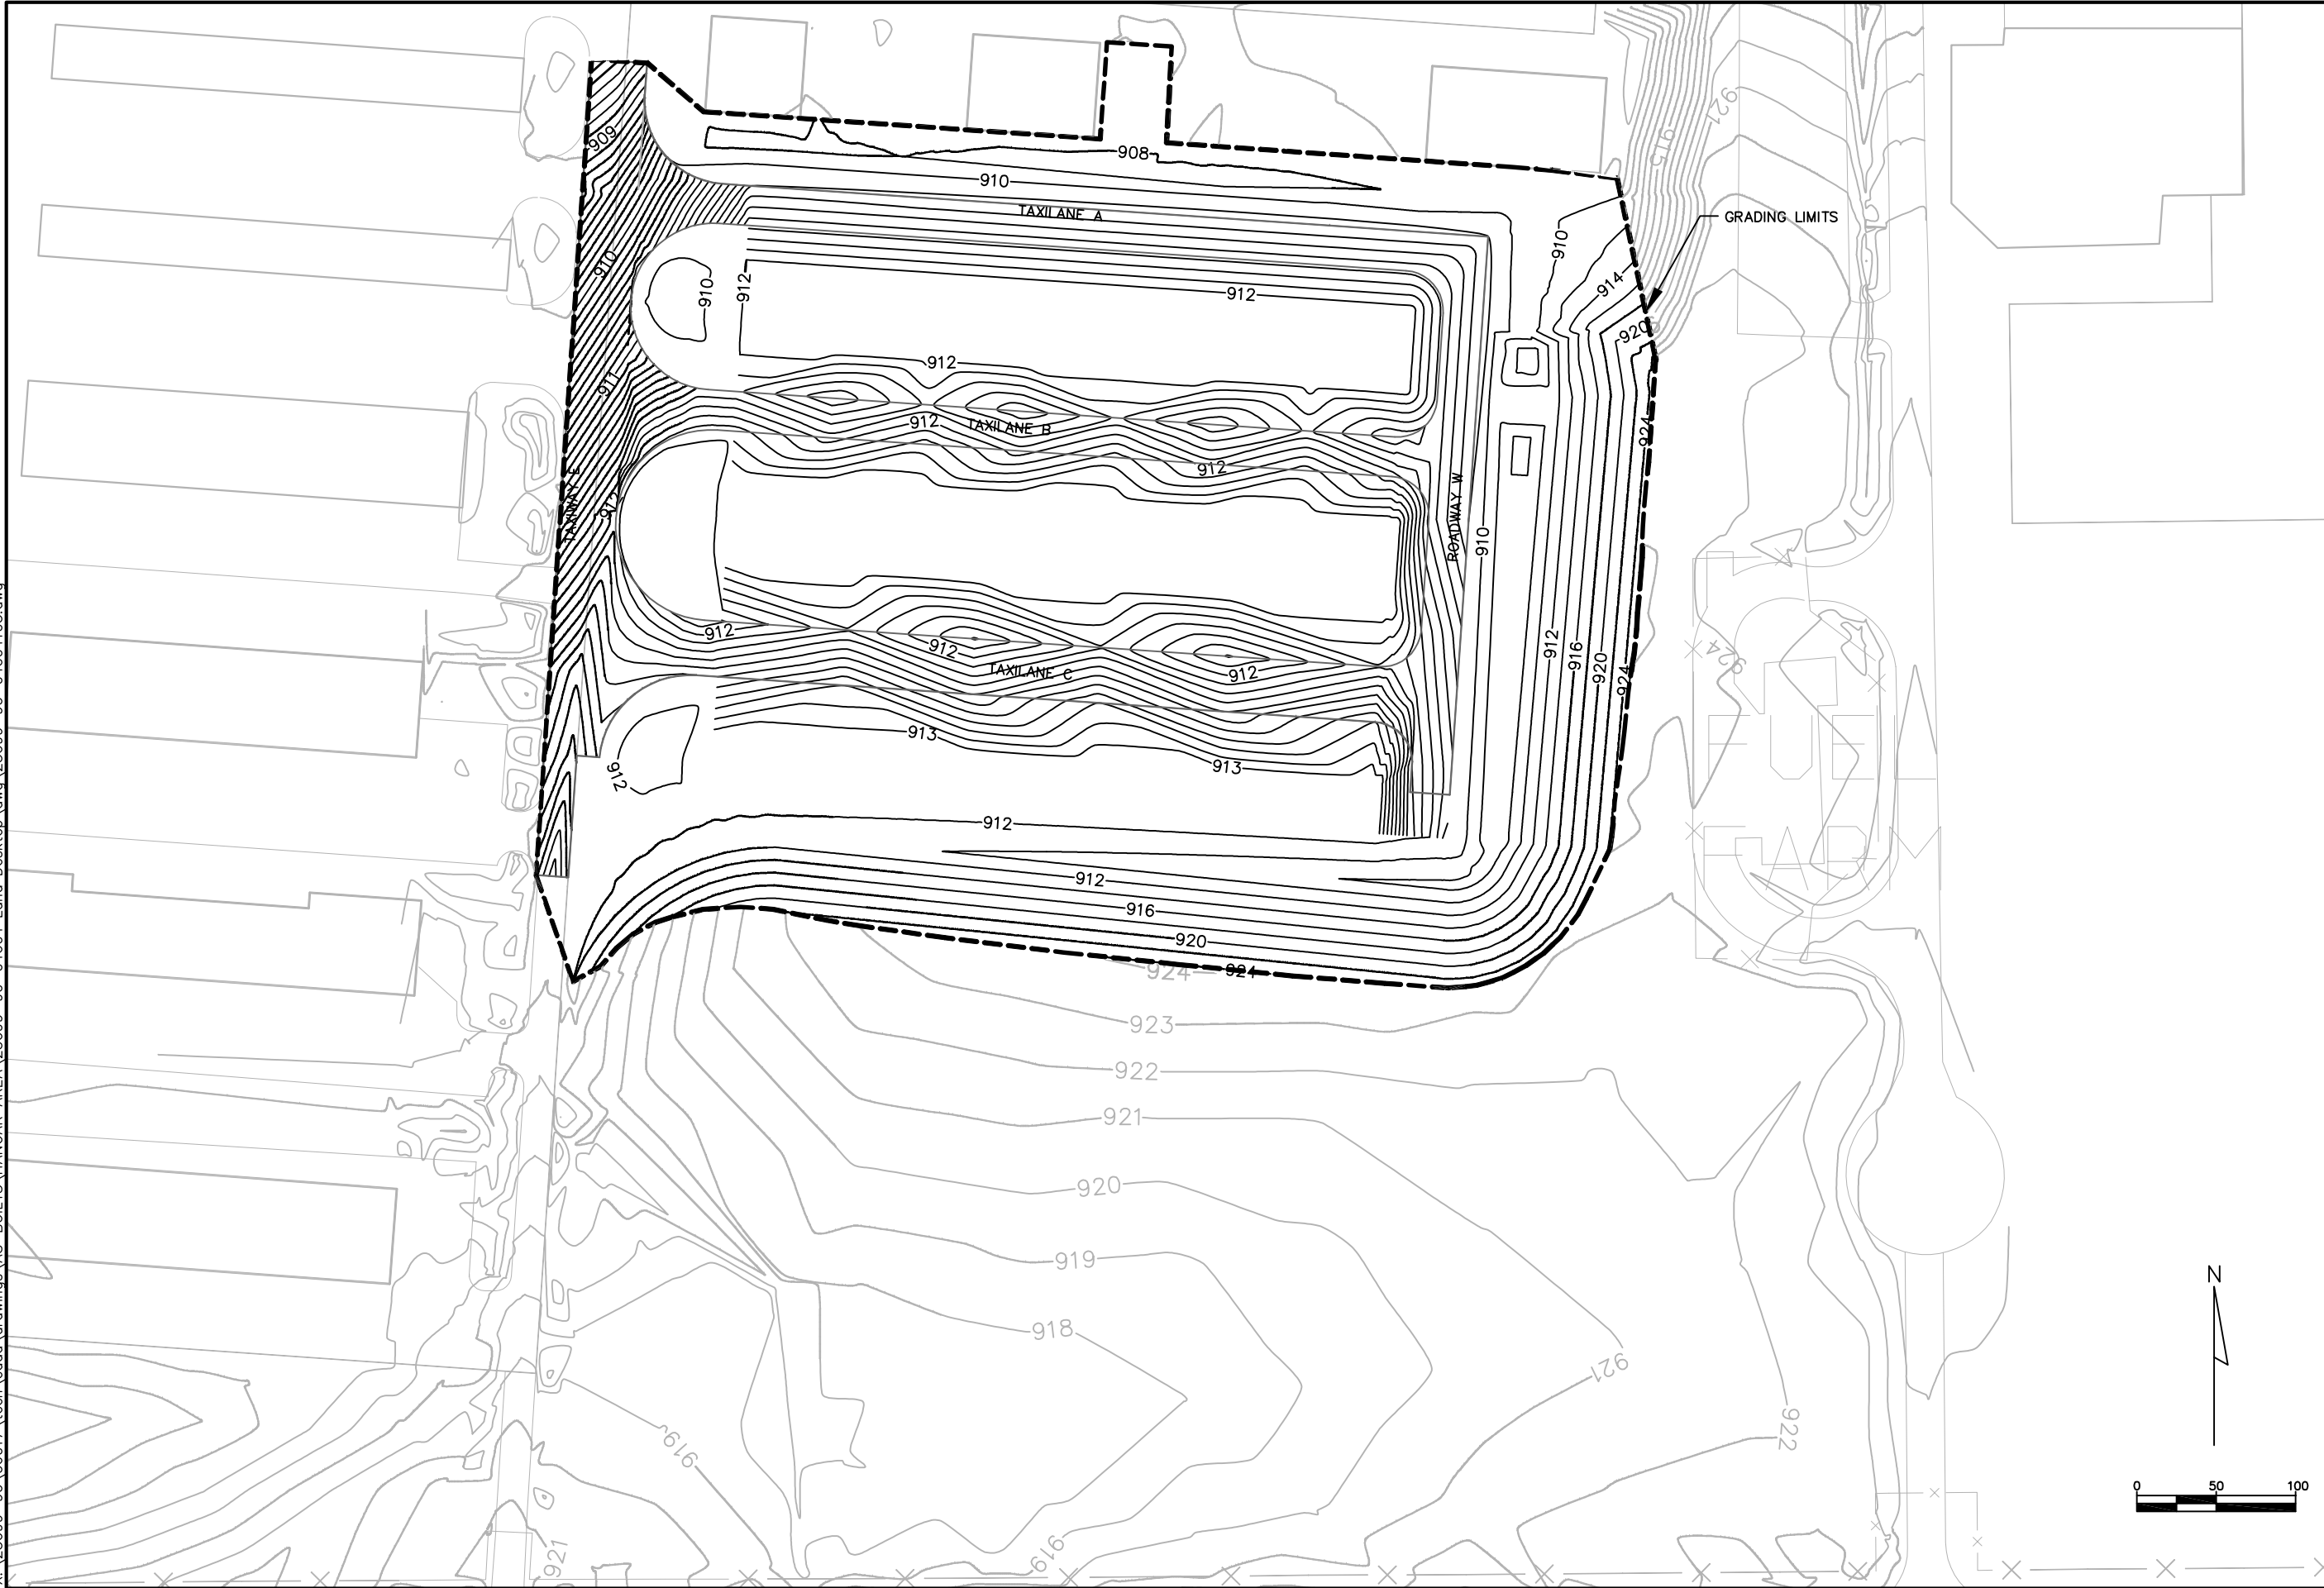

Jan 08, 2009 - 10:29pm

WAUKESHA COUNTY AIRPORT		DATE \$DATE\$		WAUKESHA COUNTY AIRPORT		MEAD & HUNT		NO. DATE AS-BUILT		REVISION		INITIAL	
HANGAR AREA		DESIGNED MJK		WAUKESHA COUNTY AIRPORT									
PROPOSED CONTOURS		DRAWN MJK											
ALTERNATE NO. 1		CHECKED GAS											
A.I.P. PROJECT NO													
3-55-0090-22													
JOB NO.													
23099-90-04004													
DWG NO.													
9004004103.dwg													
SHEET NO.													
84													
of													
129													




x:\23099-90\06017\tech\cadd\drawings\AS-BUILTS\HANGAR AREA\23099-90-04004 Land Desktop\dwg\23099-90-04004108.dwg

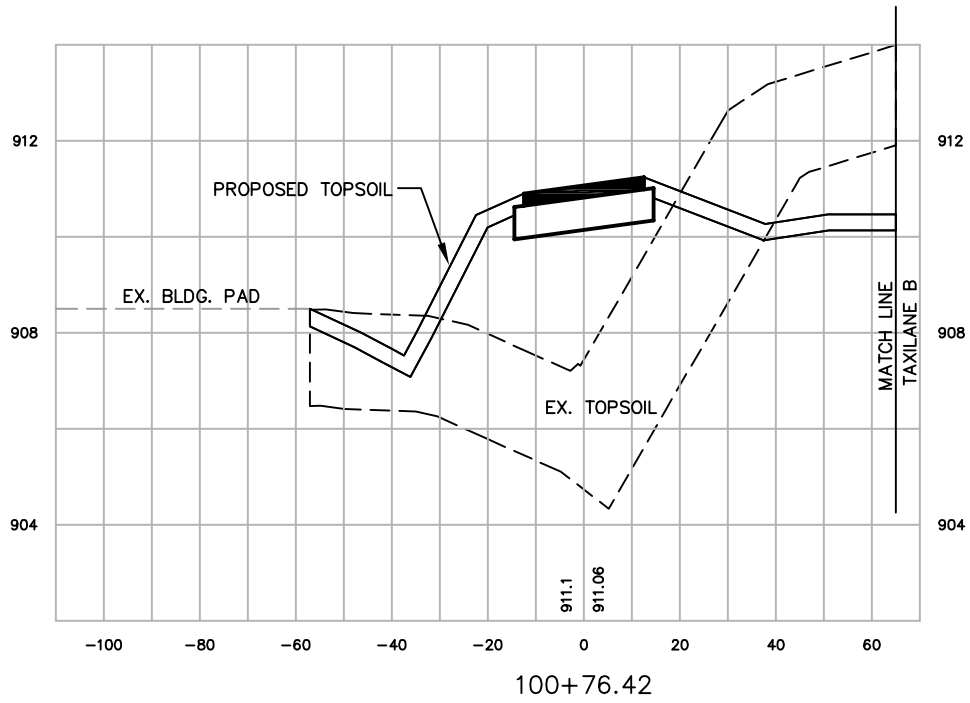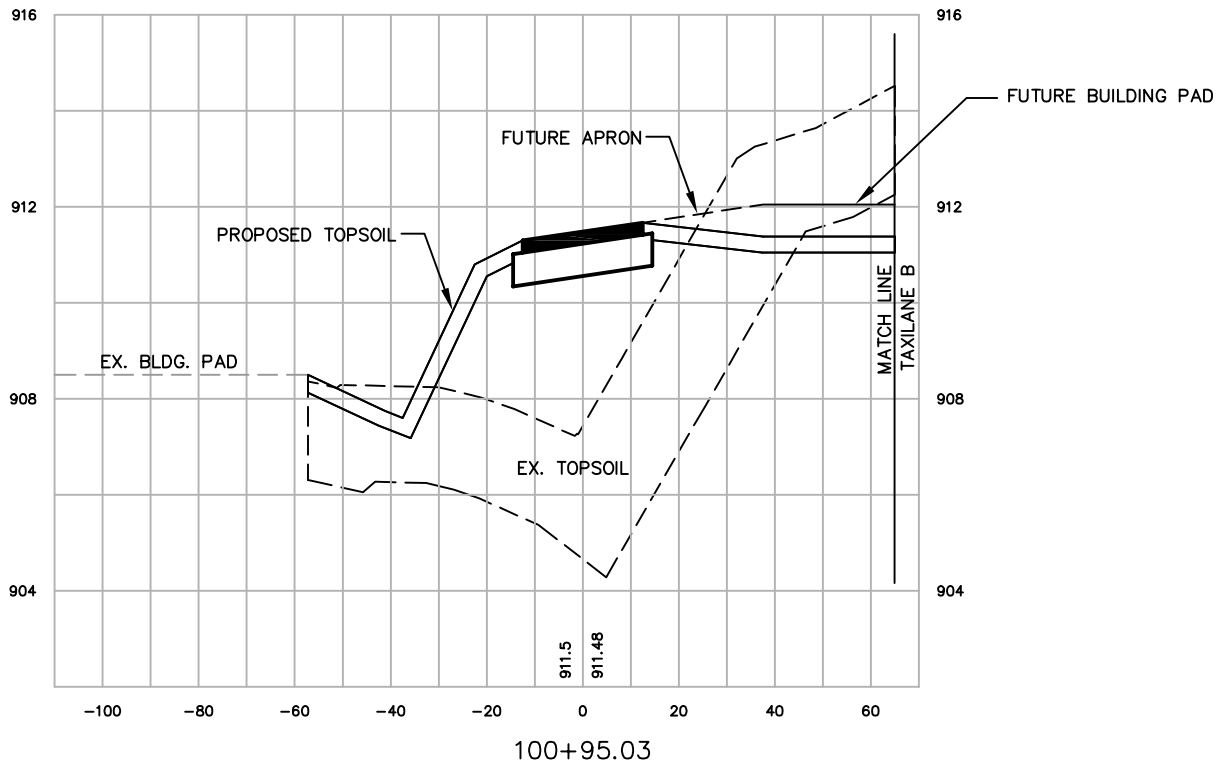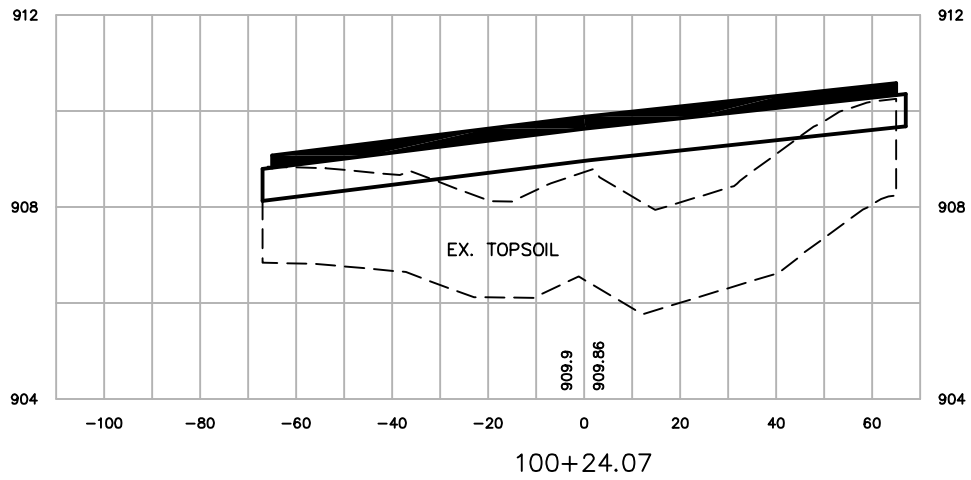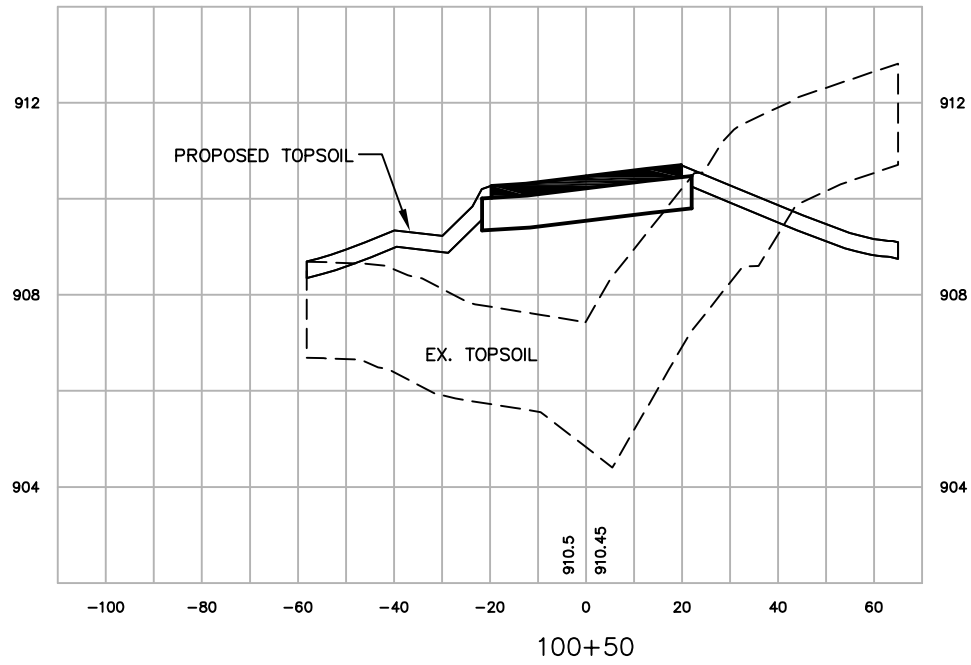

SCALE:
VERT. 1"=4'
HORIZ. 1"=40'

Waukesha County Airport		DATE	\$DATE\$	DESIGNED	MJK	DATE	\$DATE\$	NO.	DATE	AS-BUILT	REVISION	INITIAL
HANGAR AREA		DATE	\$DATE\$	DESIGNED	MJK	DATE	\$DATE\$	NO.	DATE	AS-BUILT	REVISION	INITIAL
CROSS SECTIONS		DATE	\$DATE\$	DESIGNED	MJK	DATE	\$DATE\$	NO.	DATE	AS-BUILT	REVISION	INITIAL
TAXILANE A		DATE	\$DATE\$	DESIGNED	MJK	DATE	\$DATE\$	NO.	DATE	AS-BUILT	REVISION	INITIAL
A.I.P. PROJECT NO.		DATE	\$DATE\$	DESIGNED	MJK	DATE	\$DATE\$	NO.	DATE	AS-BUILT	REVISION	INITIAL
3-55-0090-22		DATE	\$DATE\$	DESIGNED	MJK	DATE	\$DATE\$	NO.	DATE	AS-BUILT	REVISION	INITIAL
JOB NO.		DATE	\$DATE\$	DESIGNED	MJK	DATE	\$DATE\$	NO.	DATE	AS-BUILT	REVISION	INITIAL
23099-90-04004		DATE	\$DATE\$	DESIGNED	MJK	DATE	\$DATE\$	NO.	DATE	AS-BUILT	REVISION	INITIAL
DWG NO.		DATE	\$DATE\$	DESIGNED	MJK	DATE	\$DATE\$	NO.	DATE	AS-BUILT	REVISION	INITIAL
9004004108.dwg		DATE	\$DATE\$	DESIGNED	MJK	DATE	\$DATE\$	NO.	DATE	AS-BUILT	REVISION	INITIAL
SHEET NO.		DATE	\$DATE\$	DESIGNED	MJK	DATE	\$DATE\$	NO.	DATE	AS-BUILT	REVISION	INITIAL
85 of 130		DATE	\$DATE\$	DESIGNED	MJK	DATE	\$DATE\$	NO.	DATE	AS-BUILT	REVISION	INITIAL



x:\23099-90\06017\tech\cadd\drawings\AS-BUILTS\HANGAR AREA\23099-90-04004 Land Desktop\dwg\23099-90-04004108.dwg

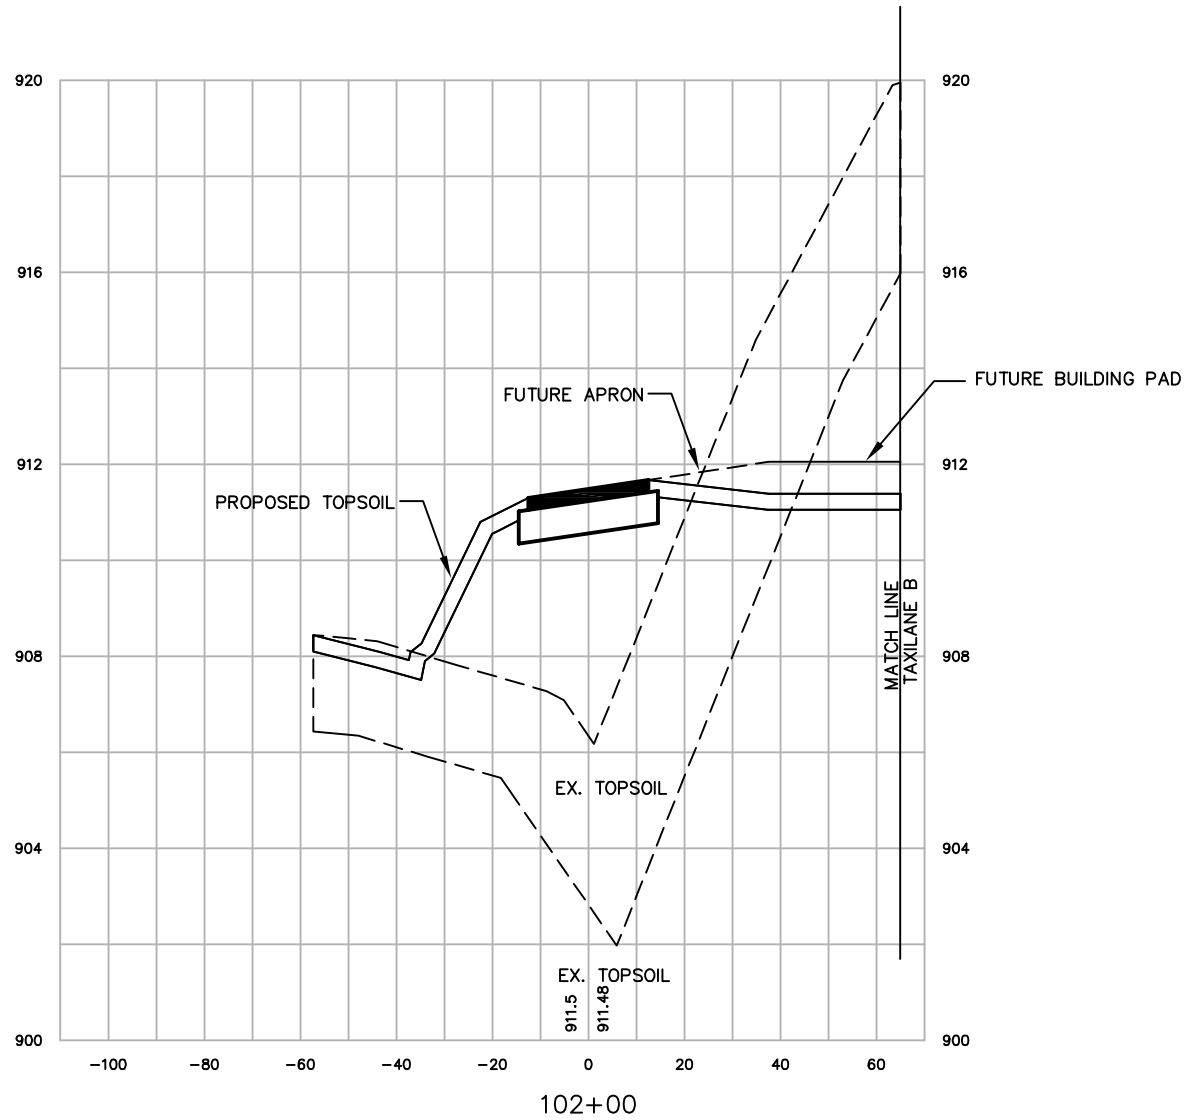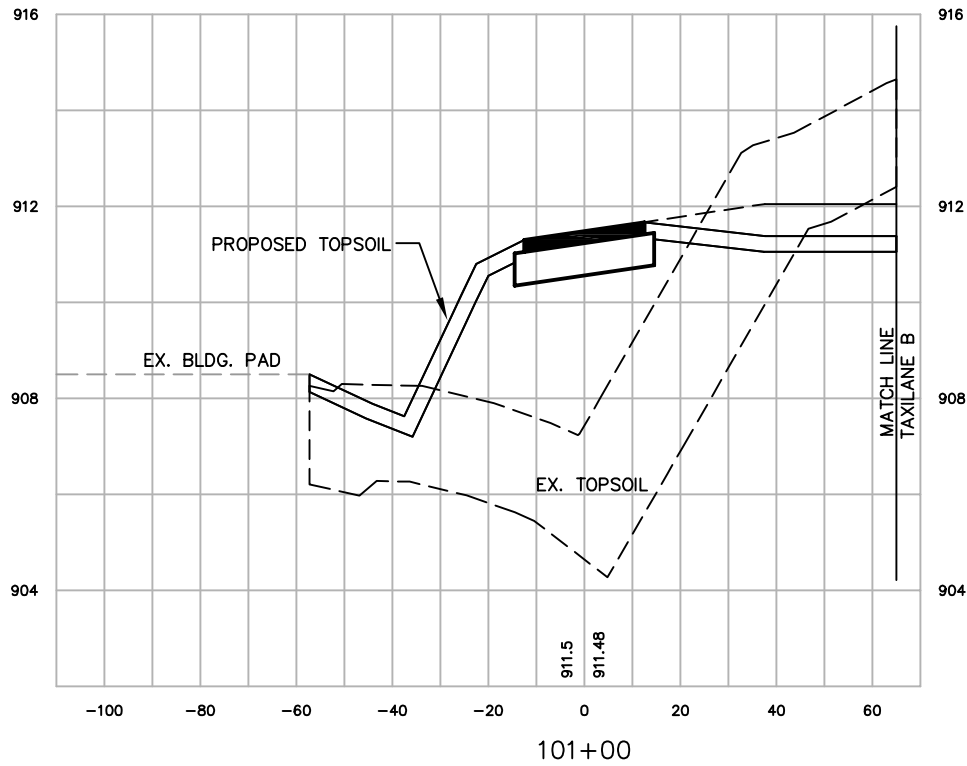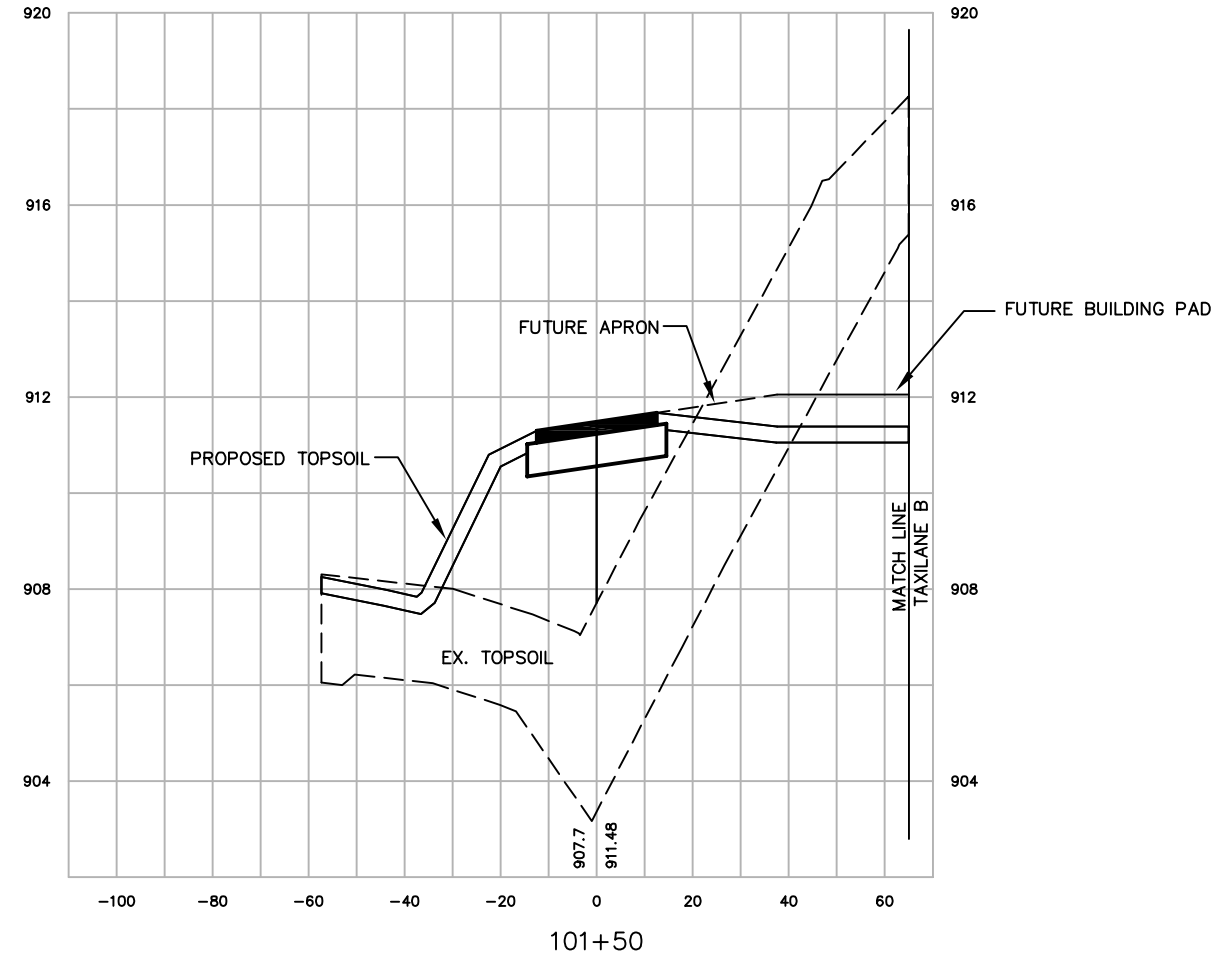

SCALE:
VERT. 1"=4'
HORIZ. 1"=40'

WAUKESHA COUNTY AIRPORT										DATE \$DATE\$		DESIGNED MJK		DRAWN MJK		CHECKED GAS						NO. 		DATE 12/08		AS-BUILT		REVISION		INITIAL																																																																																																																																																																																																																																																																																																																																																																																																																																																																																																																																																																																																																																																																																																																																																																																																																																																																																																																																																																																																																																																																																																																																																																																																																																																																																																																																																																																																																																																																																																																																																																																																																																																																																																																																																																																																																																																																																																																																																																																																																																																																																																																																																																																																																																																																																																																																																																																																																																																																																																																																																																																																																																																																																																																																																																																																																																																																																																																																																																																																																																																																																																																																																																																																																																																																																																																																																																																																																																																																																																																																																																																																																																																																																																																																																																																																																																																																																																																																																																																																																																																																																																																																																																																																																																																																																																																																																																																																																																																																																																																																																																																																																																																																																																																																																																																																																																																																																																																																																																																																																																																																																																																																																																																																																																																																																																																																																																																																																																																																																					
HANGAR AREA CROSS SECTIONS TAXILANE A																																MJK																																																																																																																																																																																																																																																																																																																																																																																																																																																																																																																																																																																																																																																																																																																																																																																																																																																																																																																																																																																																																																																																																																																																																																																																																																																																																																																																																																																																																																																																																																																																																																																																																																																																																																																																																																																																																																																																																																																																																																																																																																																																																																																																																																																																																																																																																																																																																																																																																																																																																																																																																																																																																																																																																																																																																																																																																																																																																																																																																																																																																																																																																																																																																																																																																																																																																																																																																																																																																																																																																																																																																																																																																																																																																																																																																																																																																																																																																																																																																																																																																																																																																																																																																																																																																																																																																																																																																																																																																																																																																																																																																																																																																																																																																																																																																																																																																																																																																																																																																																																																																																																																																																																																																																																																																																																																																																																																																																																																																																																																																			
A.I.P. PROJECT NO 3-55-0090-22										JOB NO. 23099-90-04004										DWG NO. 9004004108.dwg										SHEET NO. 86 of 130																																																																																																																																																																																																																																																																																																																																																																																																																																																																																																																																																																																																																																																																																																																																																																																																																																																																																																																																																																																																																																																																																																																																																																																																																																																																																																																																																																																																																																																																																																																																																																																																																																																																																																																																																																																																																																																																																																																																																																																																																																																																																																																																																																																																																																																																																																																																																																																																																																																																																																																																																																																																																																																																																																																																																																																																																																																																																																																																																																																																																																																																																																																																																																																																																																																																																																																																																																																																																																																																																																																																																																																																																																																																																																																																																																																																																																																																																																																																																																																																																																																																																																																																																																																																																																																																																																																																																																																																																																																																																																																																																																																																																																																																																																																																																																																																																																																																																																																																																																																																																																																																																																																																																																																																																																																																																																																																																																																																																																																																																					

X:\23099-90\06017\tech\cadd\drawings\AS-BUILT\HANGAR AREA\23099-90-04004 Land Desktop\dwg\23099-90-04004108.dwg

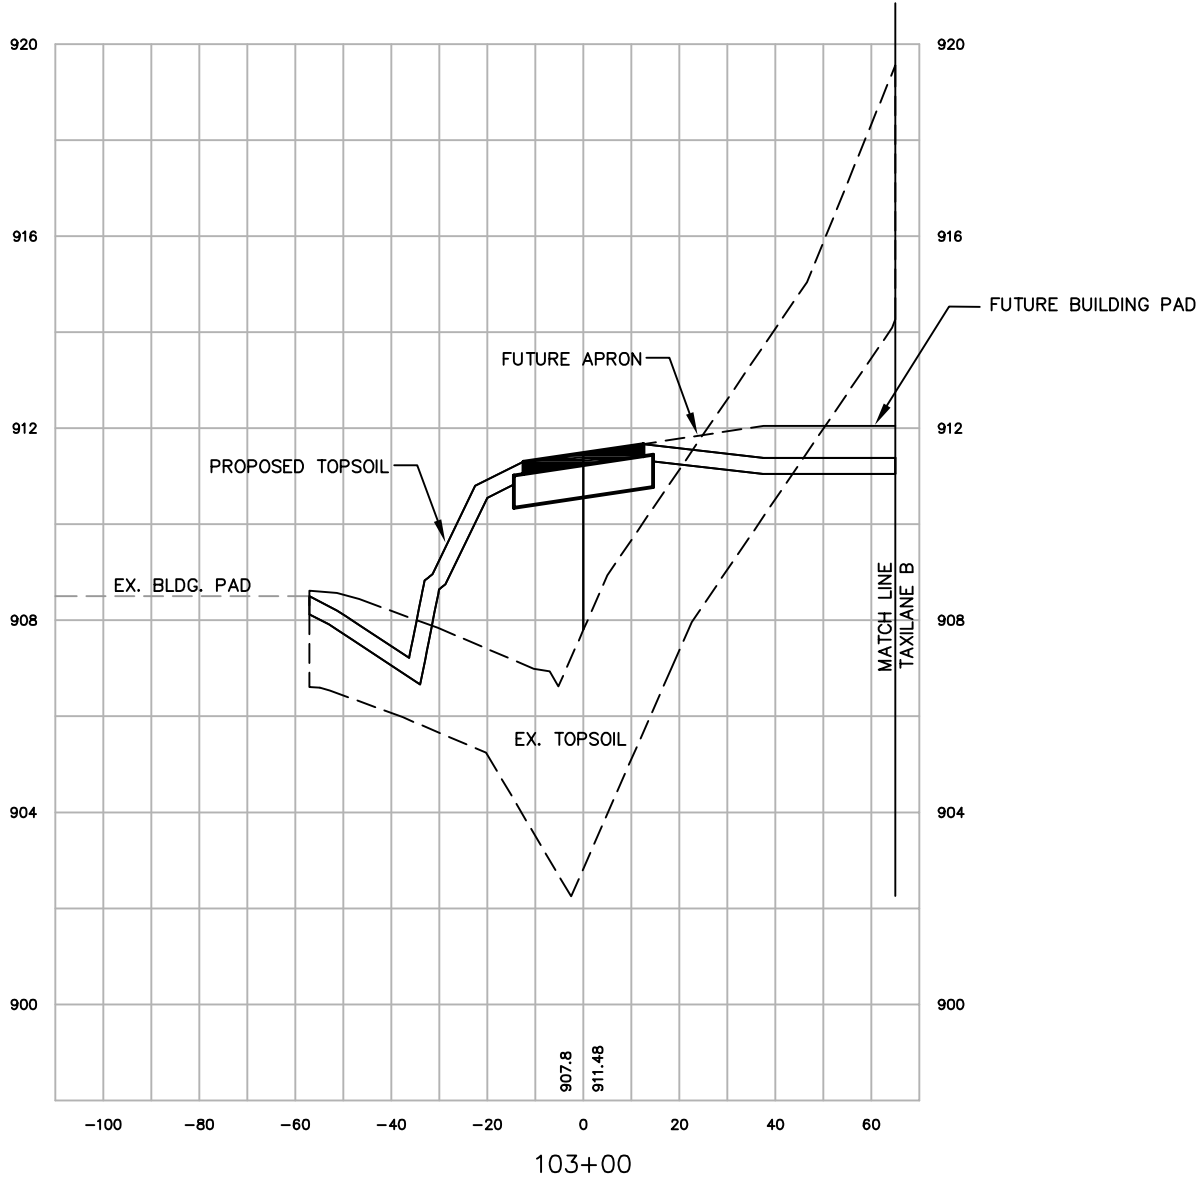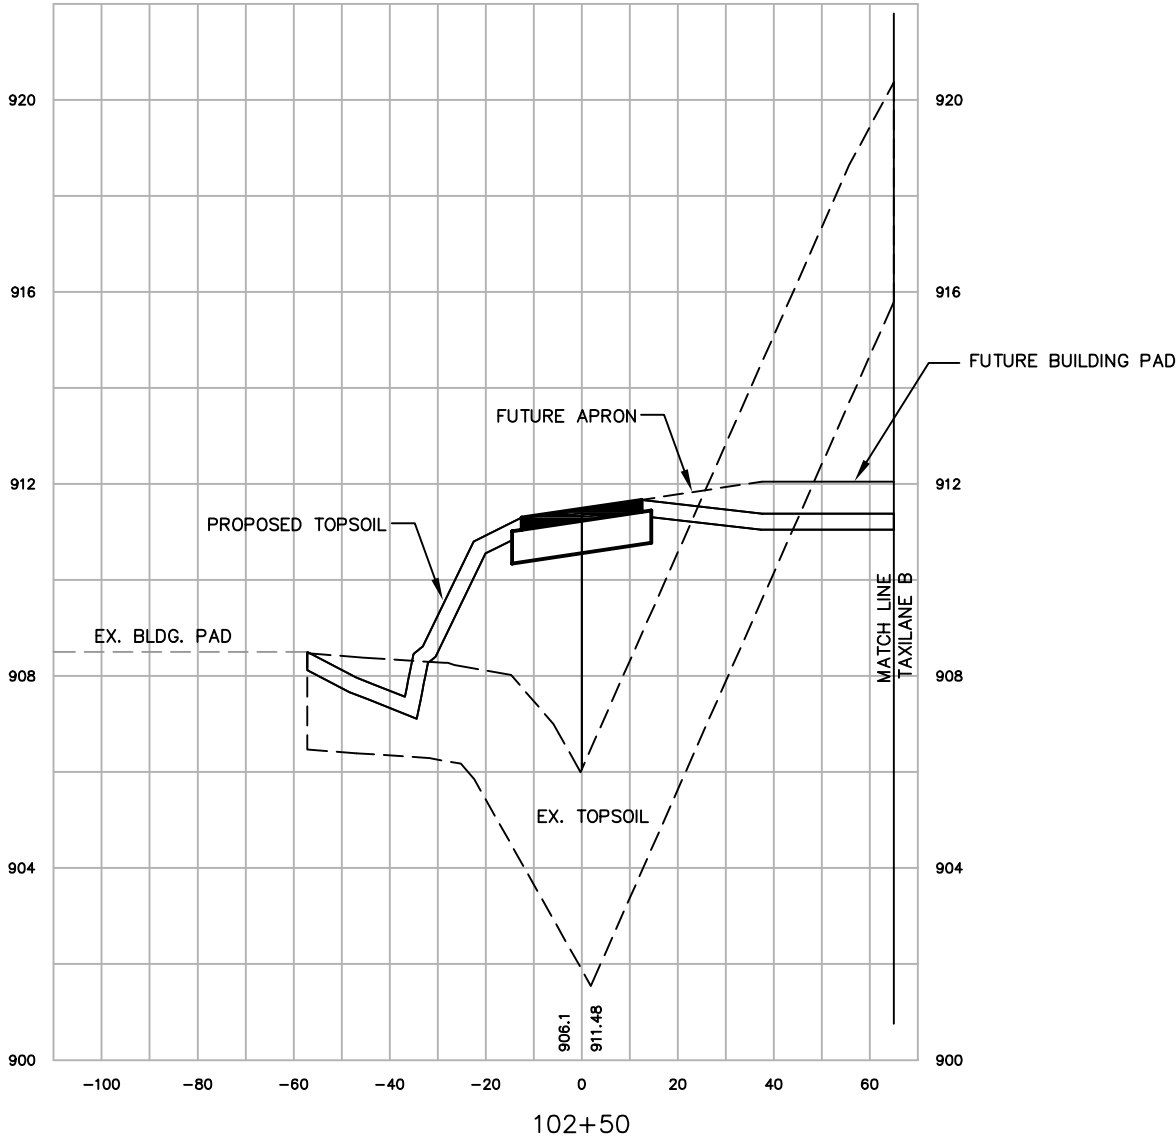

SCALE:
VERT. 1"=4'
HORIZ. 1"=40'



WAUKESHA COUNTY AIRPORT				NO.	DATE	AS-BUILT	REVISION	INITIAL
HANGAR AREA				Δ	12/08			MJK
CROSS SECTIONS								
TAXILANE A								
A.I.P. PROJECT NO.								
3-55-0090-22								
JOB NO.								
23099-90-04004								
DWG NO.								
9004004108.dwg								
SHEET NO.								
87								
of 130								

MEAD HUNT

WAUKESHA COUNTY AIRPORT



DESIGNED MJK
DRAWN MJK
CHECKED GAS

DATE \$DATE\$

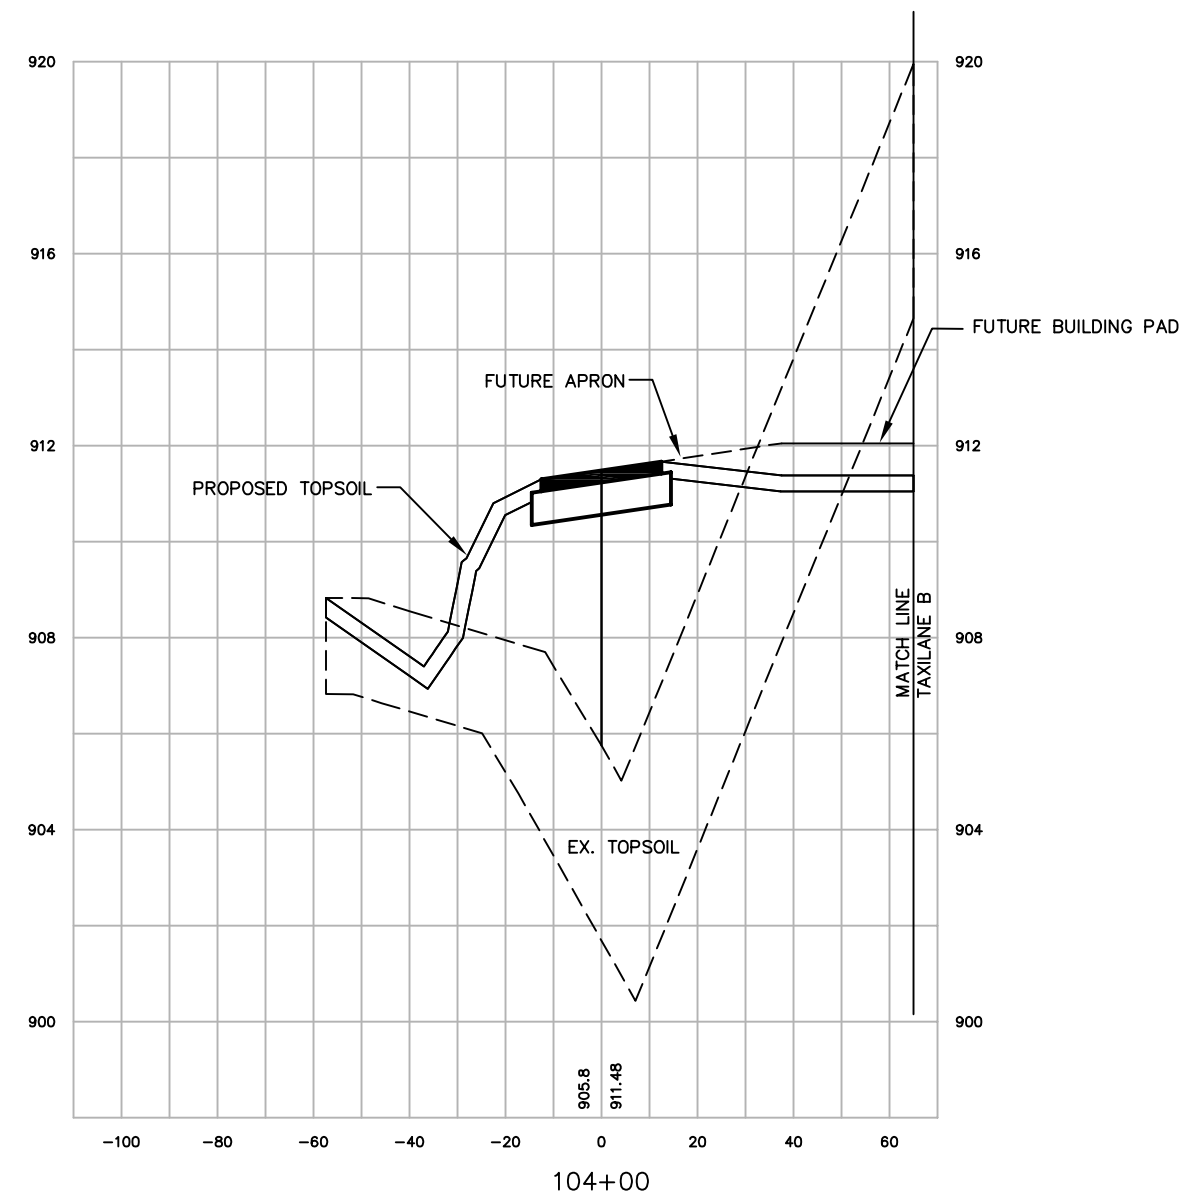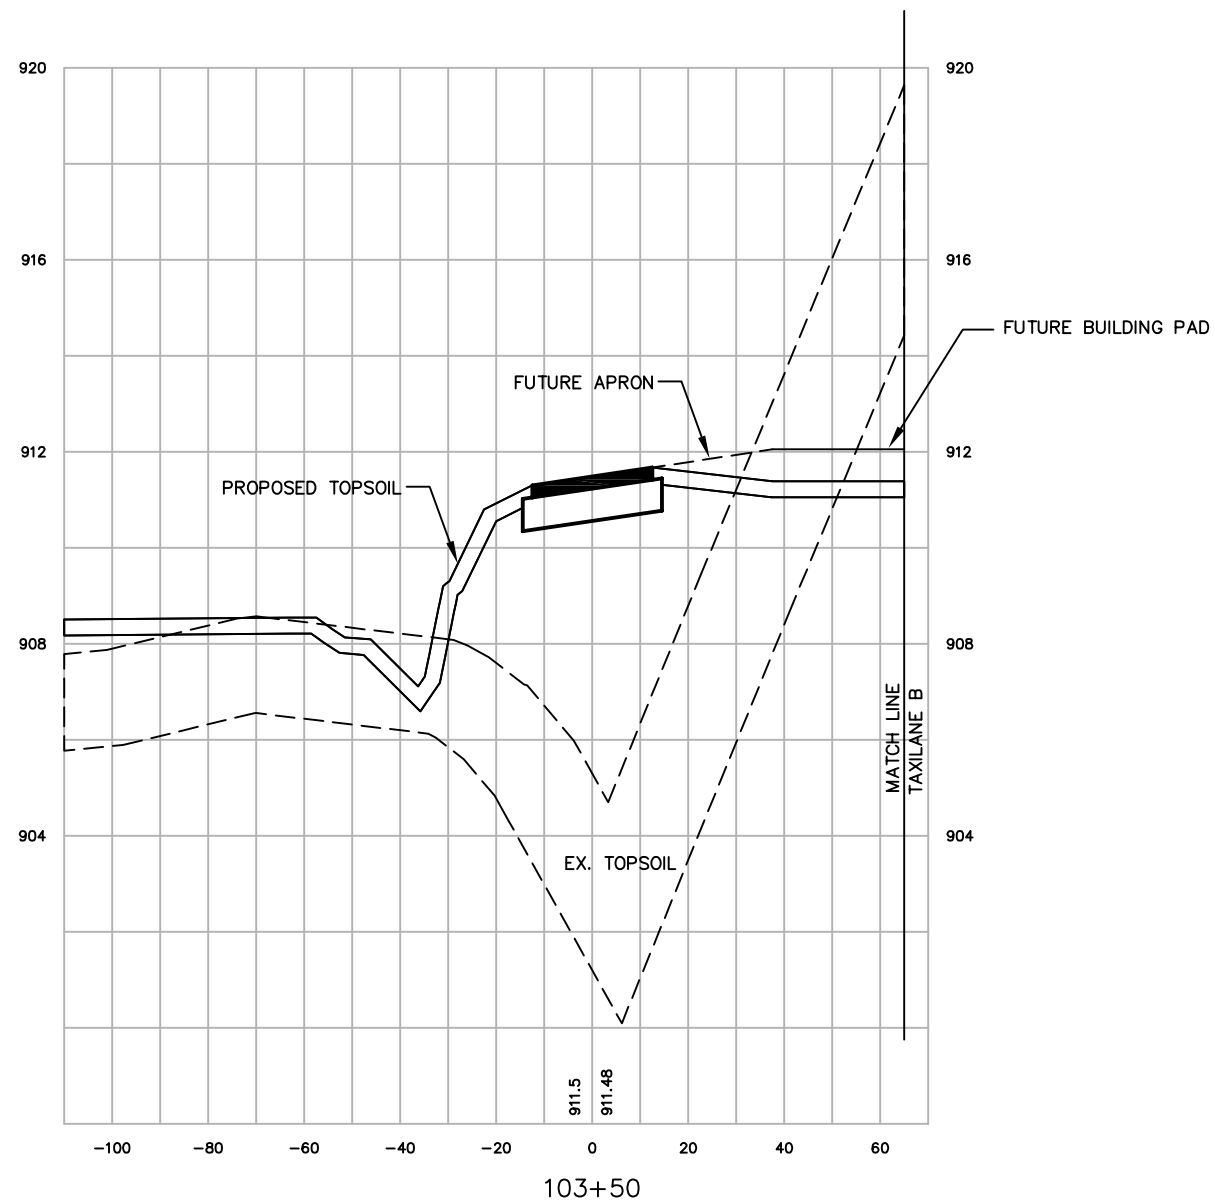



SCALE:
VERT. 1"=4'
HORIZ. 1"=40'

WAUKESHA COUNTY AIRPORT		HANGAR AREA CROSS SECTIONS TAXILANE A		A.I.P. PROJECT NO. 3-55-0090-22	
				JOB NO. 23099-90-04004	
				DWG NO. 9004004108.dwg	
				SHEET NO. 88 of 130	

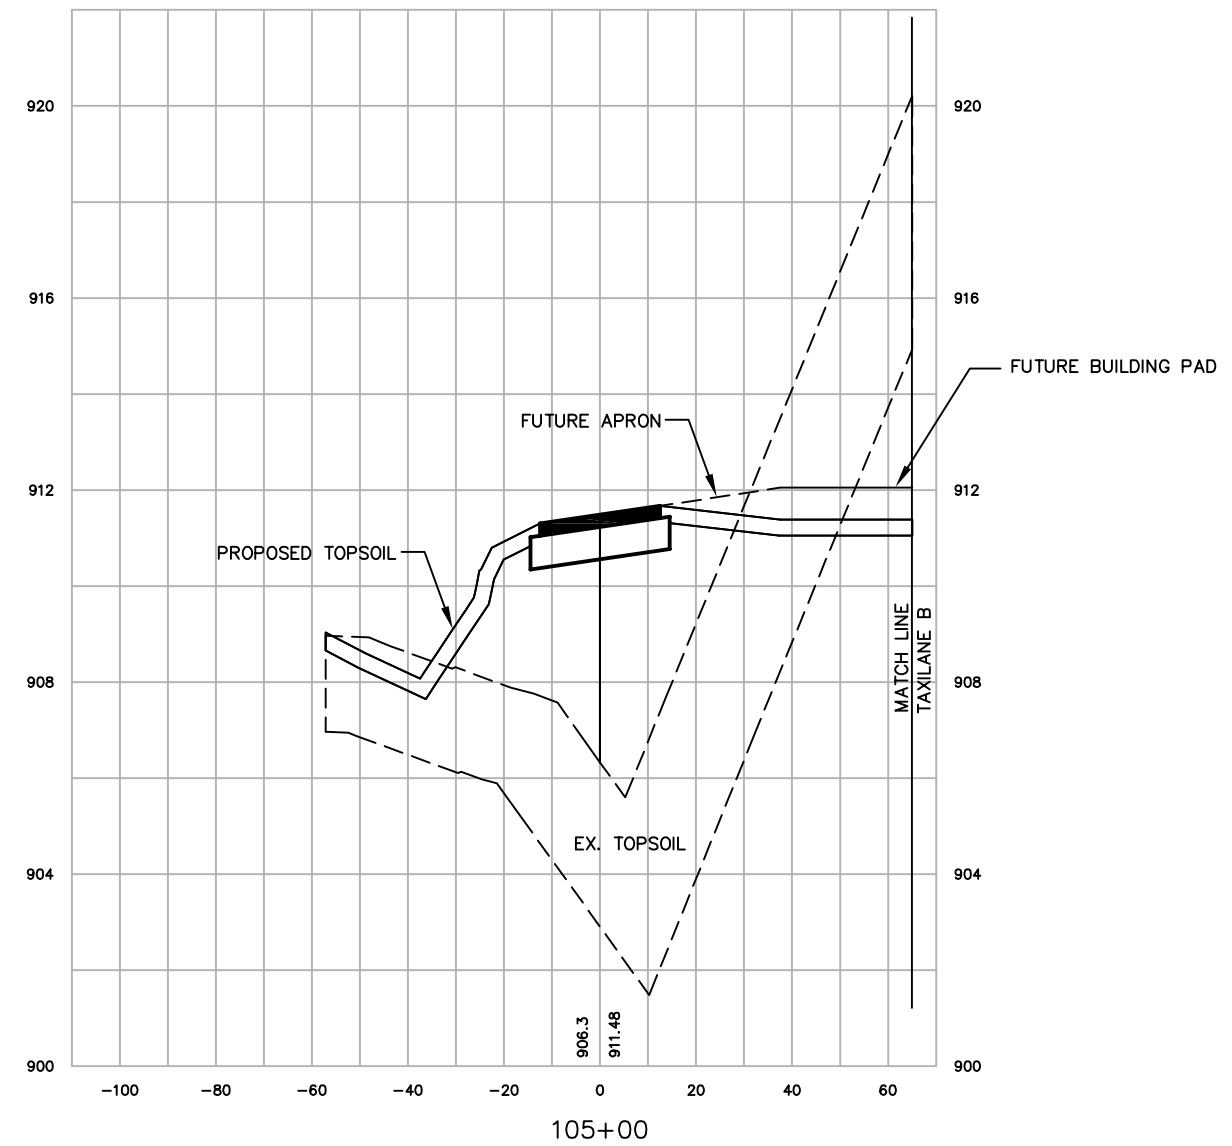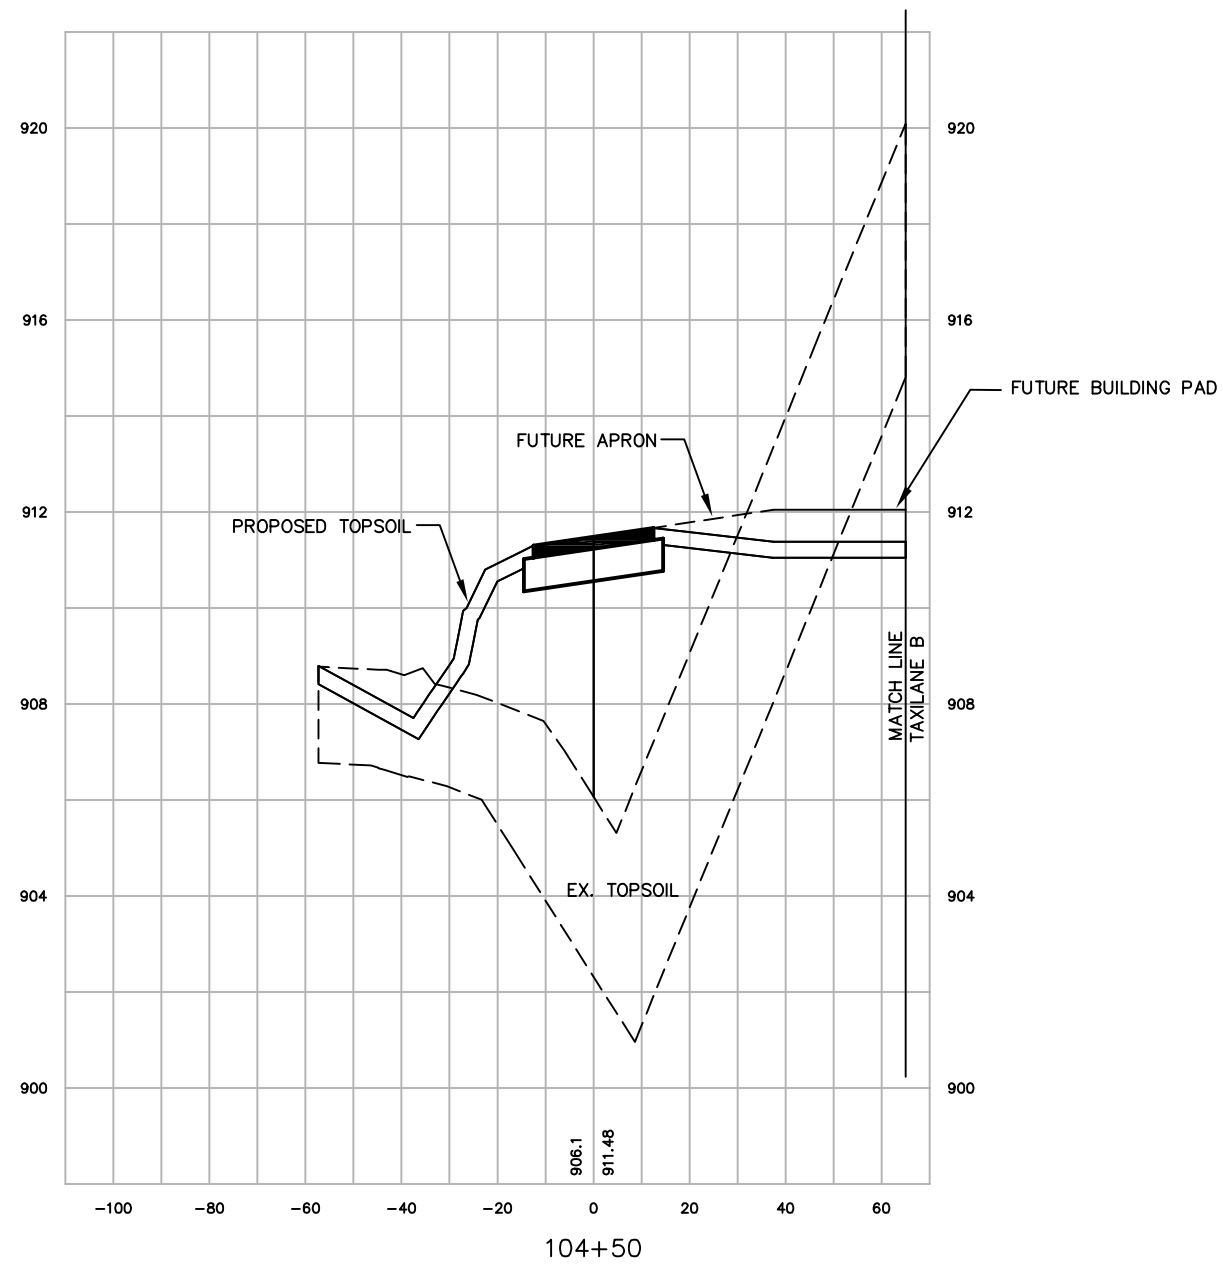

SCALE:
VERT. 1"=4'
HORIZ. 1"=40'


[illegible]

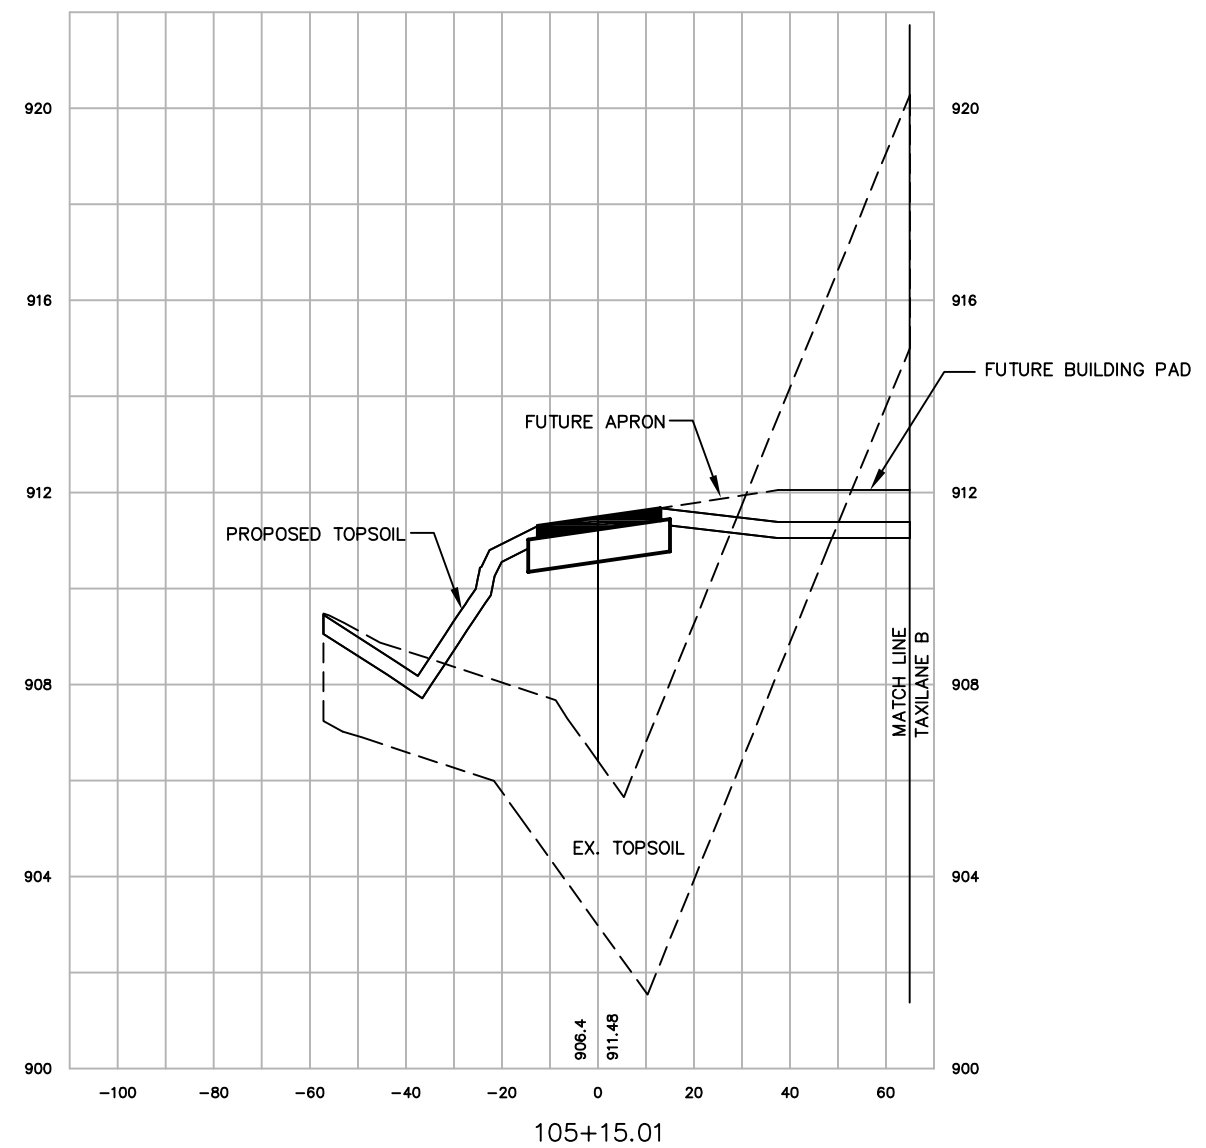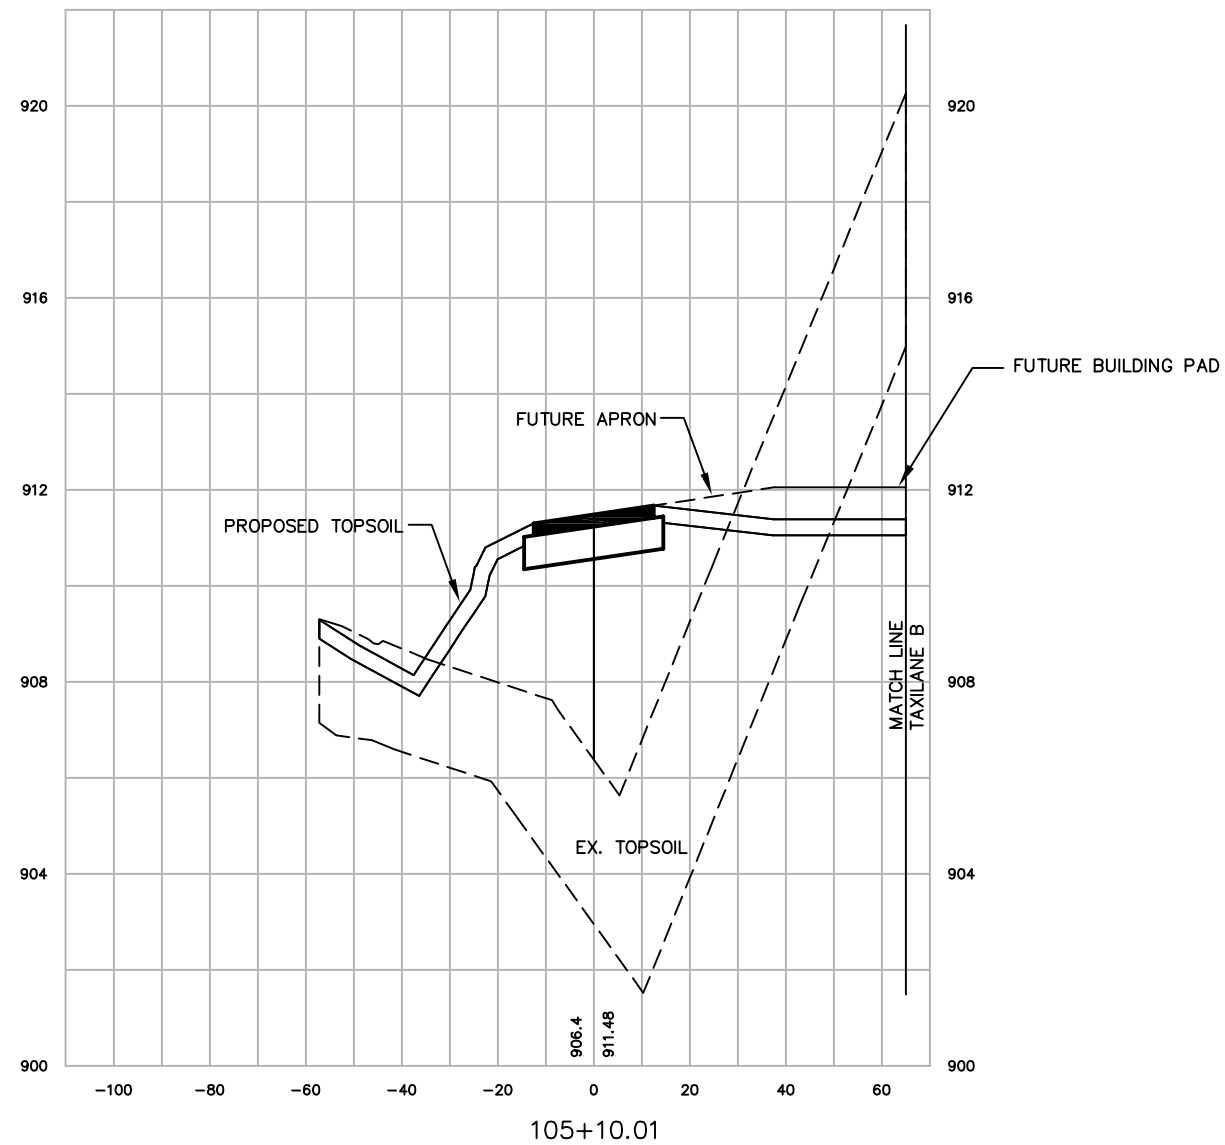

SCALE:
VERT. 1"=4'
HORIZ. 1"=40'

WAUKESHA COUNTY AIRPORT		HANGAR AREA		A.I.P. PROJECT NO. 3-55-0090-22	
		CROSS SECTIONS		JOB NO. 23099-90-04004	
		TAXILANE A		DWG NO. 9004004108.dwg	
				SHEET NO. 90 of 130	

X:\23099-90\06017\tech\cadd\drawings\AS-BUILT\HANGAR AREA\23099-90-04004 Land Desktop\dwg\23099-90-04004108.dwg






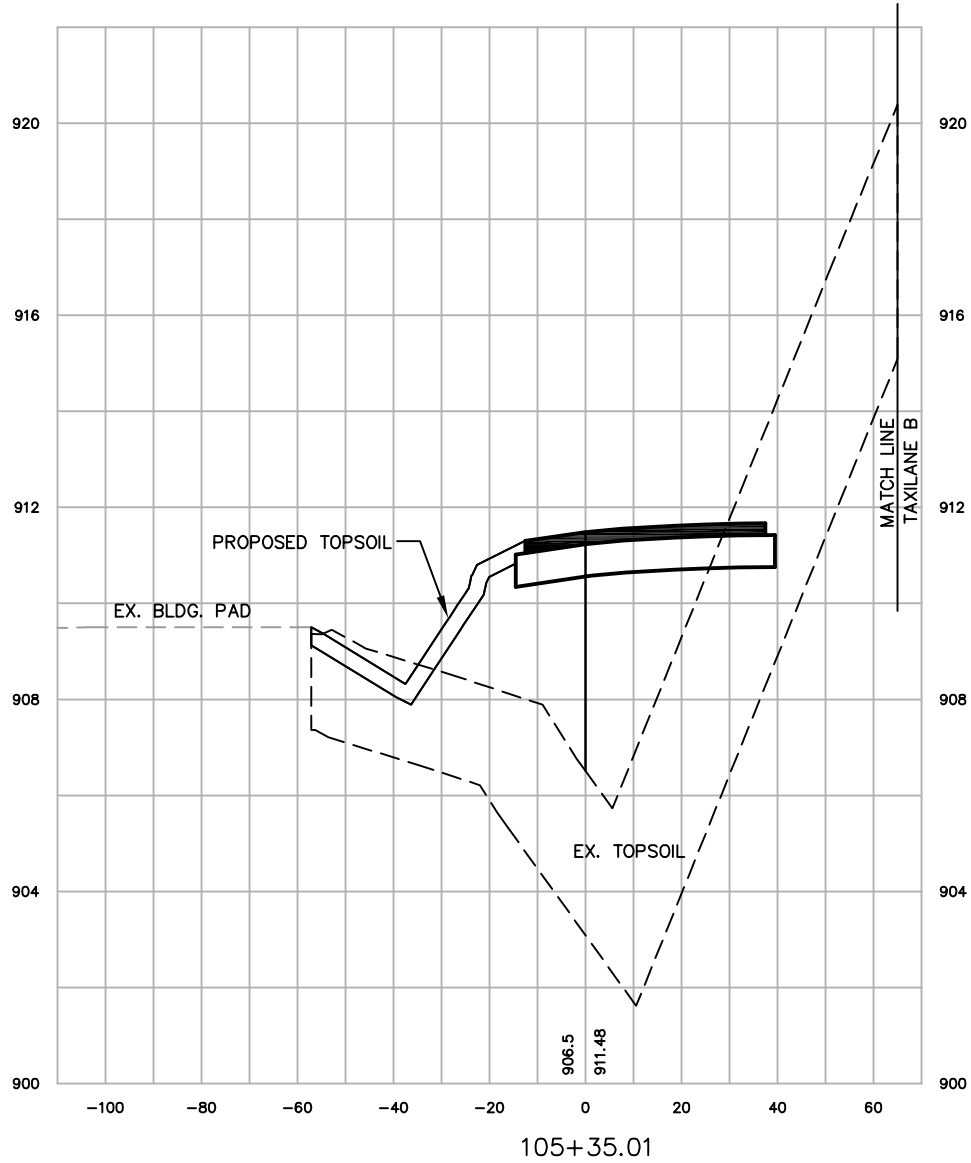


SCALE:
VERT. 1"=4'
HORIZ. 1"=40'

WAUKESHA COUNTY AIRPORT		DATE \$DATE\$		NO. DATE		REVISION		INITIAL	
HANGAR AREA		DESIGNED MJK		12/08		AS-BUILT		MJK	
CROSS SECTIONS		DRAWN MJK							
TAXILANE A		CHECKED GAS							
A.I.P. PROJECT NO.									
3-55-0090-22									
JOB NO.									
23099-90-04004									
DWG NO.									
9004004108.dwg									
SHEET NO.									
91		of		130					








x:\23099-90\06017\tech\cadd\drawings\AS-BUILT\HANGAR AREA\23099-90-04004 Land Desktop\dwg\23099-90-04004109.dwg

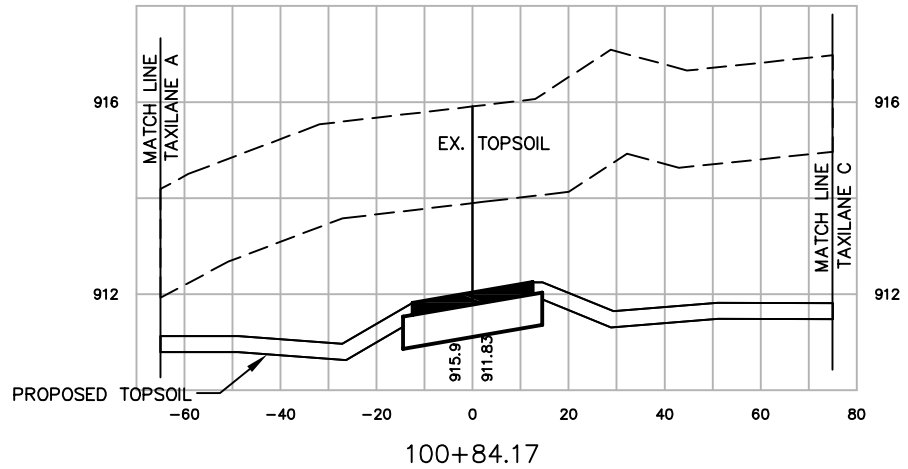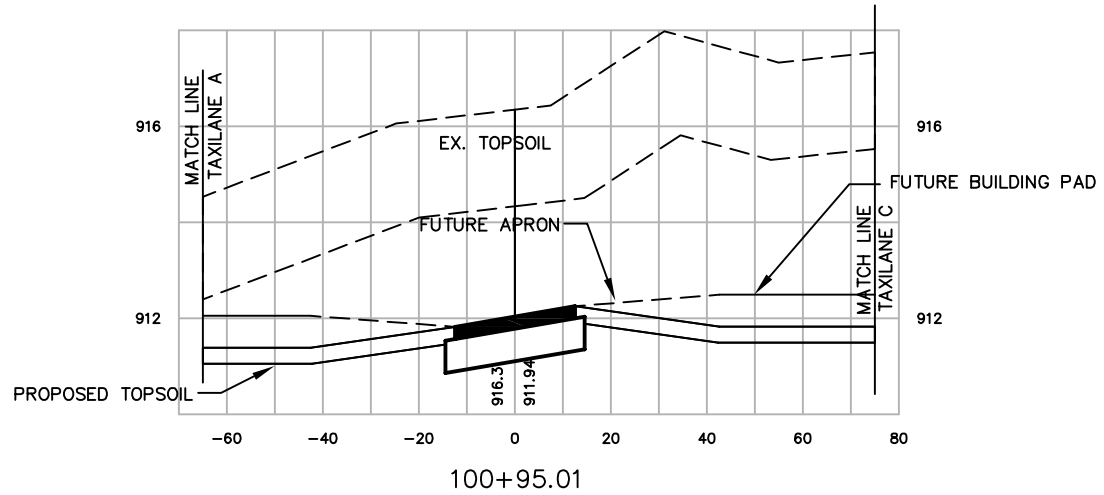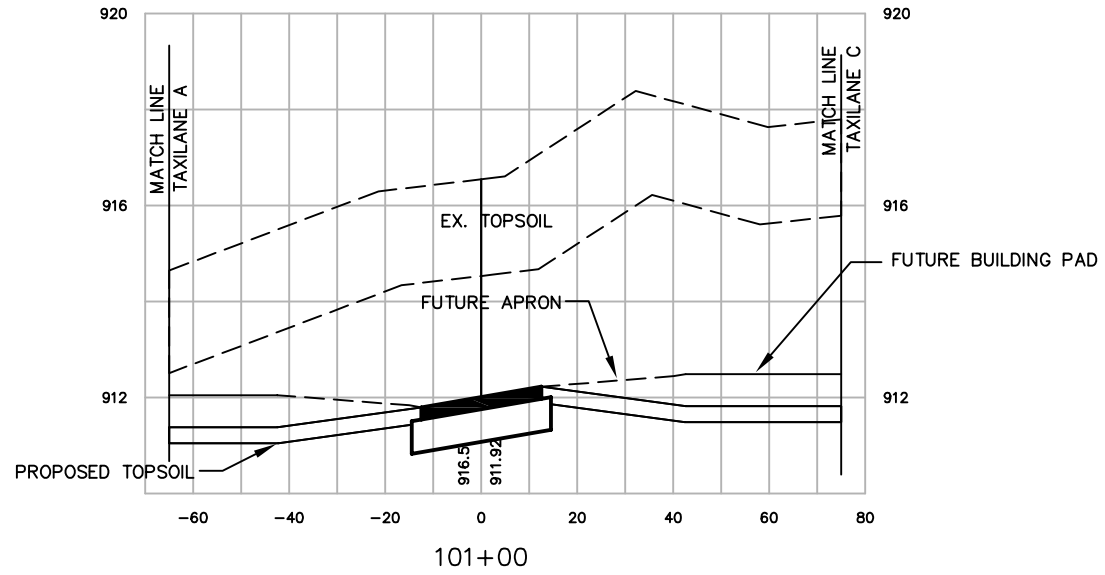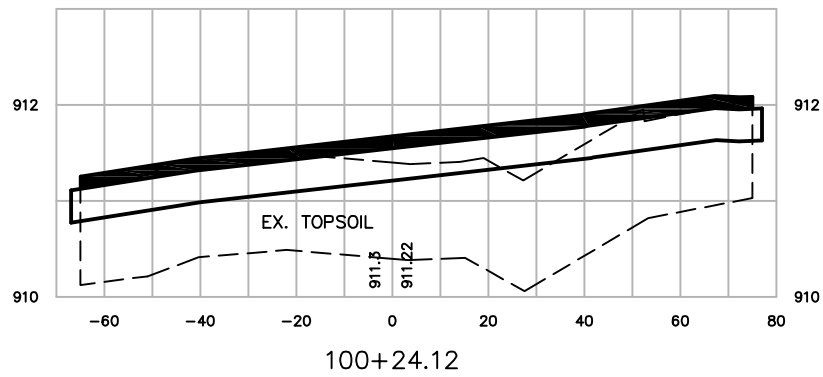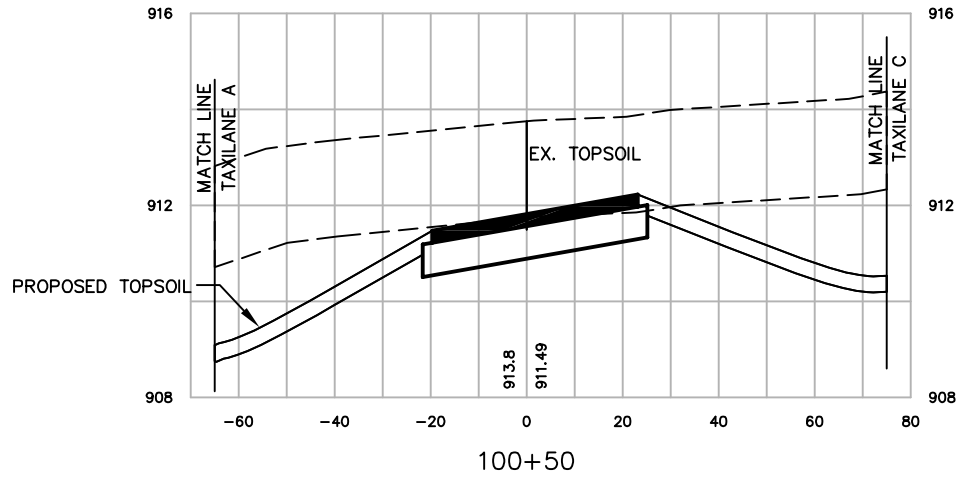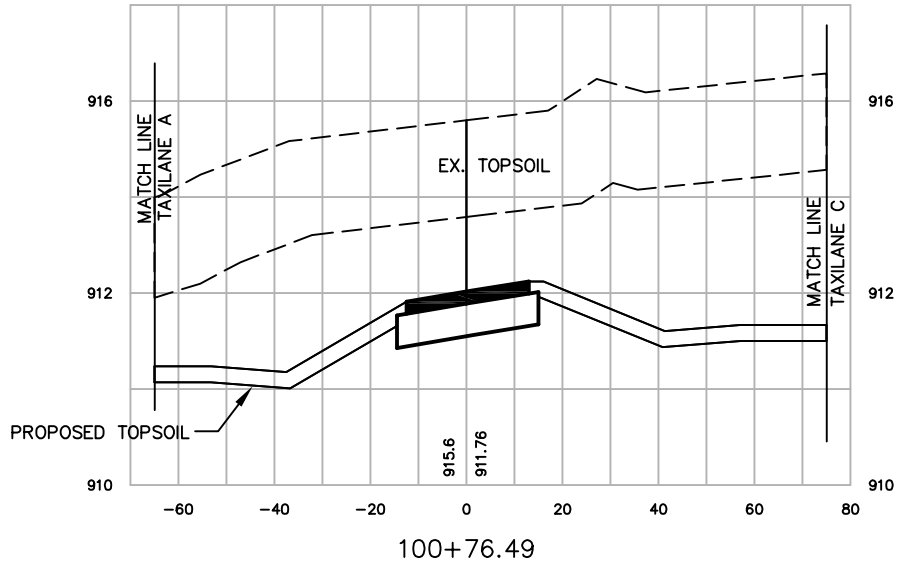

SCALE:
VERT. 1"=4'
HORIZ. 1"=40'

WAUKESHA COUNTY AIRPORT		HANGAR AREA CROSS SECTIONS TAXILANE B		DATE	\$DATE\$	DESIGNED MJK DRAWN MJK CHECKED GAS		MEAD & HUNT ENGINEERS PLLC 1200 WEST WISCONSIN AVENUE SUITE 200 MILWAUKEE, WI 53212 TEL: 414.224.1100 WWW.MEADANDHUNT.COM		NO.	DATE	AS-BUILT	REVISION	INITIAL
A.I.P. PROJECT NO. 3-55-0090-22		JOB NO. 23099-90-04004		DWG NO. 9004004109.dwg		SHEET NO. 92 of 130				12/08				MJK




x:\23099-90\06017\tech\cadd\drawings\AS-BUILT\HANGAR AREA\23099-90-04004 Land Desktop\dwg\23099-90-04004109.dwg

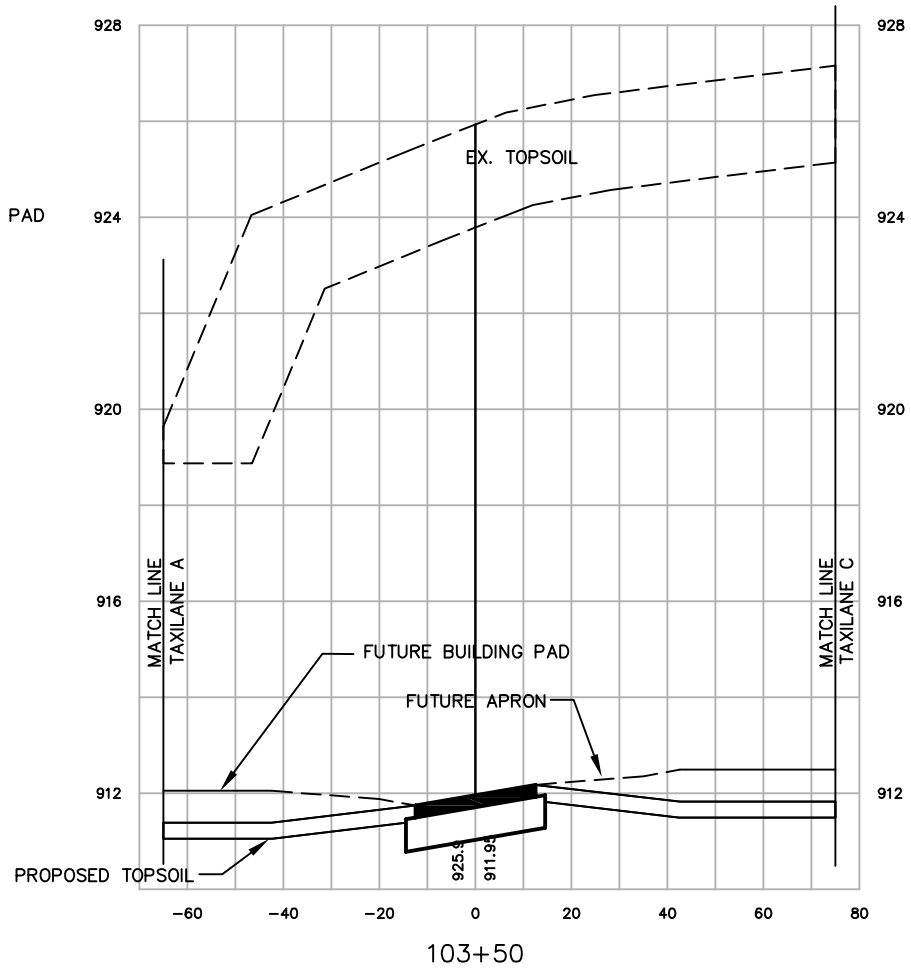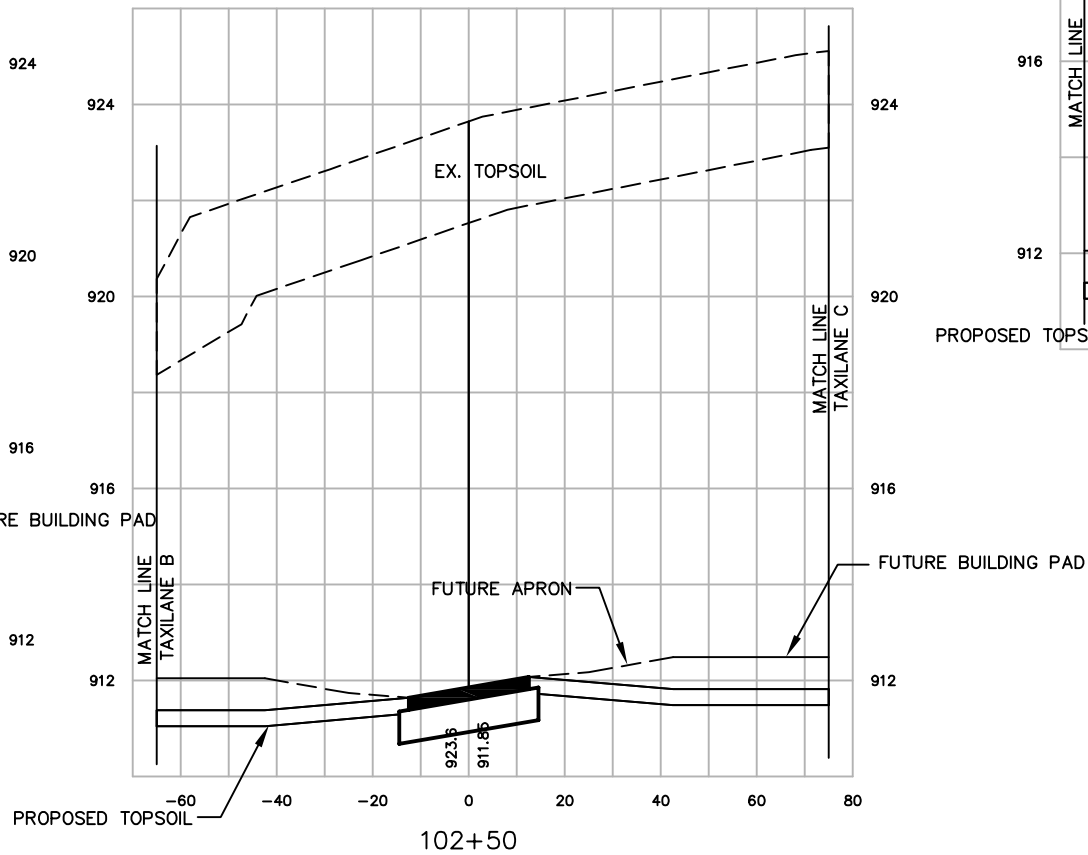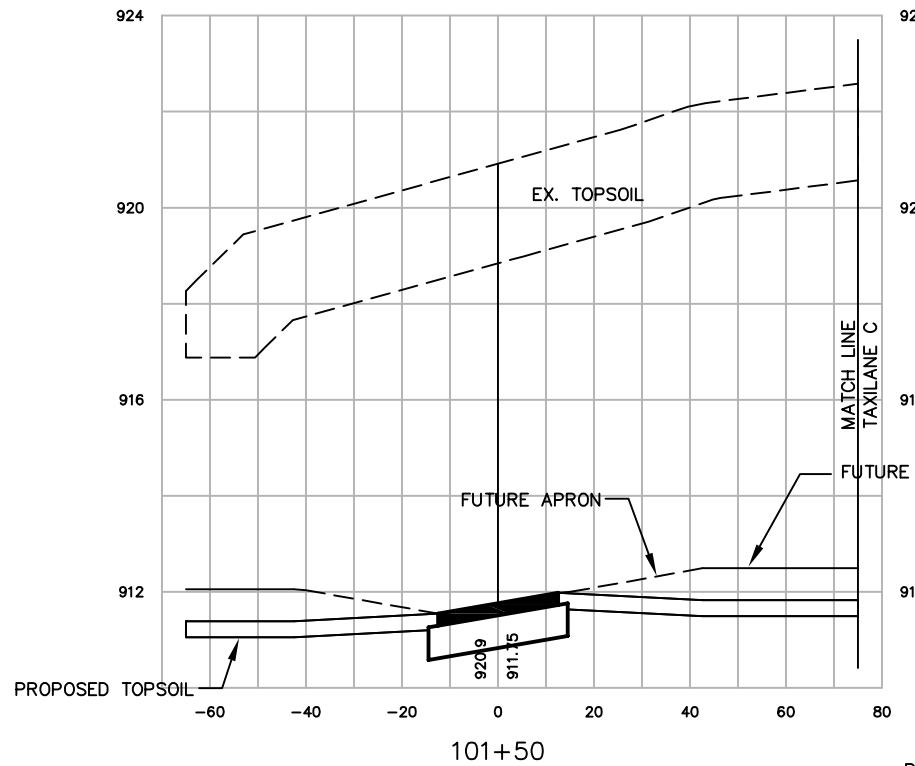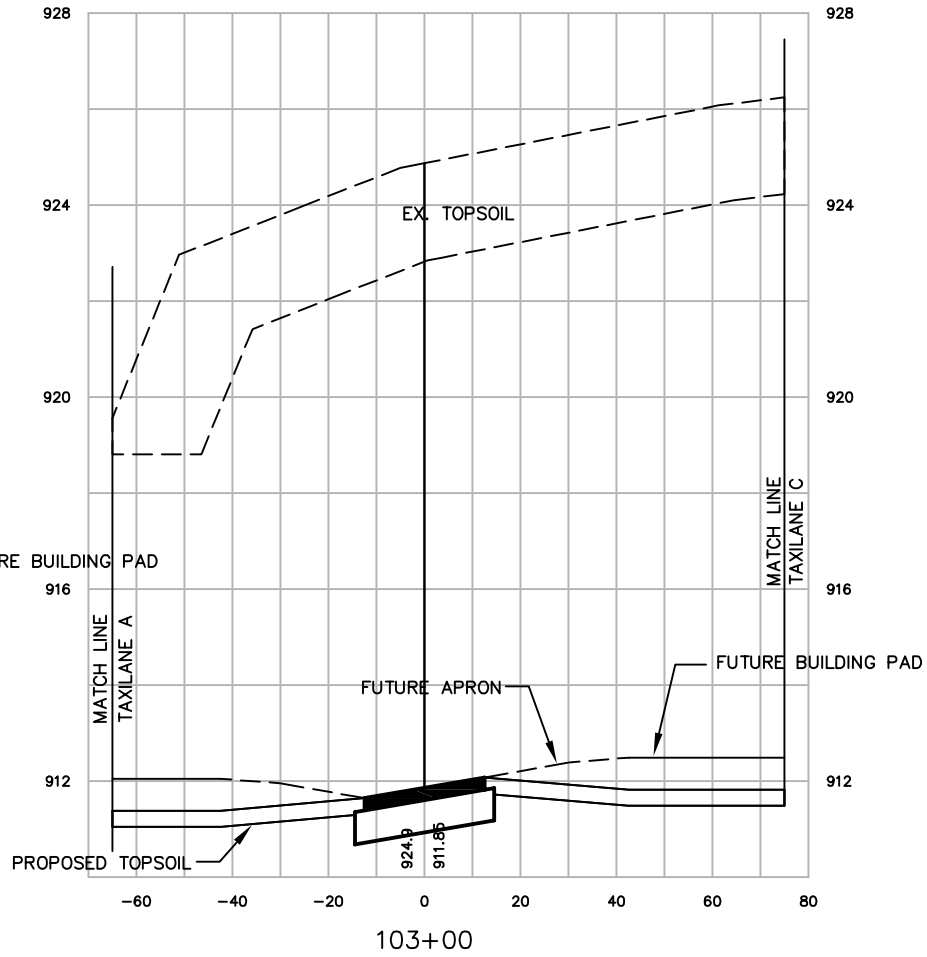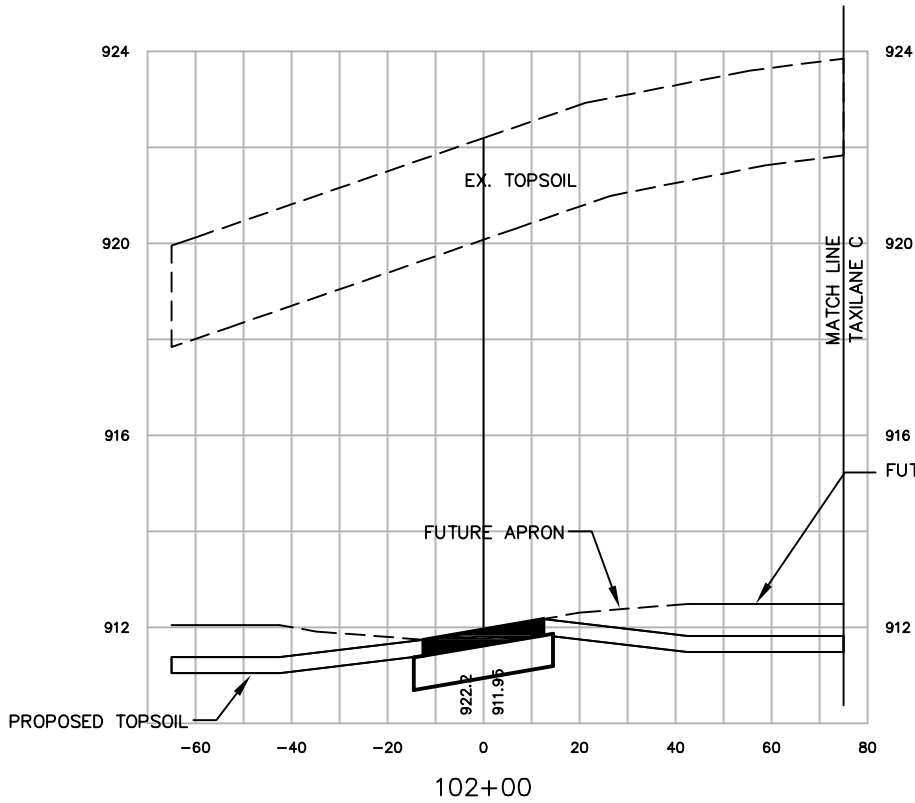

SCALE:
VERT. 1"=4'
HORIZ. 1"=40'

WAUKESHA COUNTY AIRPORT		DATE	\$DATE\$	DESIGNED MJK	
HANGAR AREA				DRAWN MJK	
CROSS SECTIONS				CHECKED GAS	
TAXILANE B					
A.I.P. PROJECT NO.		NO.		DATE	
3-55-0090-22		12/08		AS-BUILT	
JOB NO.		REVISION		INITIAL	
23099-90-04004				MJK	
DWG NO.					
9004004109.dwg					
SHEET NO.					
93 of 130					

X:\23099-90\06017\tech\cadd\drawings\AS-BUILTS\HANGAR AREA\23099-90-04004 Land Desktop\dwg\23099-90-04004109.dwg

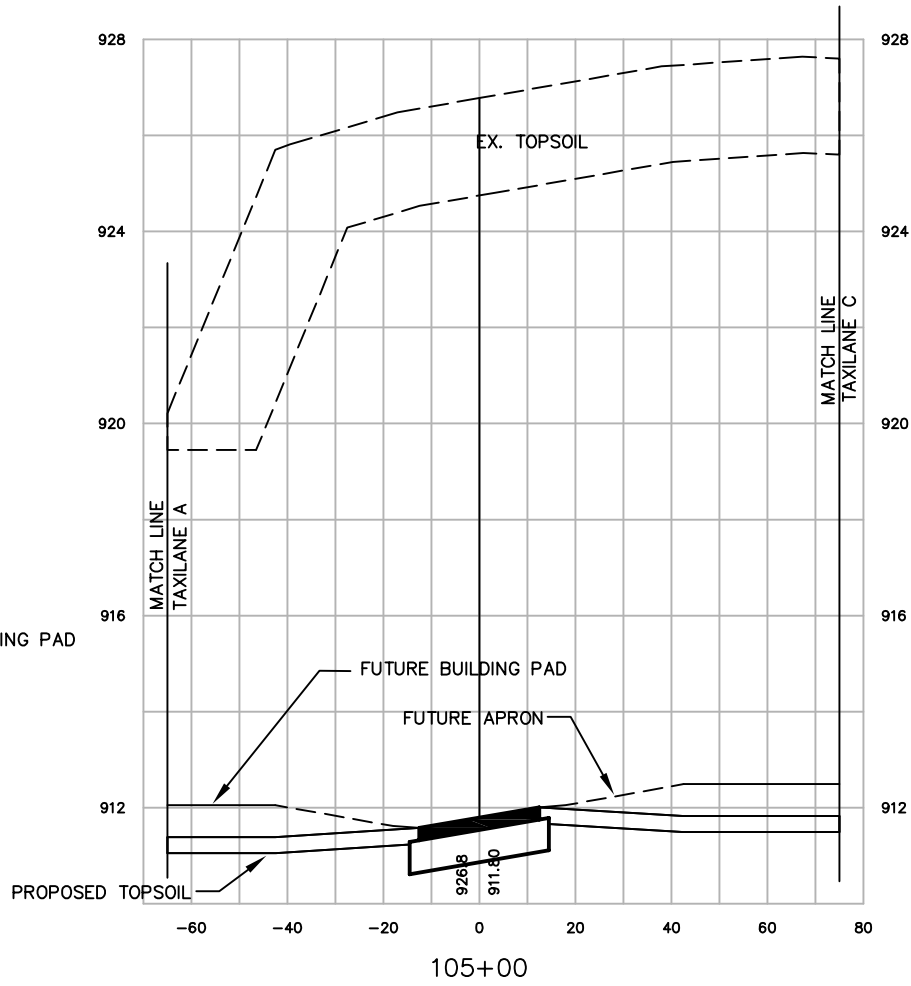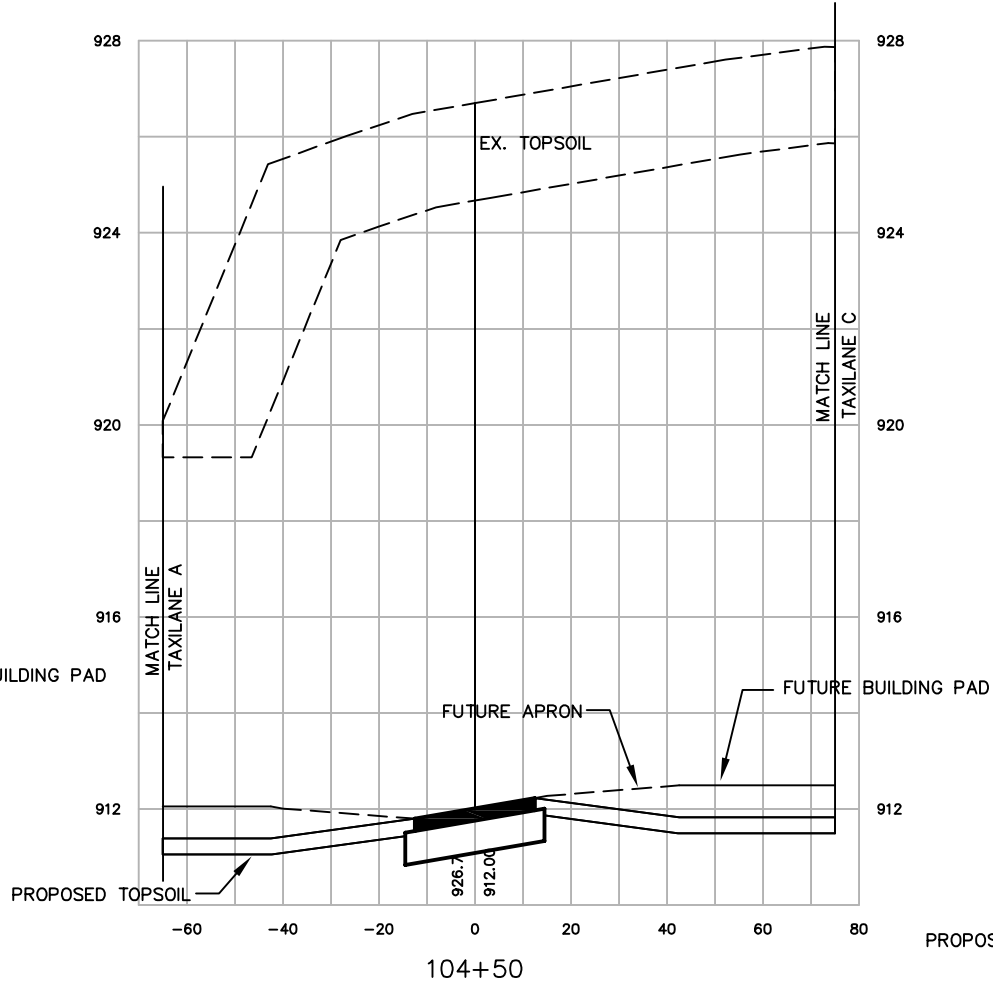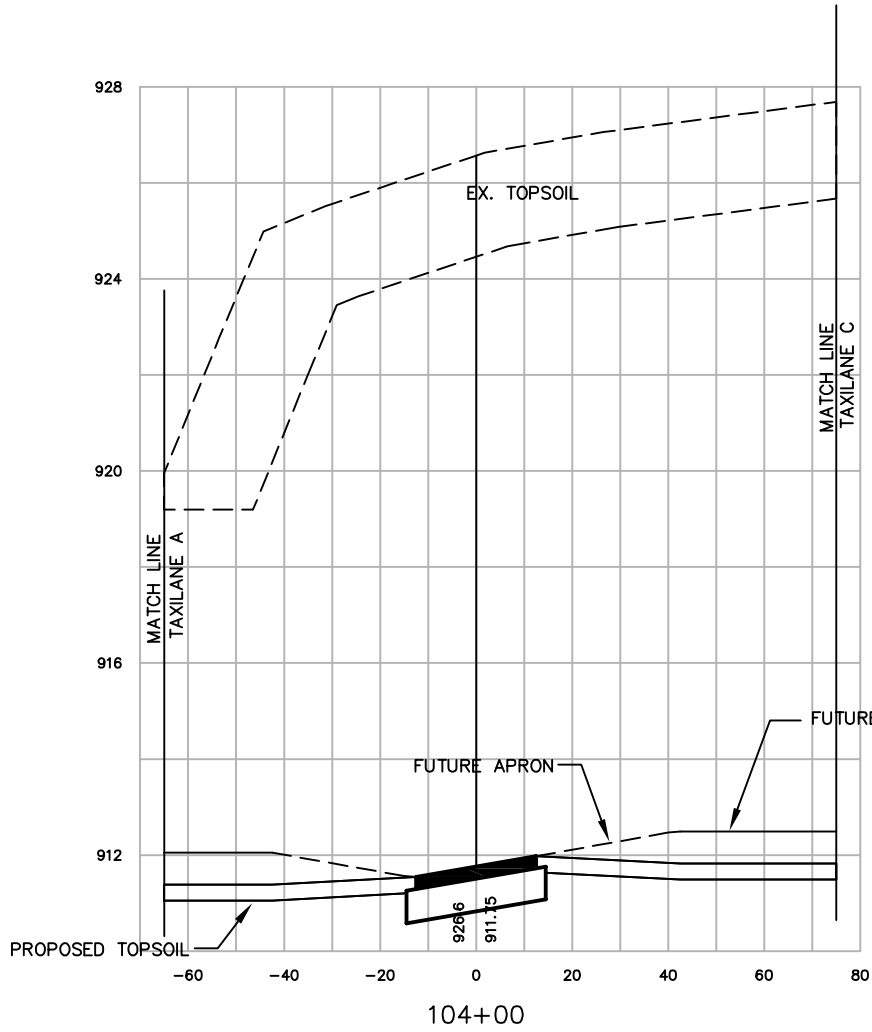

SCALE:
VERT. 1"=4'
HORIZ. 1"=40'

HANGAR AREA
CROSS SECTIONS
TAXILANE B

A.I.P. PROJECT NO.
3-55-0090-22

JOB NO.
23099-90-04004

DWG NO.
9004004109.dwg

SHEET NO.
94 of 130

DATE \$DATE\$
DESIGNED MJK
DRAWN MJK
CHECKED GAS




NO.	DATE	AS-BUILT	REVISION	INITIAL
1	12/08			MJK

Jan 08, 2009 - 10:38pm

SCALE:
VERT. 1"=4'
HORIZ. 1"=40'

WAUKESHA COUNTY AIRPORT						NO. <u>Δ</u> DATE <u>12/08</u> AS-BUILT _____ _____ _____ _____ _____		INITIAL
		DATE \$DATE\$ _____ DESIGNED MJK _____ DRAWN MJK _____ CHECKED GAS _____						MJK
HANGAR AREA CROSS SECTIONS TAXILANE B		A.I.P. PROJECT NO. 3-55-0090-22 JOB NO. 23099-90-04004 DWG NO. 9004004109.dwg SHEET NO. 95 of 130						

X:\23099-90\06017\tech\cadd\drawings\AS-BUILT\HANGAR AREA\23099-90-04004 Land Desktop\dwg\23099-90-04004110.dwg



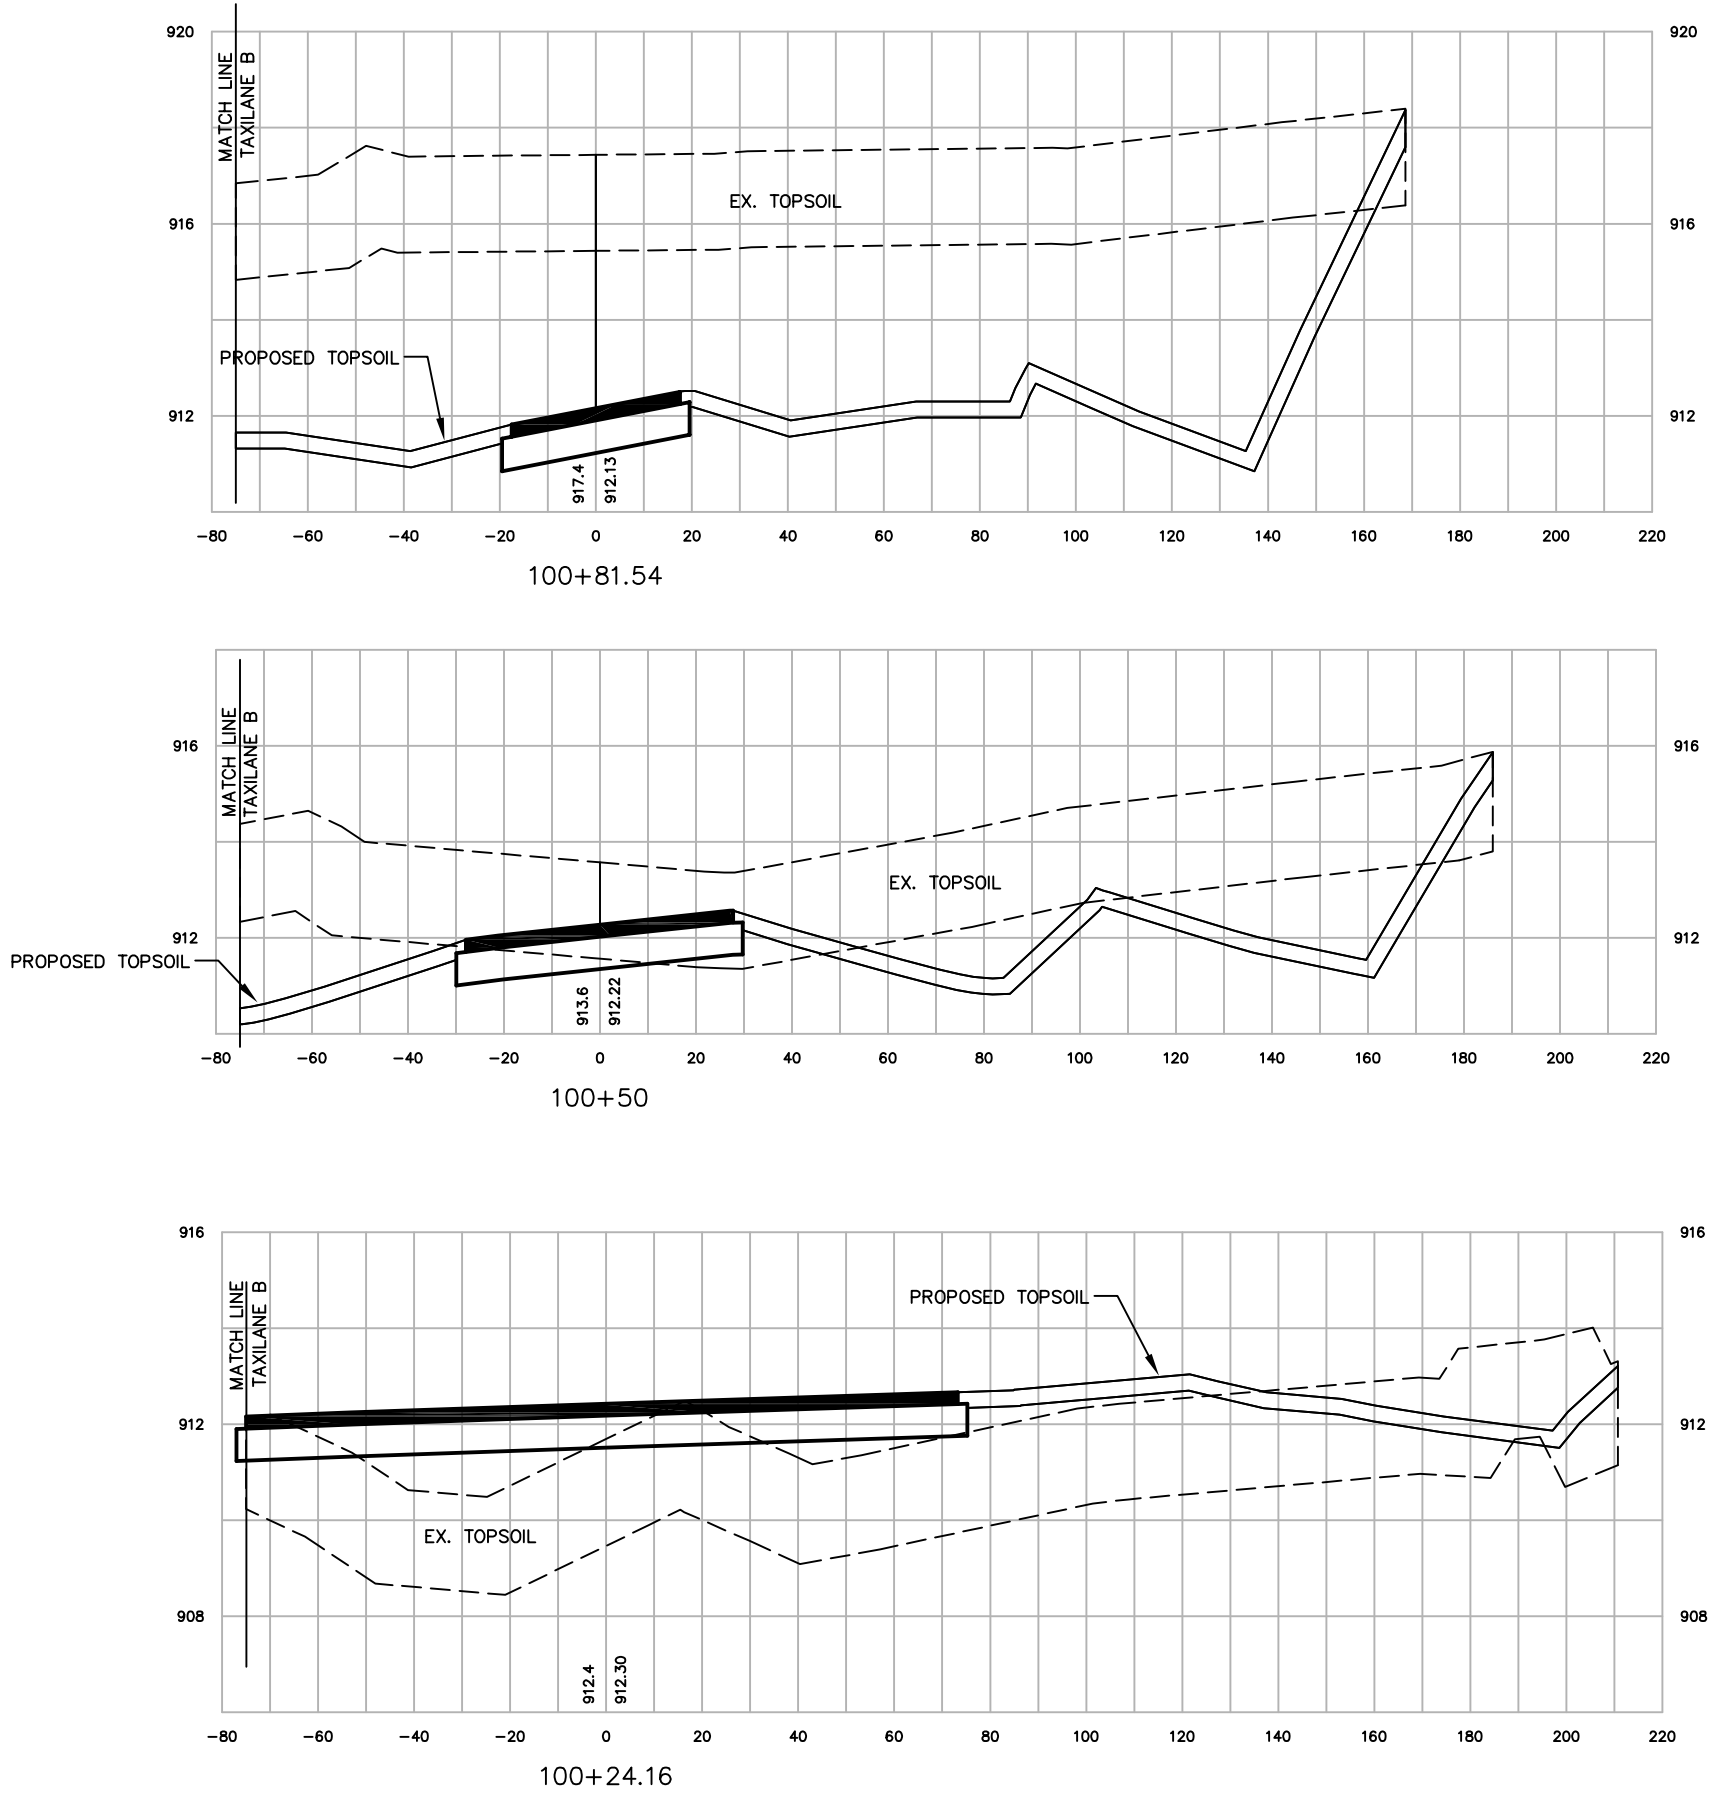


SCALE:
VERT. 1"=4'
HORIZ. 1"=40'

WAUKESHA COUNTY AIRPORT		DATE	\$DATE\$	DESIGNED MJK		INITIAL	
HANGAR AREA				DRAWN MJK		MJK	
CROSS SECTIONS				CHECKED GAS			
TAXILANE C							
A.I.P. PROJECT NO.		NO.	DATE	AS-BUILT	REVISION	INITIAL	
3-55-0090-22		12/08					
JOB NO.							
23099-90-04004							
DWG NO.							
9004004110.dwg							
SHEET NO.							
96 of 130							





x:\23099-90\06017\tech\cadd\drawings\AS-BUILT\HANGAR AREA\23099-90-04004 Land Desktop\dwg\23099-90-04004110.dwg

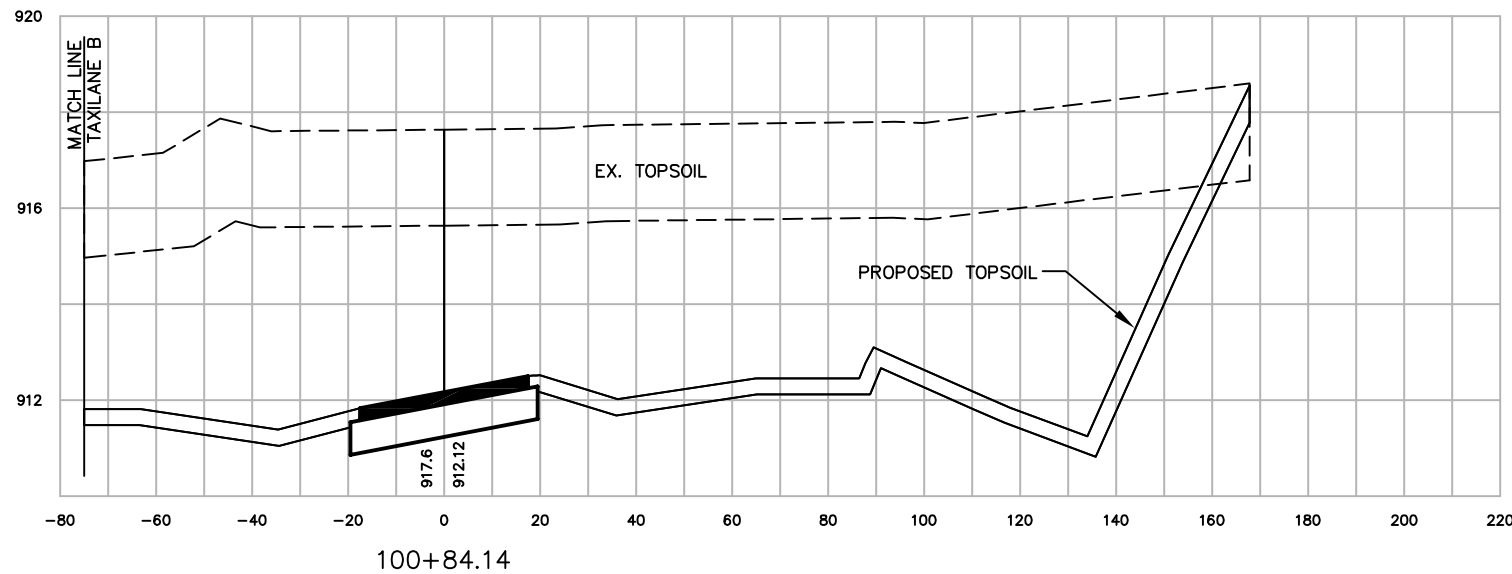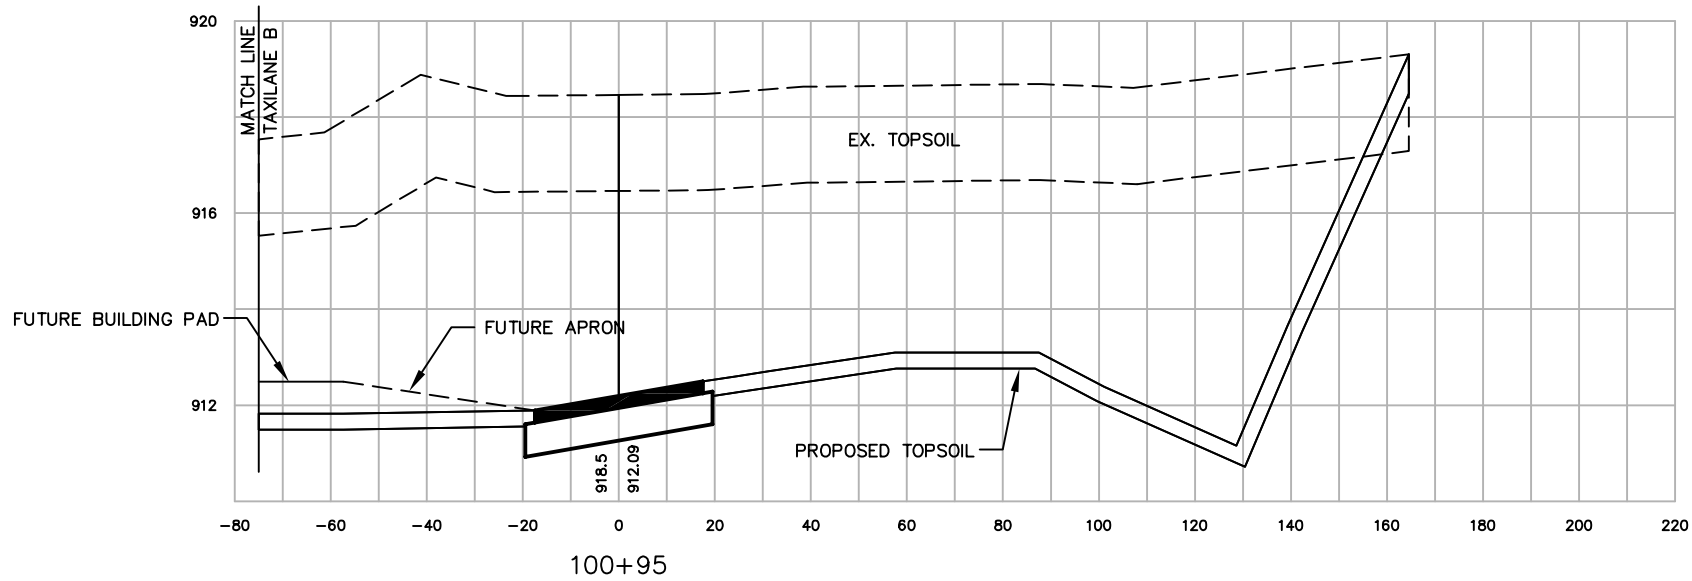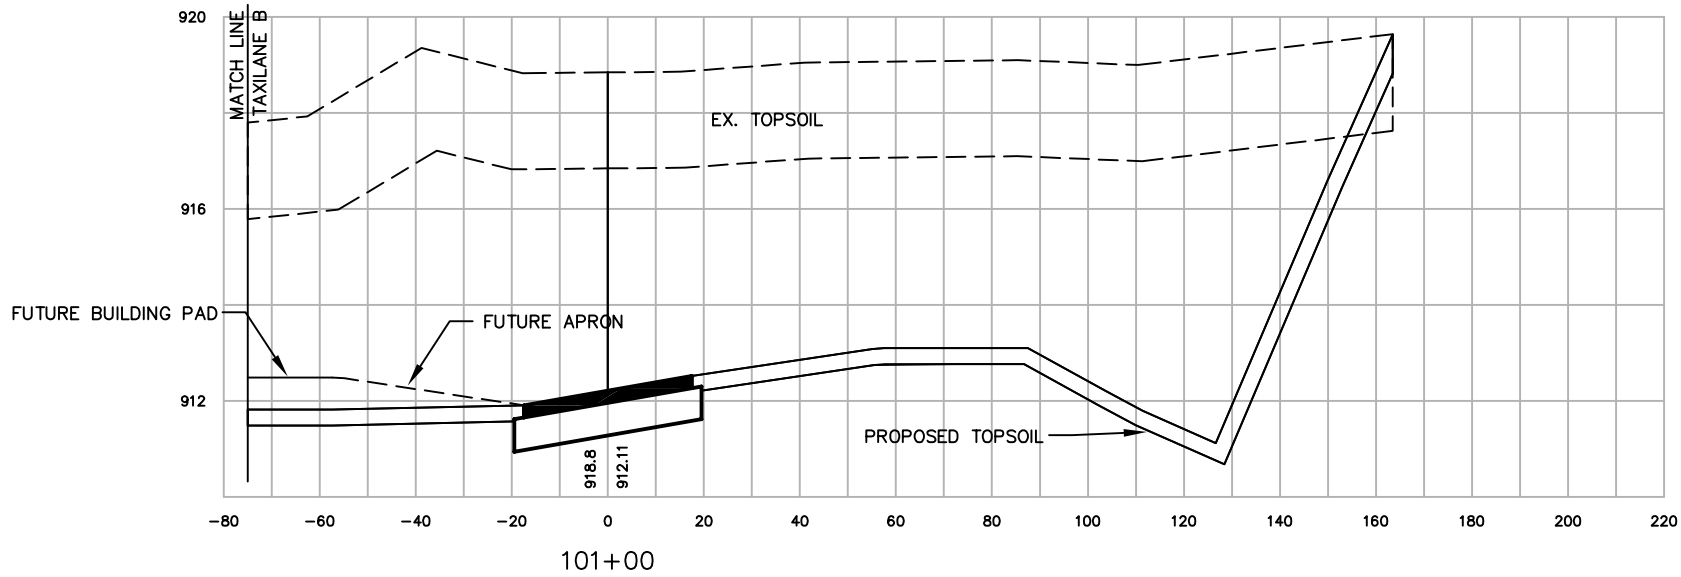

SCALE:
VERT. 1"=4'
HORIZ. 1"=40'

WAUKESHA COUNTY AIRPORT		HANGAR AREA CROSS SECTIONS TAXILANE C		A.I.P. PROJECT NO. 3-55-0090-22	
DATE \$DATE\$		DESIGNED MJK		JOB NO. 23099-90-04004	
		DRAWN MJK		DWG NO. 9004004110.dwg	
		CHECKED GAS		SHEET NO. 97 of 130	
MEAD & HUNT		WAUKESHA COUNTY AIRPORT		NO. DATE AS-BUILT	
				12/08	
				REVISION	
				INITIAL	
				MJK	

X:\23099-90\06017\tech\cadd\drawings\AS-BUILTS\HANGAR AREA\23099-90-04004 Land Desktop\dwg\23099-90-04004110.dwg

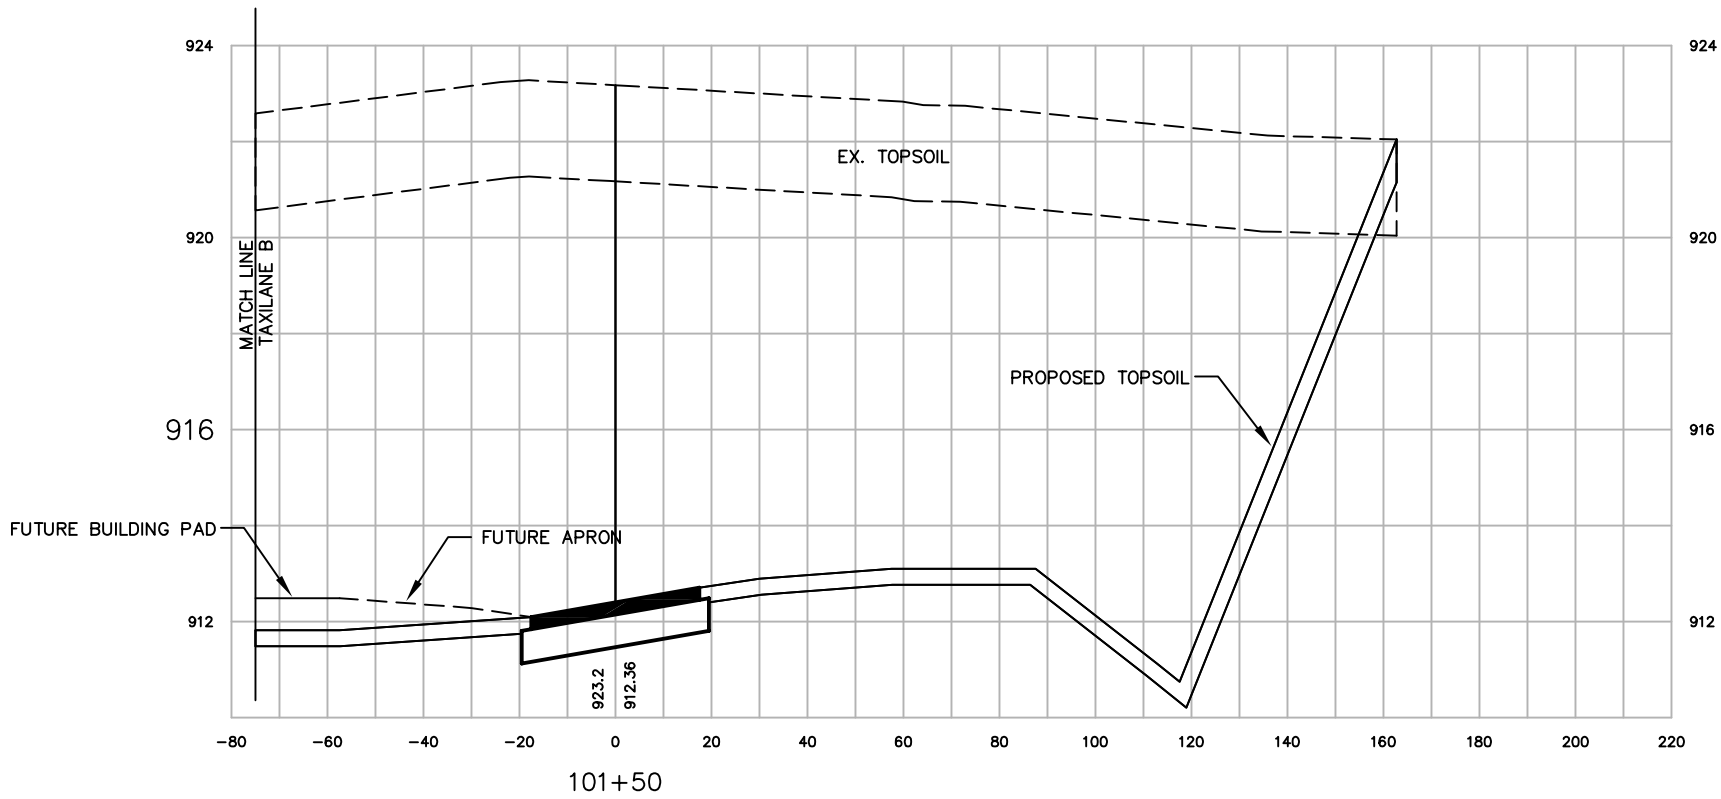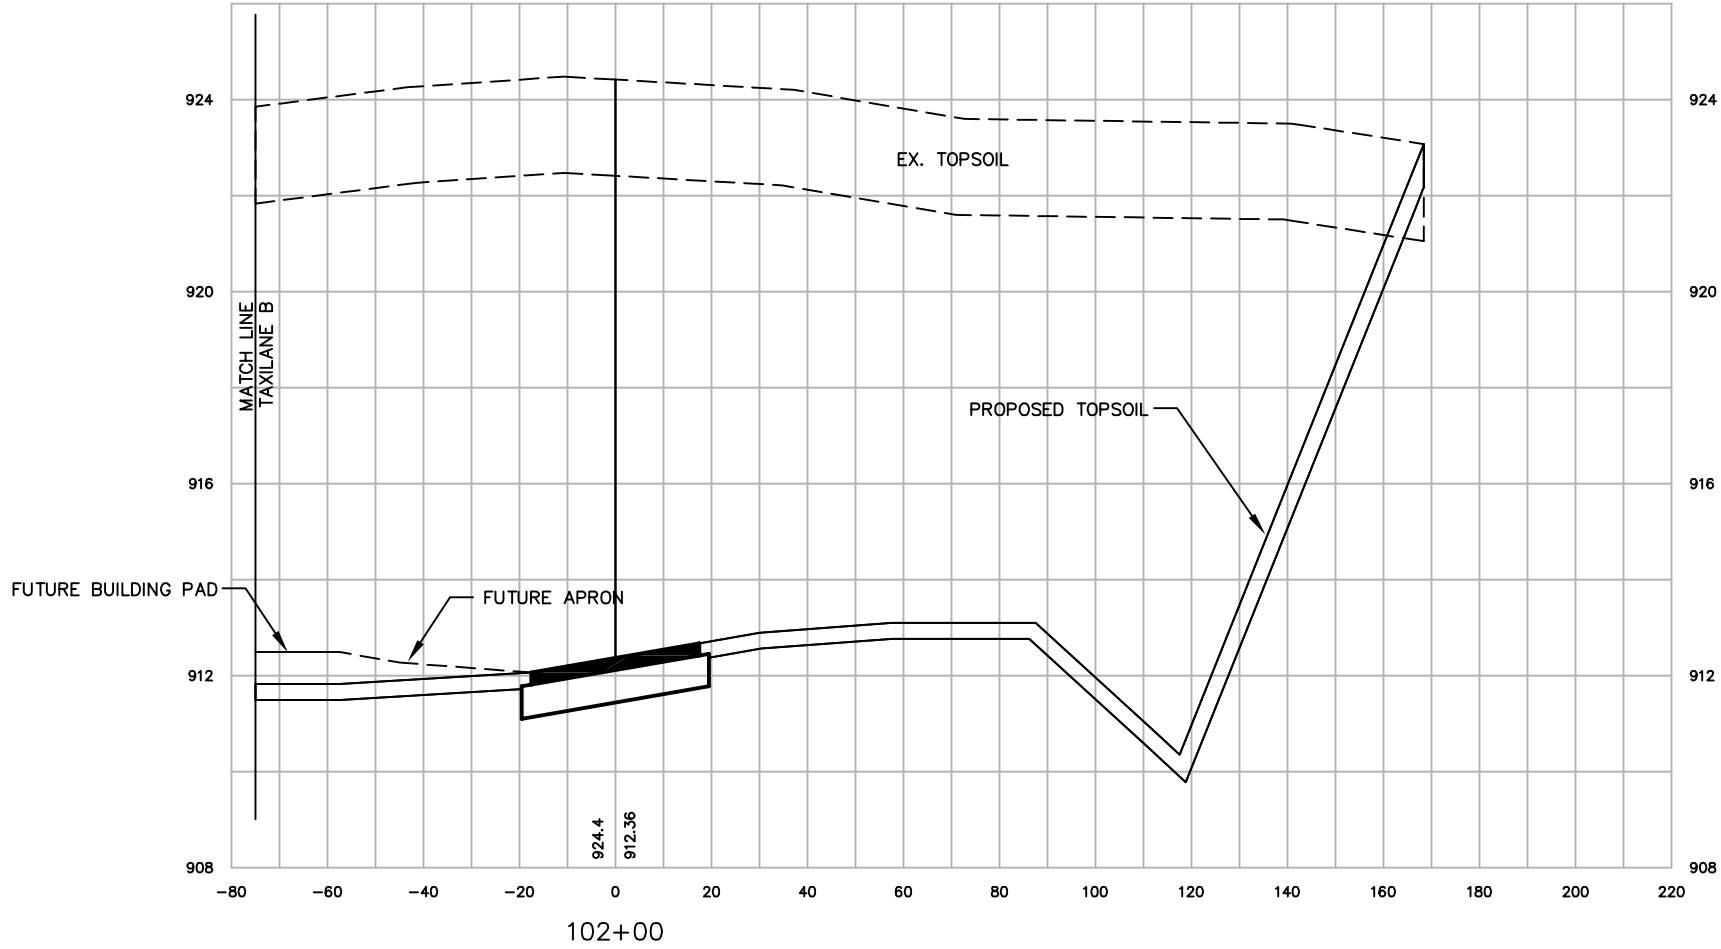


SCALE:
VERT. 1"=4'
HORIZ. 1"=40'

WAUKESHA COUNTY AIRPORT		DATE		\$DATE\$		DESIGNED MJK		DRAWN MJK		CHECKED GAS		NO.		DATE	AS-BUILT	REVISION		INITIAL	
HANGAR AREA														12/08				MJK	
CROSS SECTIONS																			
TAXILANE C																			
A.I.P. PROJECT NO.																			
3-55-0090-22																			
JOB NO.																			
23099-90-04004																			
DWG NO.																			
9004004110.dwg																			
SHEET NO.																			
98 of 130																			



X:\23099-90\06017\tech\cadd\drawings\AS-BUILTS\HANGAR AREA\23099-90-04004 Land Desktop\dwg\23099-90-04004110.dwg


Jan 08, 2009 - 10:42pm

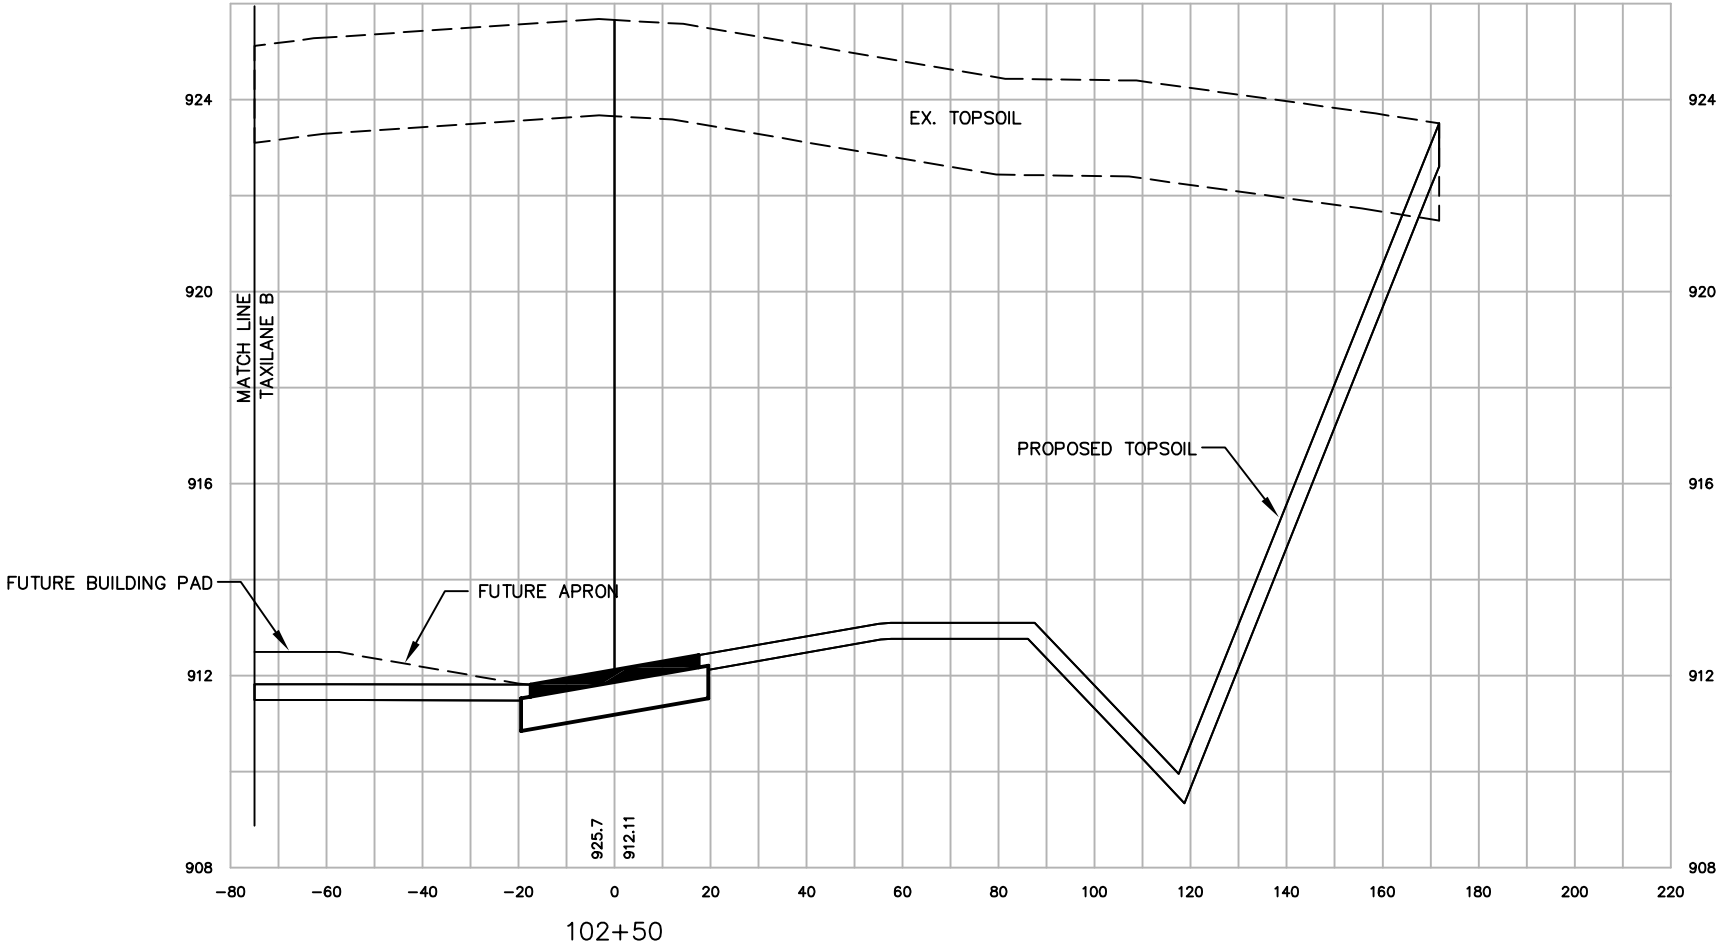

SCALE:
VERT. 1"=4'
HORIZ. 1"=40'

WAUKESHA COUNTY AIRPORT		HANGAR AREA		A.I.P. PROJECT NO.	
CROSS SECTIONS		TAXILANE C		3-55-0090-22	
DATE \$DATE\$		DESIGNED MJK		JOB NO.	
		DRAWN MJK		23099-90-04004	
		CHECKED GAS		DWG NO.	
				9004004110.dwg	
				SHEET NO.	
				99 of 130	
MEAD & HUNT		WAUKESHA COUNTY AIRPORT		NO. DATE	
				12/08	
				AS-BUILT	
				REVISION	
				INITIAL	
				MJK	

X:\23099-90\06017\tech\cadd\drawings\AS-BUILT\HANGAR AREA\23099-90-04004 Land Desktop\dwg\23099-90-04004110.dwg

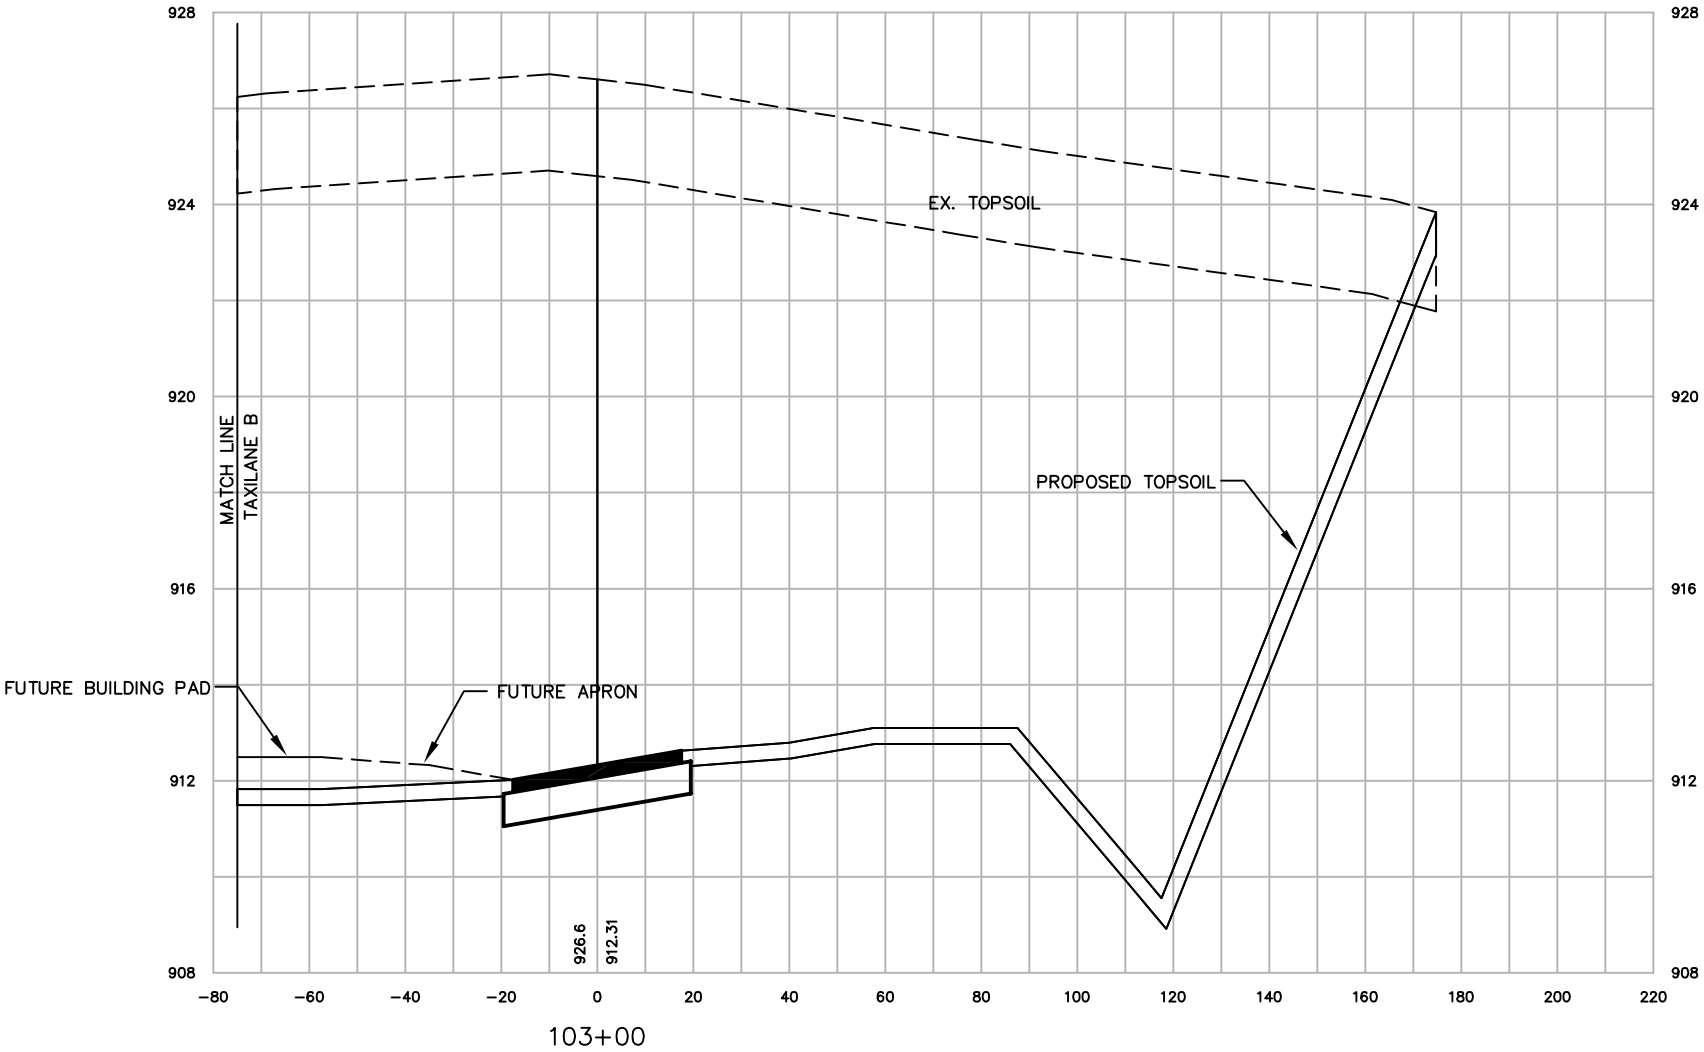


SCALE:
VERT. 1"=4'
HORIZ. 1"=40'

WAUKESHA COUNTY AIRPORT		DATE \$DATE\$		NO. DATE		REVISION		INITIAL	
HANGAR AREA		DESIGNED MJK		12/08		AS-BUILT		MJK	
CROSS SECTIONS		DRAWN MJK							
TAXILANE C		CHECKED GAS							
A.I.P. PROJECT NO.									
3-55-0090-22									
JOB NO.									
23099-90-04004									
DWG NO.									
9004004110.dwg									
SHEET NO.									
100 of 130									



Jan 08, 2009 - 10:43pm

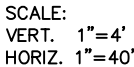MEAD
HUNT

DATE \$DATE\$

DESIGNED MJK

DRAWN MJK

CHECKED GAS

**HANGAR AREA
CROSS SECTIONS
TAXI LANE C**

A.I.P. PROJECT NO
3-55-0090-22


JOB NO.
23099-90-04004

DWG NO.
9004004110.dwg

101 of 130

X:\23099-90\06017\tech\cadd\drawings\AS-BUILT\HANGAR AREA\23099-90-04004 Land Desktop\dwg\23099-90-04004110.dwg


Jan 08, 2009 - 10:43pm

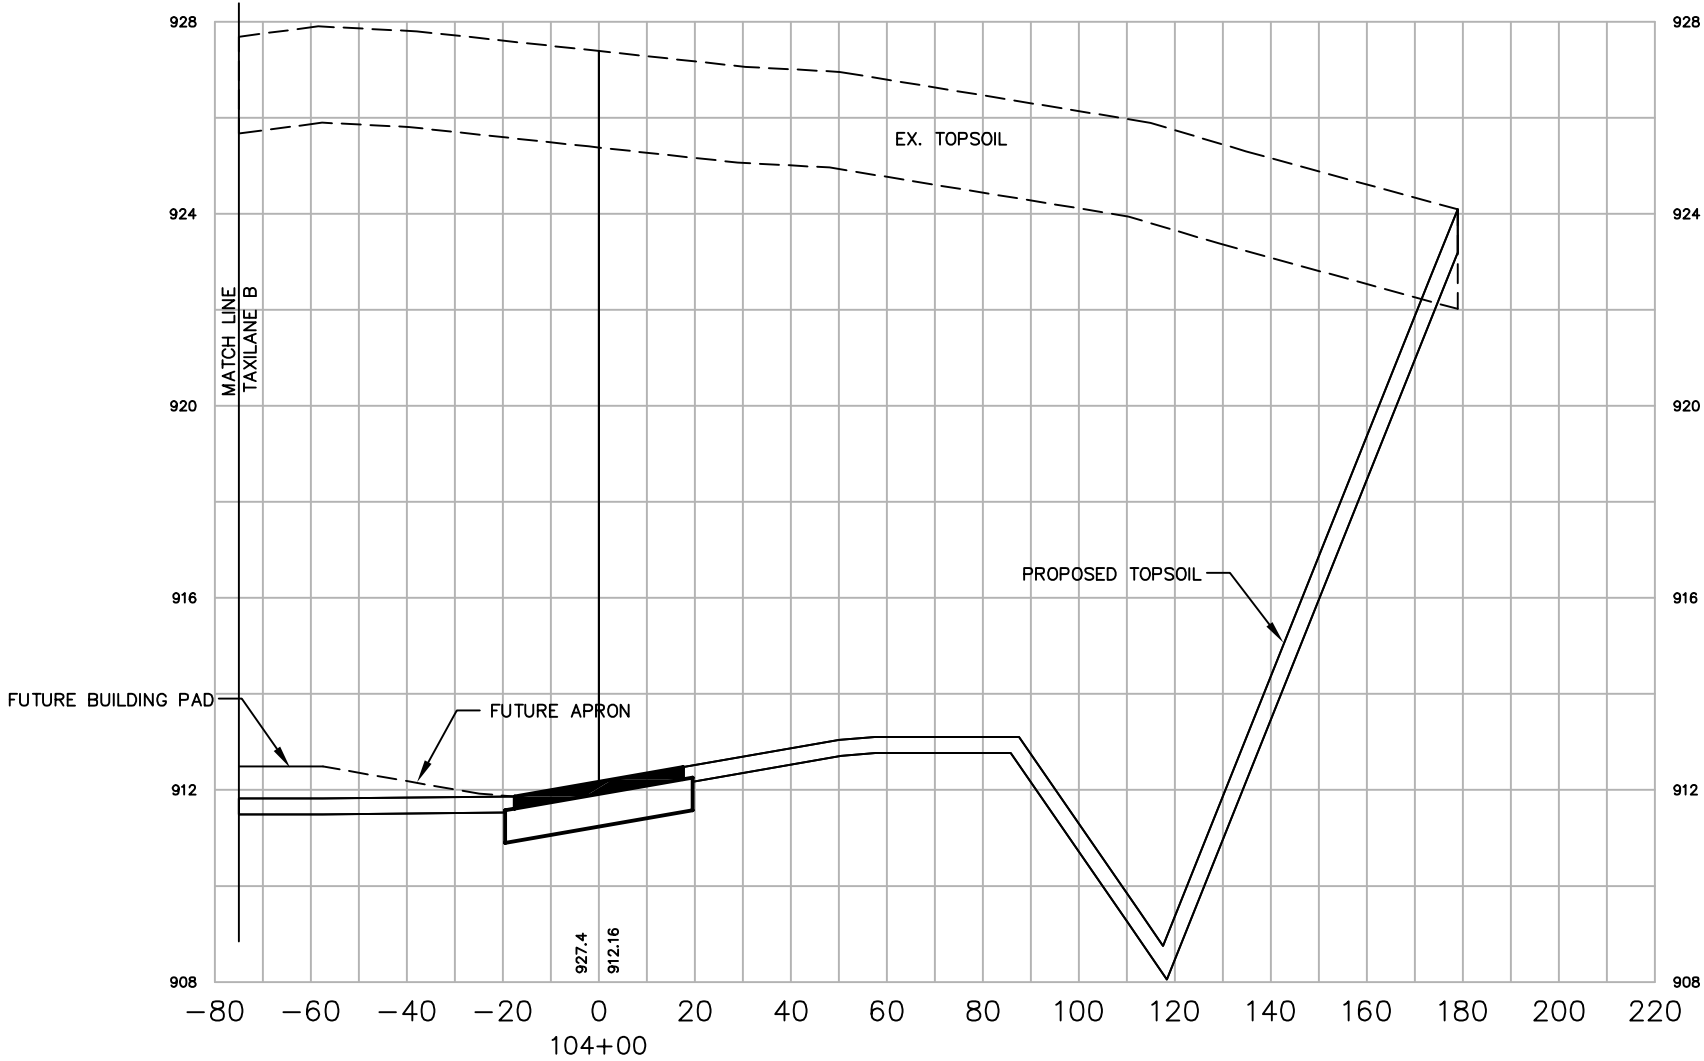

SCALE:
VERT. 1"=4'
HORIZ. 1"=40'


WAUKESHA COUNTY AIRPORT		DATE \$DATE\$		NO. DATE		REVISION		INITIAL	
HANGAR AREA		DESIGNED MJK		12/08				MJK	
CROSS SECTIONS		DRAWN MJK							
TAXILANE C		CHECKED GAS							
A.I.P. PROJECT NO.									
3-55-0090-22									
JOB NO.									
23099-90-04004									
DWG NO.									
9004004110.dwg									
SHEET NO.									
102 of 130									



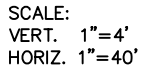


WAUKESHA COUNTY AIRPORT						DATE \$DATE\$ DESIGNED MJK DRAWN MJK CHECKED GAS							
HANGAR AREA CROSS SECTIONS TAXILANE C													
A.I.P. PROJECT NO 3-55-0090-22													
JOB NO. 23099-90-04004													
DWG NO. 9004004110.dwg													
SHEET NO. 103 of 130													

X:\23099-90\06017\tech\cadd\drawings\AS-BUILT\HANGAR AREA\23099-90-04004 Land Desktop\dwg\23099-90-04004110.dwg

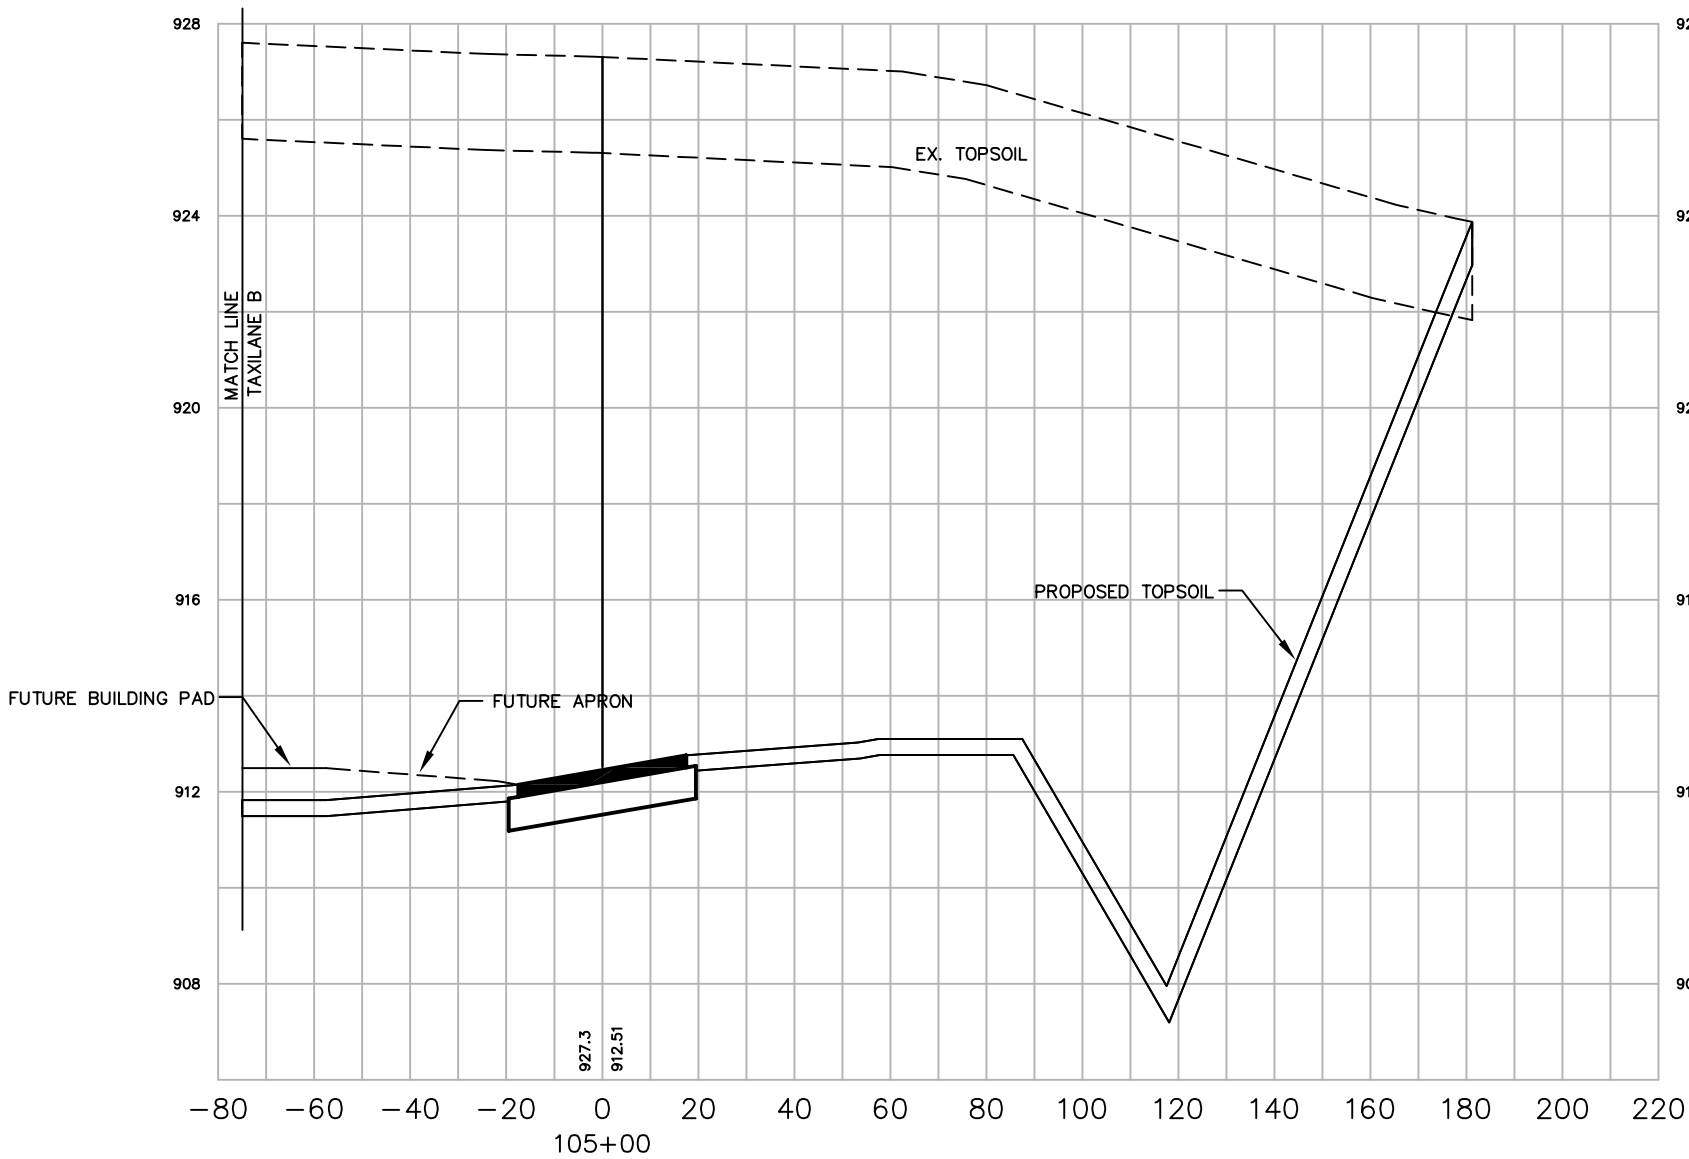


SCALE:
VERT. 1"=4'
HORIZ. 1"=40'

WAUKESHA COUNTY AIRPORT	DATE \$DATE\$	INITIAL
HANGAR AREA	DESIGNED MJK	MJK
CROSS SECTIONS	DRAWN MJK	
TAXILANE C	CHECKED GAS	
A.I.P. PROJECT NO. 3-55-0090-22		
JOB NO. 23099-90-04004		
DWG NO. 9004004110.dwg		
SHEET NO. 104 of 130		

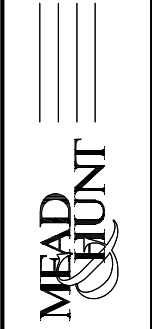

NO.	DATE	REVISION	INITIAL
1	12/08	AS-BUILT	MJK


X:\23099-90\06017\tech\cadd\drawings\AS-BUILT\HANGAR AREA\23099-90-04004 Land Desktop\dwg\23099-90-04004110.dwg

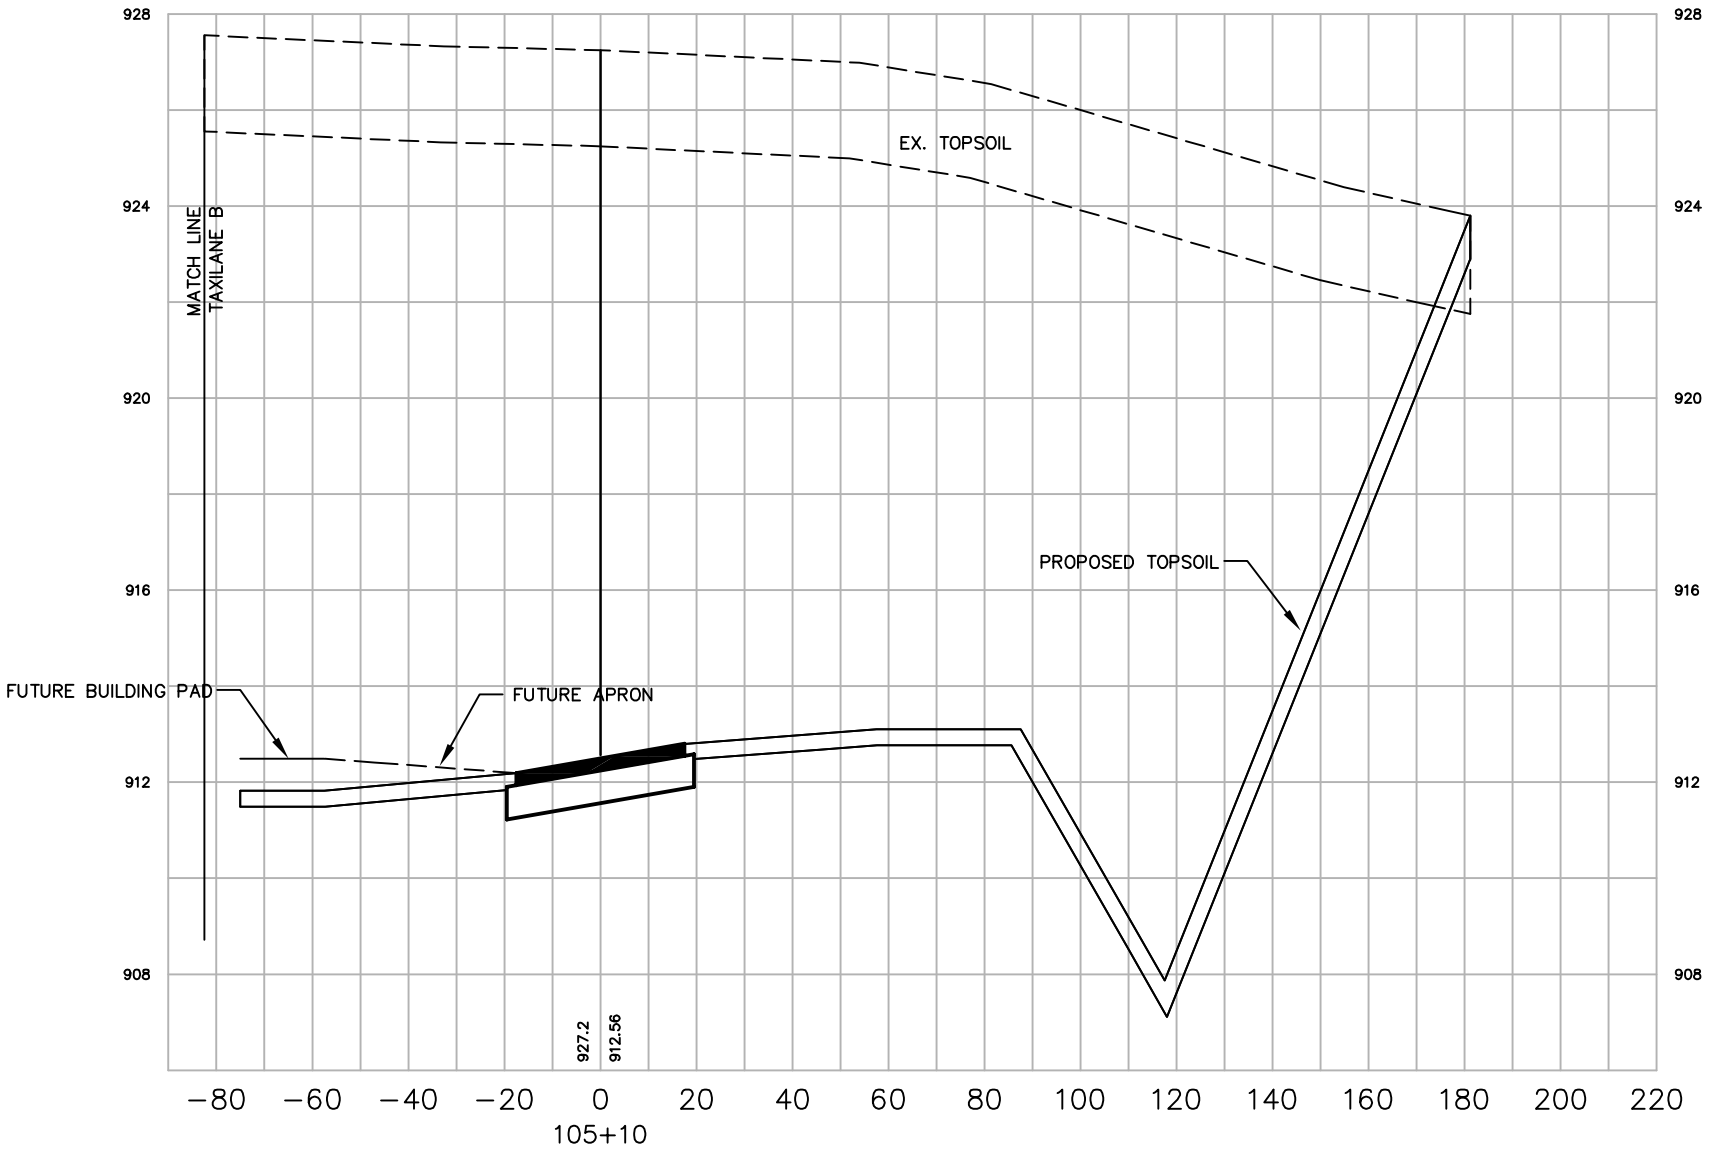

SCALE:
VERT. 1"=4'
HORIZ. 1"=40'

WAUKESHA COUNTY AIRPORT				NO.	DATE	REVISION	INITIAL
HANGAR AREA				12/08			MJK
CROSS SECTIONS				AS-BUILT			
TAXILANE C							
A.I.P. PROJECT NO.							
3-55-0090-22							
JOB NO.							
23099-90-04004							
DWG NO.							
9004004110.dwg							
SHEET NO.							
105 of 130							
DATE \$DATE\$							
DESIGNED MJK							
DRAWN MJK							
CHECKED GAS							
MEAD & HUNT							
WAUKESHA COUNTY AIRPORT							


X:\23099-90\06017\tech\cadd\drawings\AS-BUILT\HANGAR AREA\23099-90-04004 Land Desktop\dwg\23099-90-04004110.dwg

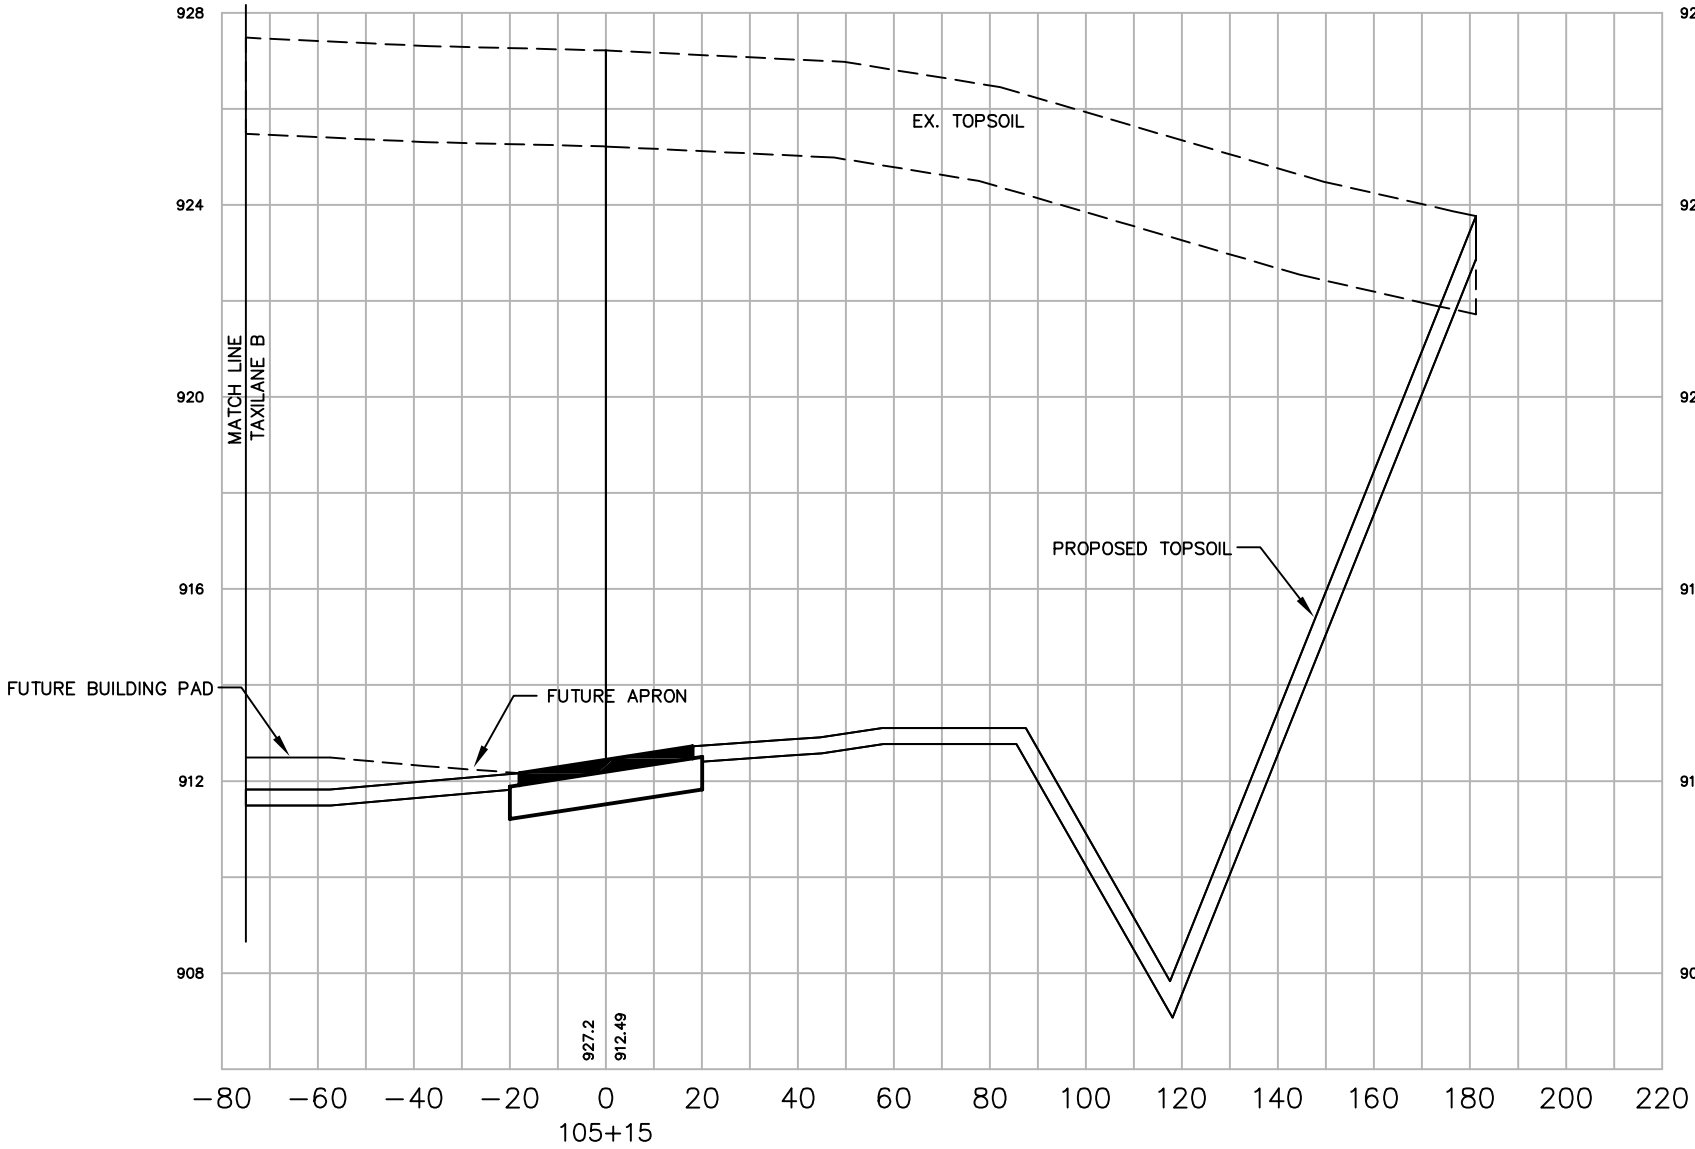

SCALE:
VERT. 1"=4'
HORIZ. 1"=40'














WAUKESHA COUNTY AIRPORT		A.I.P. PROJECT NO. 3-55-0090-22	
HANGAR AREA CROSS SECTIONS TAXILANE C		JOB NO. 23099-90-04004	
DATE \$DATE\$		DWG NO. 9004004110.dwg	
DESIGNED MJK		SHEET NO. 106 of 130	
DRAWN MJK			
CHECKED GAS			
MEAD & HUNT			
WAUKESHA COUNTY AIRPORT			
NO. DATE		REVISION	
12/08		AS-BUILT	
INITIAL		MJK	

X:\23099-90\06017\tech\cadd\drawings\AS-BUILT\HANGAR AREA\23099-90-04004 Land Desktop\dwg\23099-90-04004110.dwg

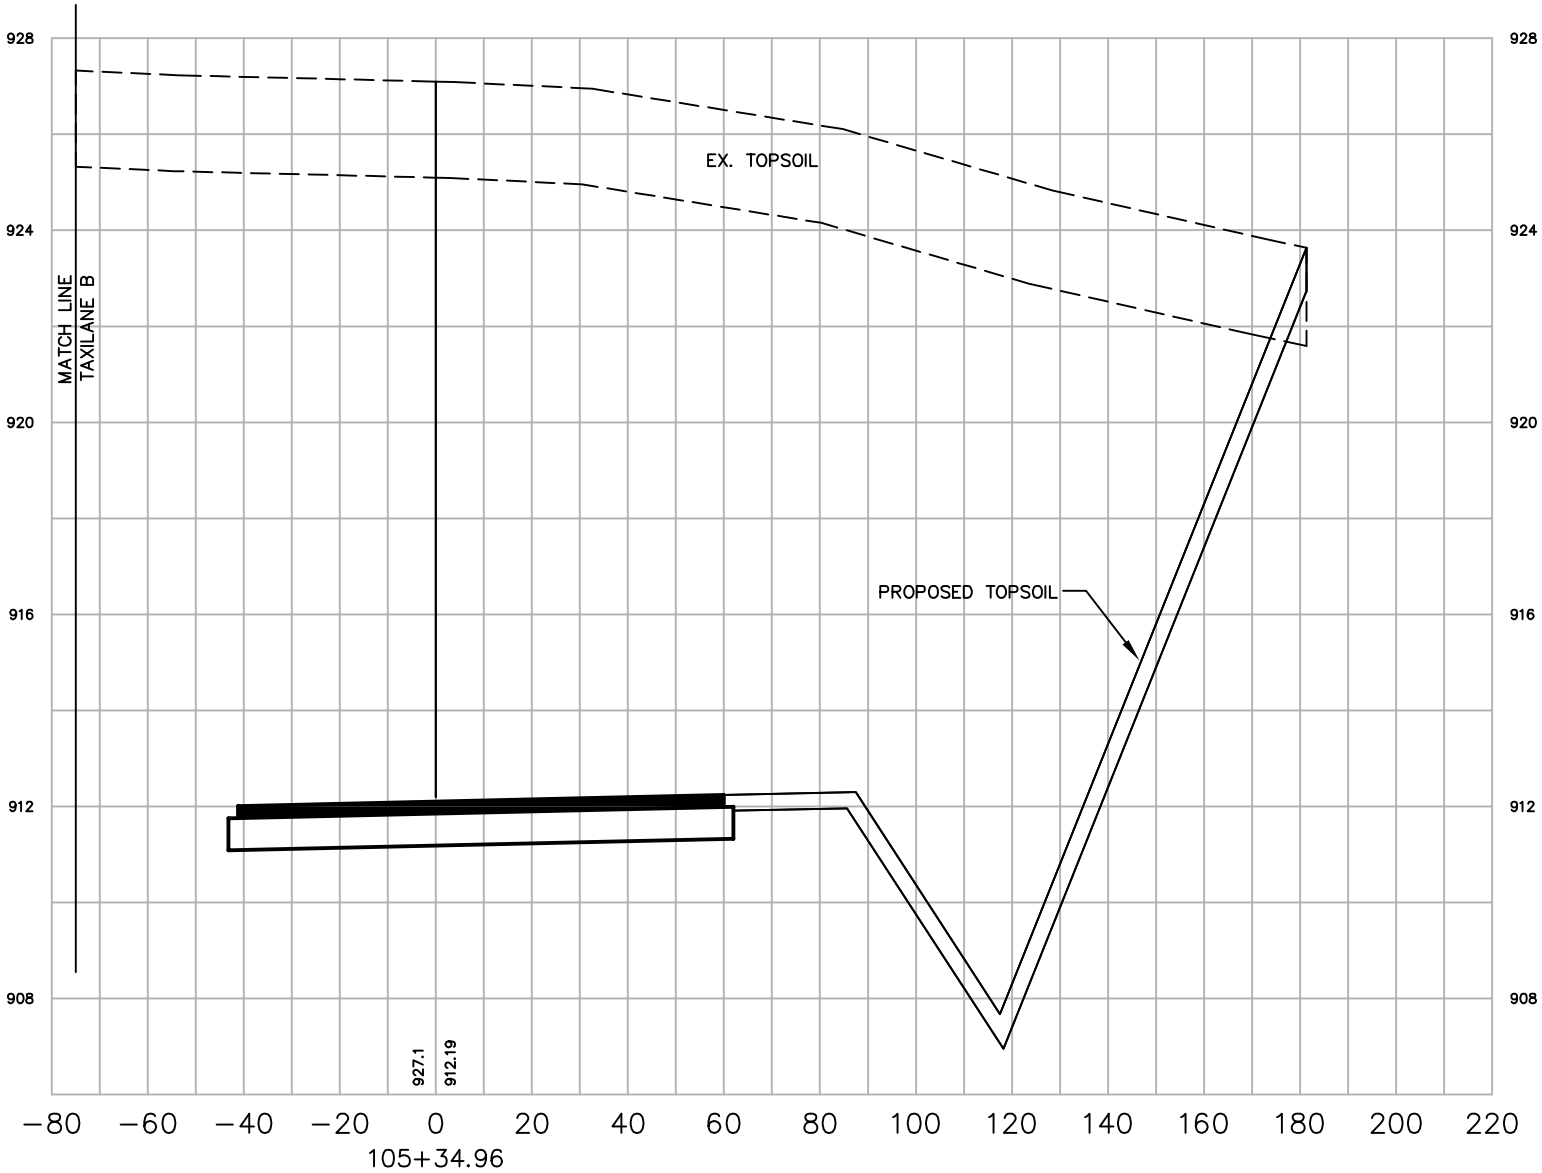

SCALE:
VERT. 1"=4'
HORIZ. 1"=40'

WAUKESHA COUNTY AIRPORT		DATE \$DATE\$		NO. DATE		REVISION		INITIAL	
HANGAR AREA		DESIGNED MJK		12/08				MJK	
CROSS SECTIONS		DRAWN MJK							
TAXILANE C		CHECKED GAS							
A.I.P. PROJECT NO.									
3-55-0090-22									
JOB NO.									
23099-90-04004									
DWG NO.									
9004004110.dwg									
SHEET NO.									
107 of 130									

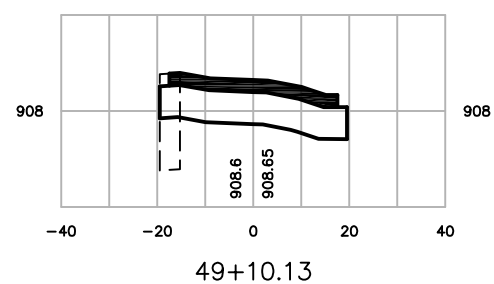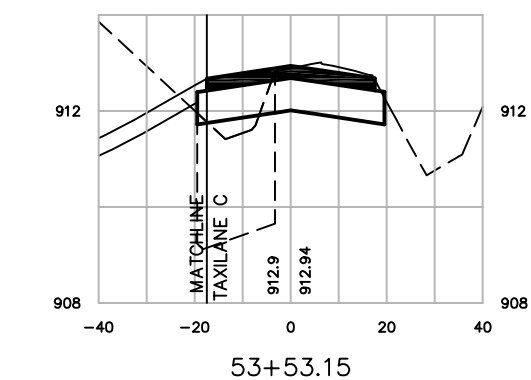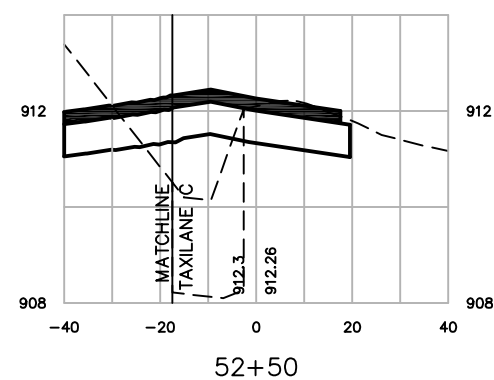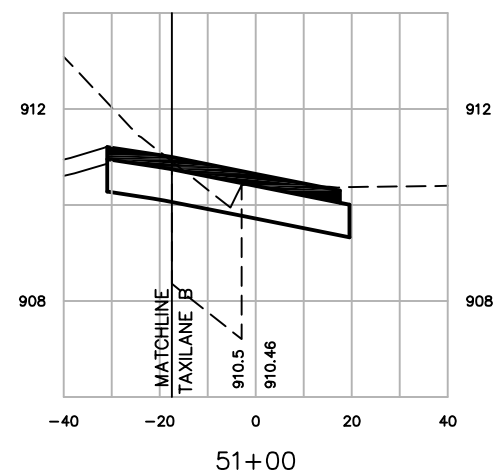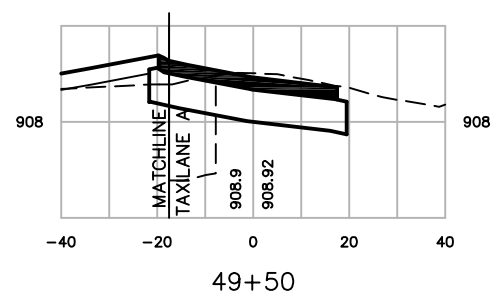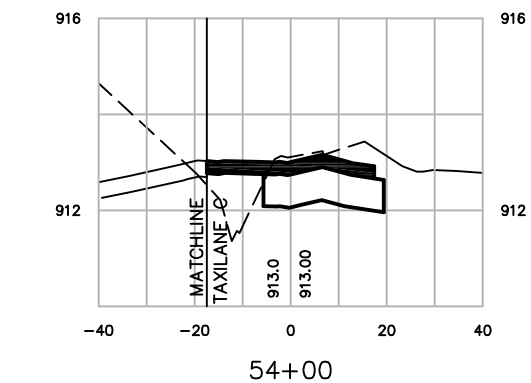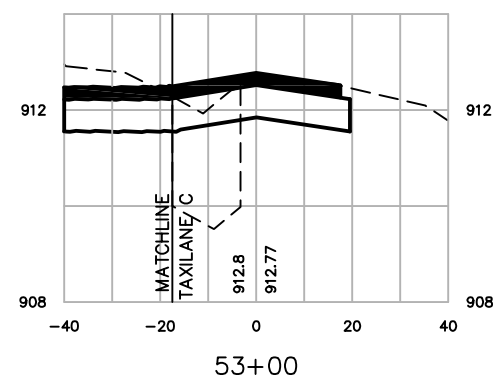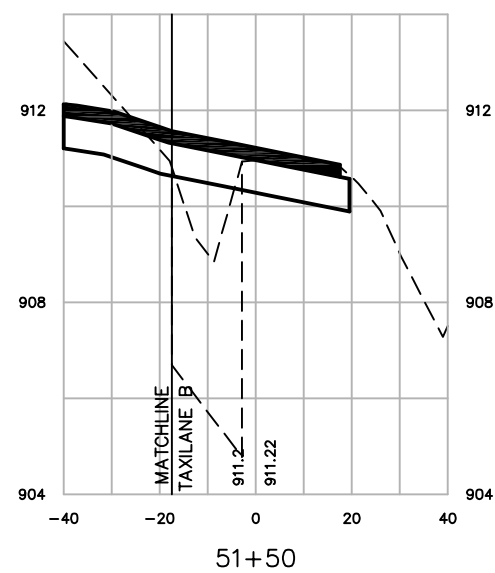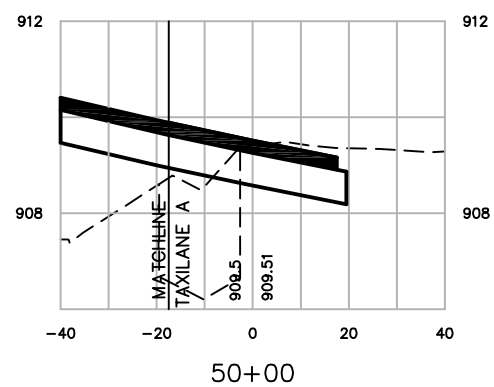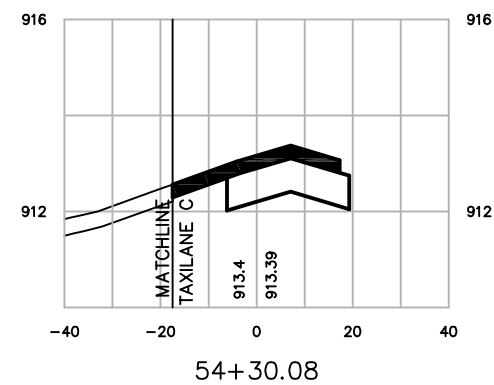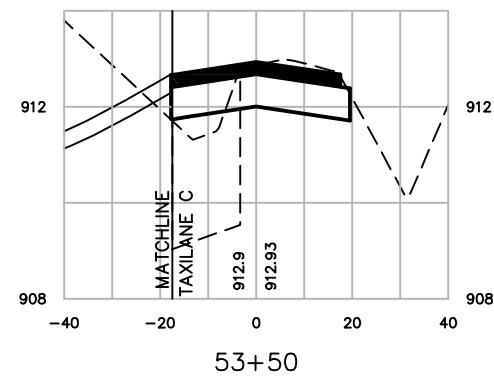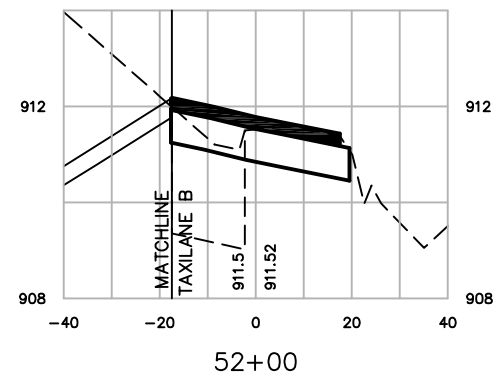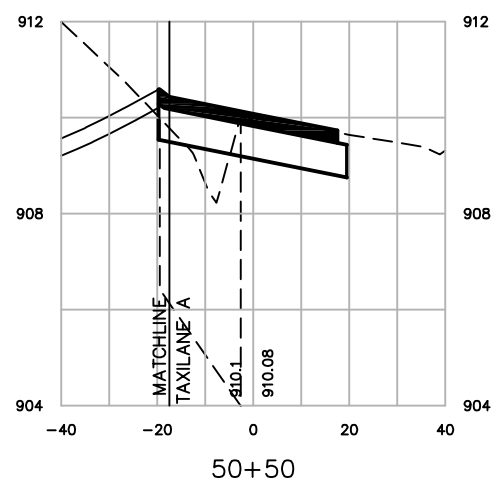

SCALE:
VERT. 1"=4'
HORIZ. 1"=40'

NO.	DATE	REVISION	INITIAL
1	12/08	AS-BUILT	MJK



DATE	\$DATE\$
DESIGNED	MJK
DRAWN	MJK
CHECKED	GAS

WAUKESHA COUNTY AIRPORT





A.I.P. PROJECT N
3-55-0090-22

JOB NO.
23099-90-0400

DWG NO.

9004004111.dwg
SHEET NO.
108 of 130




X:\23099-90\06017\tech\cadd\drawings\AS-BUILTS\HANGAR AREA\23099-90-04004 Land Desktop\dwg\23099-90-04004112.dwg

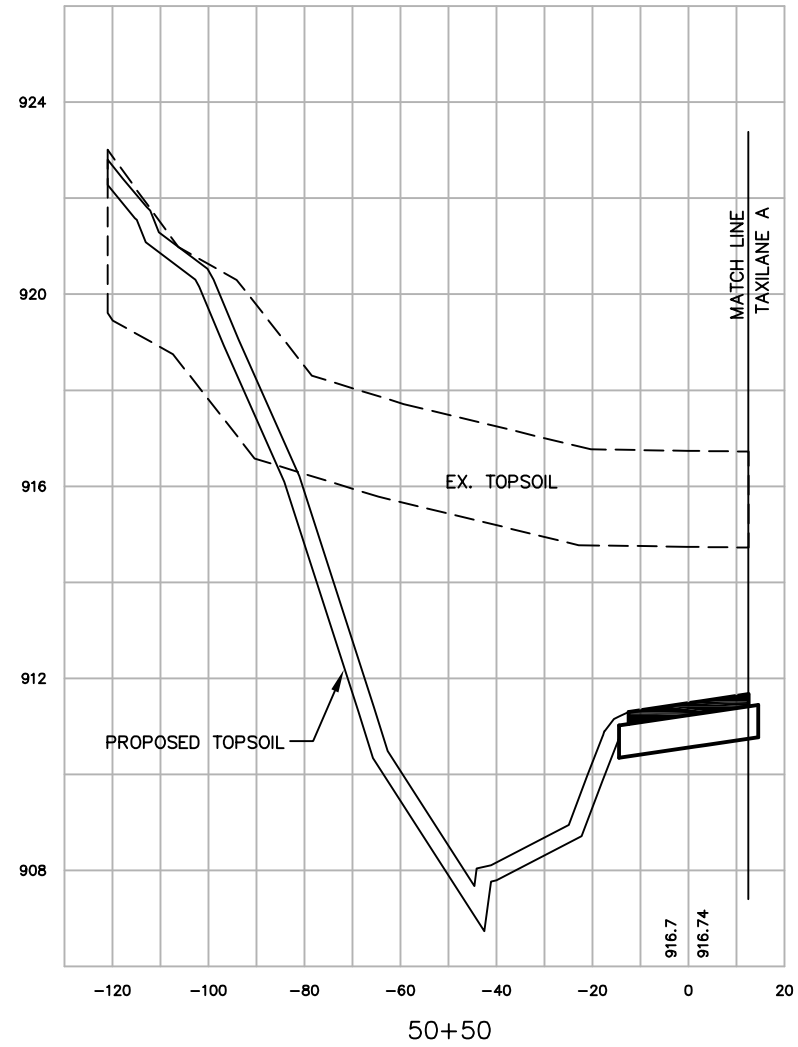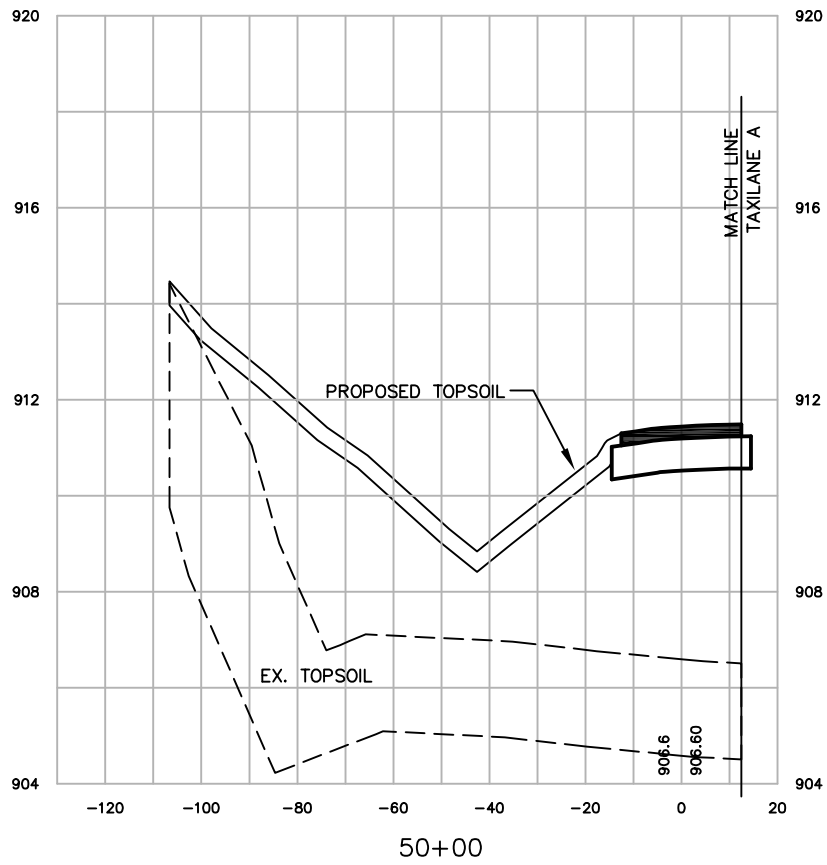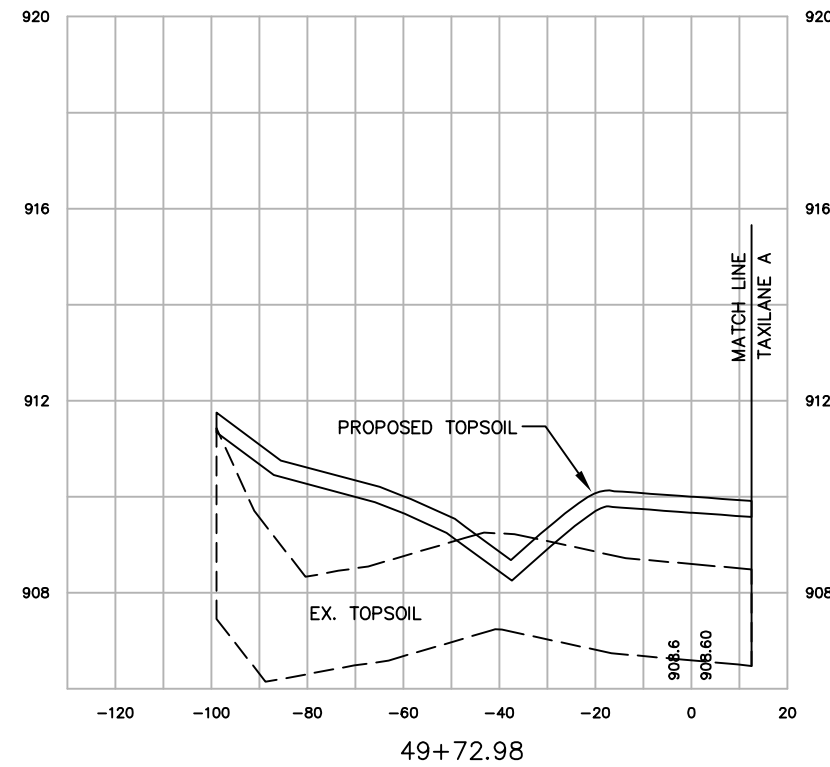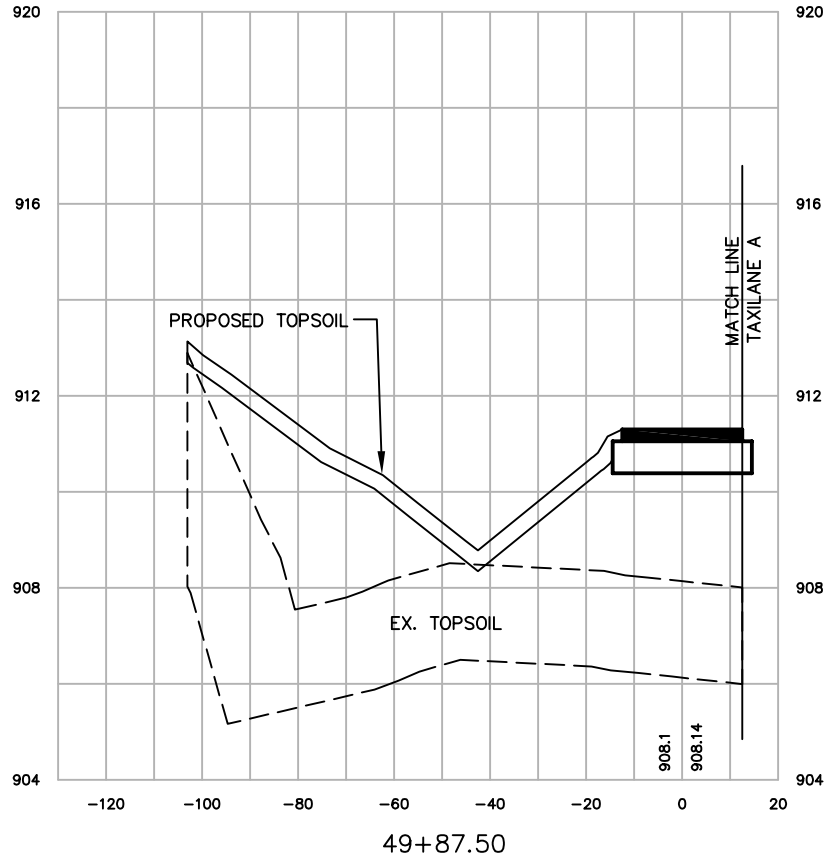

SCALE:
VERT. 1"=4'
HORIZ. 1"=40'

WAUKESHA COUNTY AIRPORT		NO.	DATE	REVISION	INITIAL
HANGAR AREA CROSS SECTIONS ROADWAY W					
A.I.P. PROJECT NO. 3-55-0090-22					
JOB NO. 23099-90-04004					
DWG NO. 9004004112.dwg					
SHEET NO. 109 of 130					
DATE \$DATE\$					
DESIGNED MJK					
DRAWN MJK					
CHECKED GAS					
MEAD & HUNT					
WAUKESHA COUNTY AIRPORT					




X:\23099-90\06017\tech\cadd\drawings\AS-BUILTS\HANGAR AREA\23099-90-04004 Land Desktop\dwg\23099-90-04004112.dwg

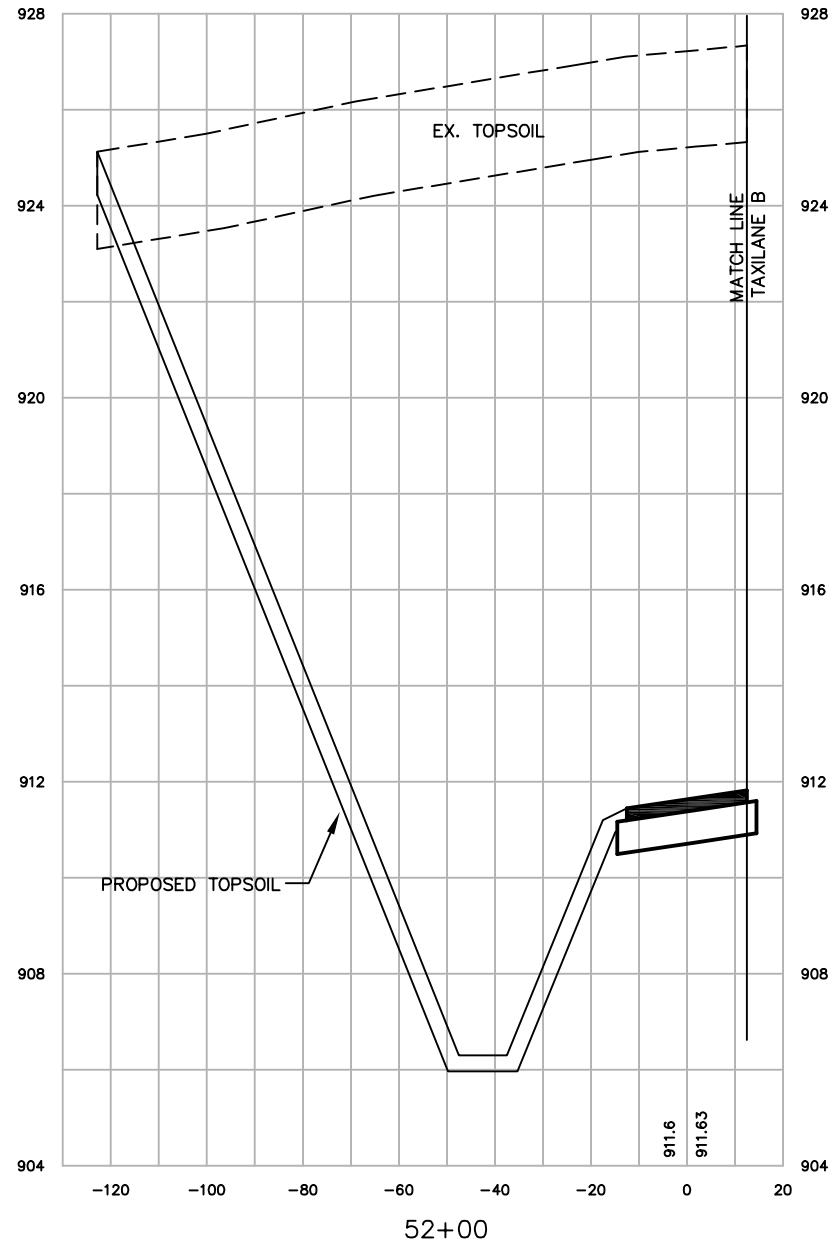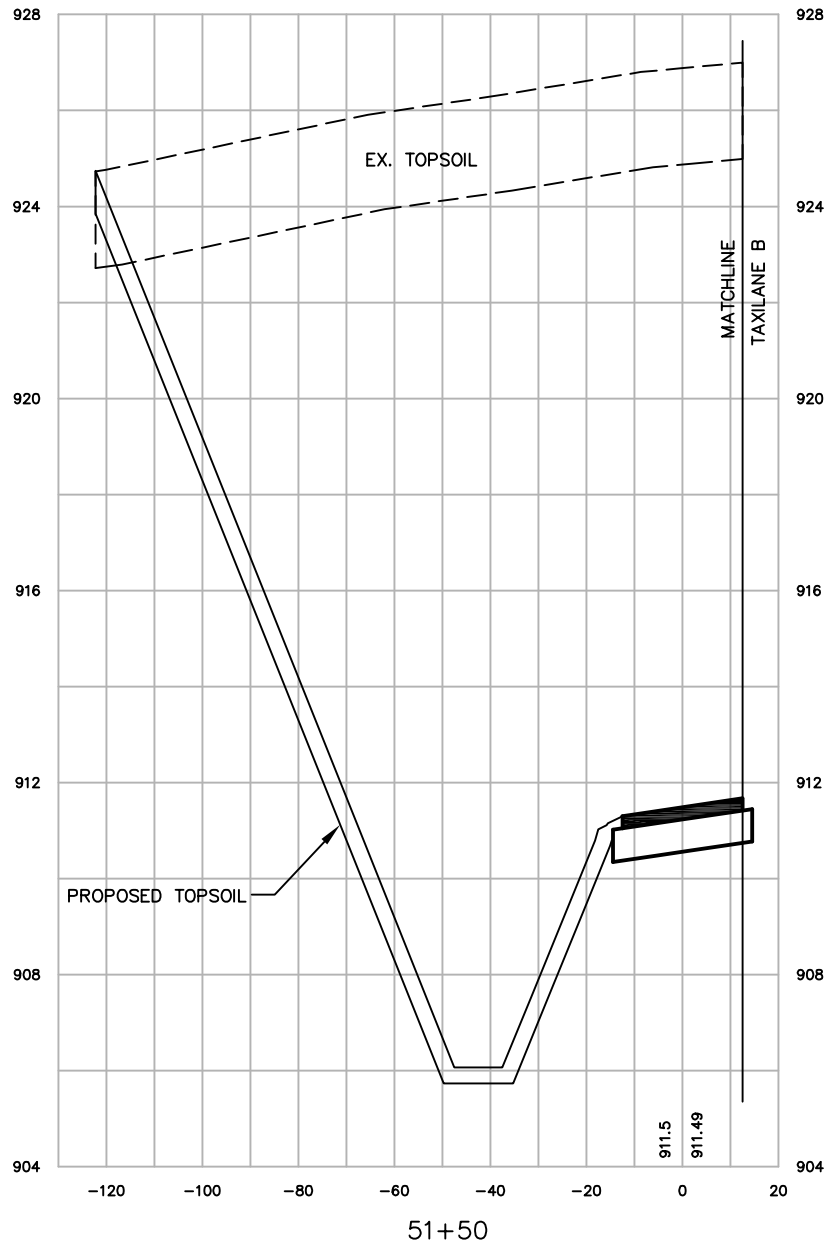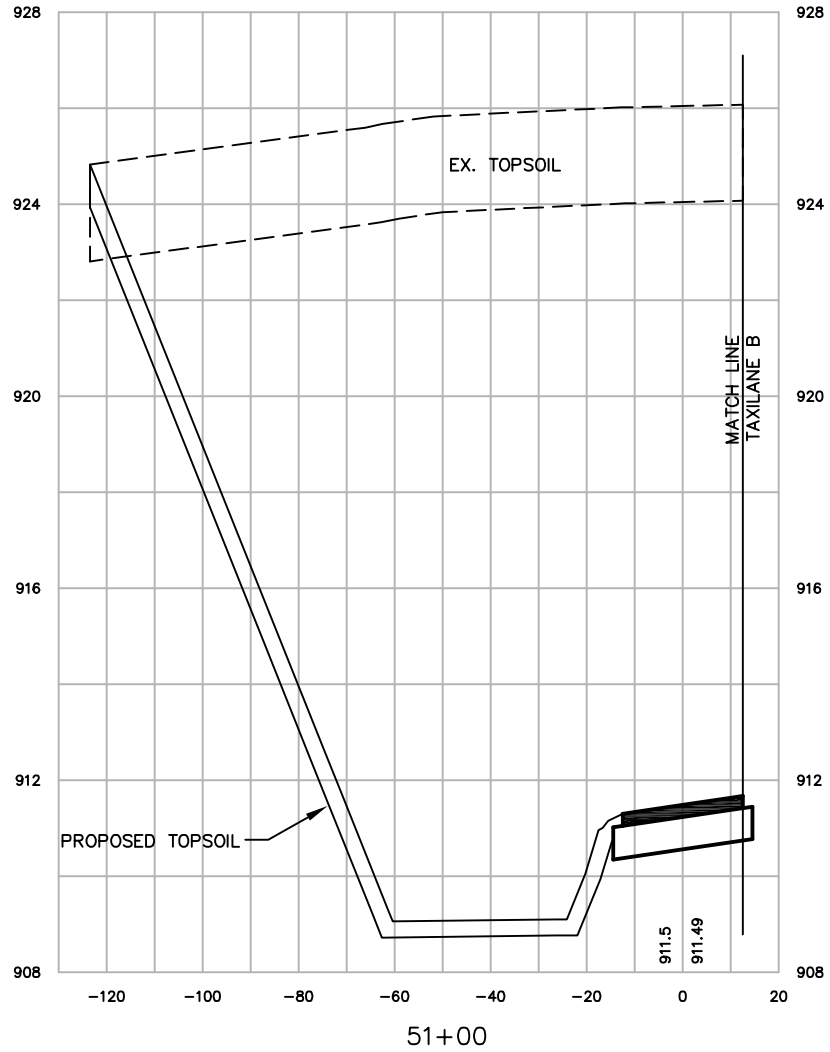

SCALE:
VERT. 1"=4'
HORIZ. 1"=40'

WAUKESHA COUNTY AIRPORT		DATE \$DATE\$		DESIGNED MJK		MEAD HUNT	NO.	DATE	REVISION	INITIAL
HANGAR AREA				DRAWN MJK						
CROSS SECTIONS				CHECKED GAS						
ROADWAY W										
A.I.P. PROJECT NO 3-55-0090-22										
JOB NO. 23099-90-04004										
DWG NO. 9004004112.dwg										
SHEET NO. 110 of 130										





X:\23099-90\06017\tech\cadd\drawings\AS-BUILTS\HANGAR AREA\23099-90-04004 Land Desktop\dwg\23099-90-04004112.dwg

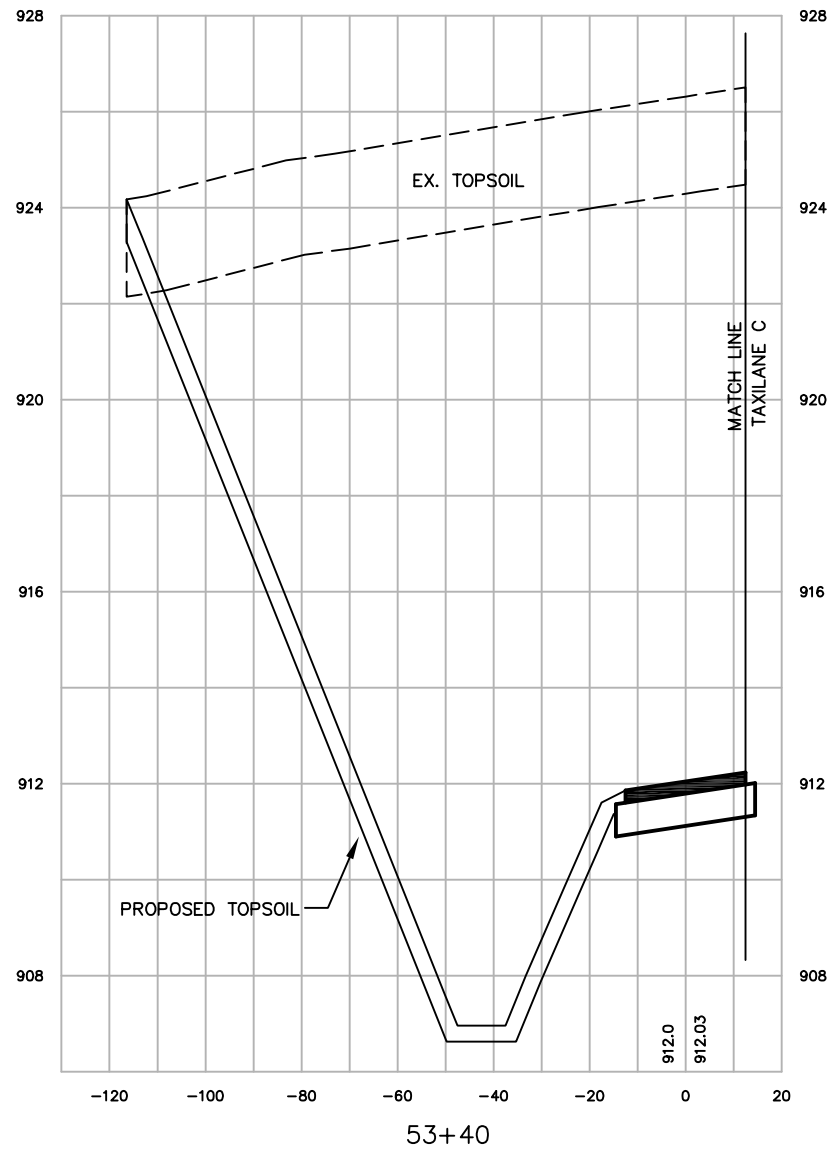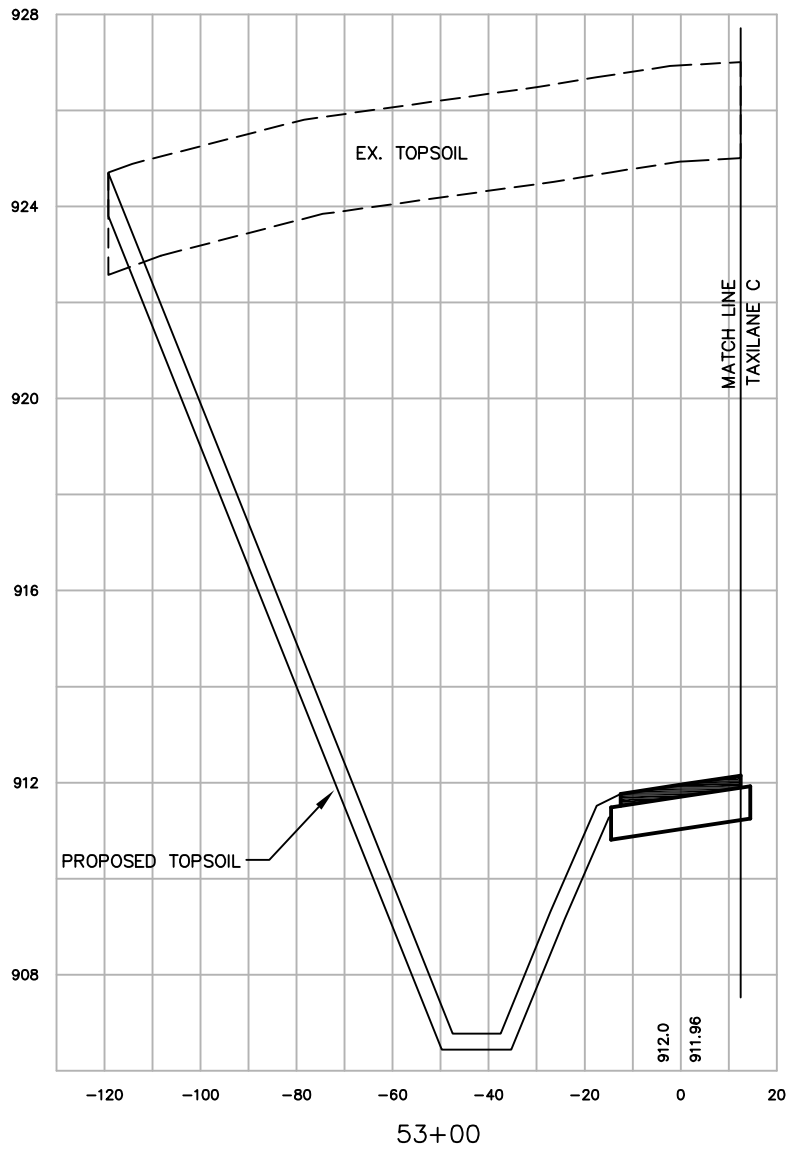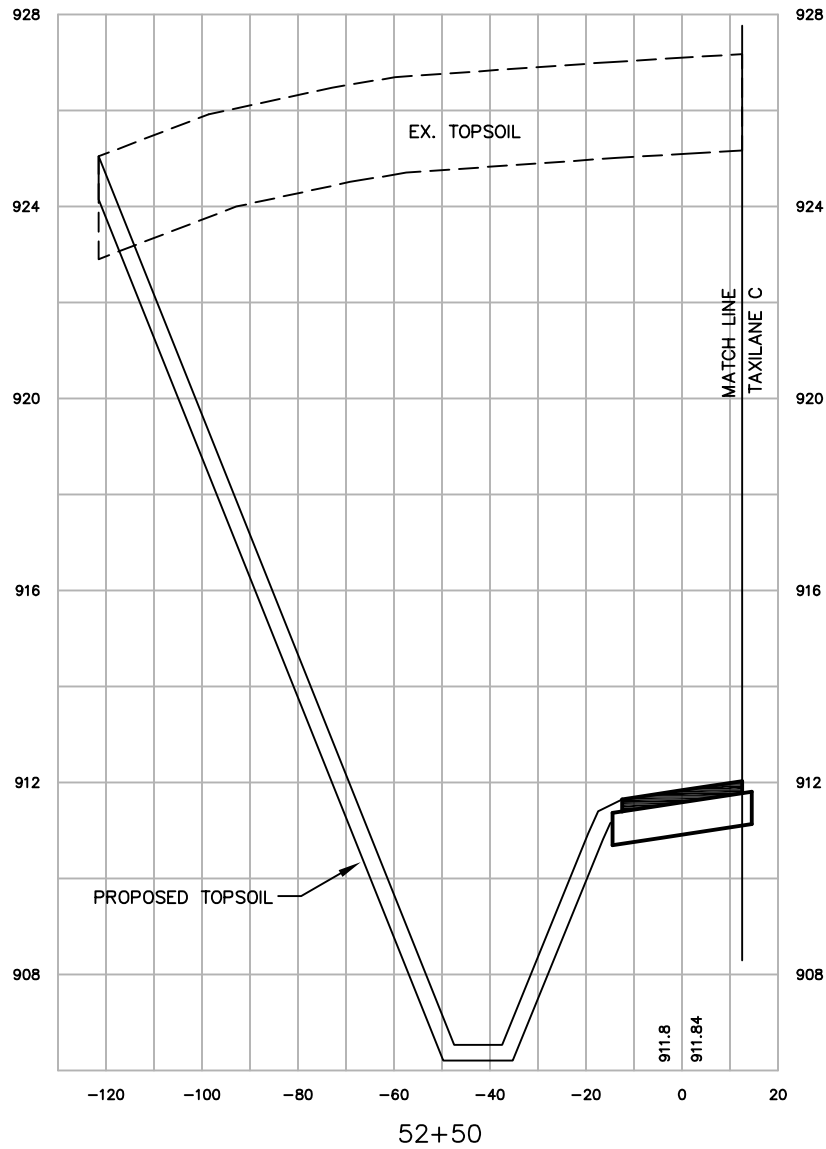

SCALE:
VERT. 1"=4'
HORIZ. 1"=40'

WAUKESHA COUNTY AIRPORT		DATE \$DATE\$		DESIGNED MJK							
				DRAWN MJK							
				CHECKED GAS							
HANGAR AREA											
CROSS SECTIONS											
ROADWAY W											

X:\23099-90\06017\tech\cadd\drawings\AS-BUILTS\HANGAR AREA\23099-90-04004 Land Desktop\dwg\23099-90-04004112.dwg

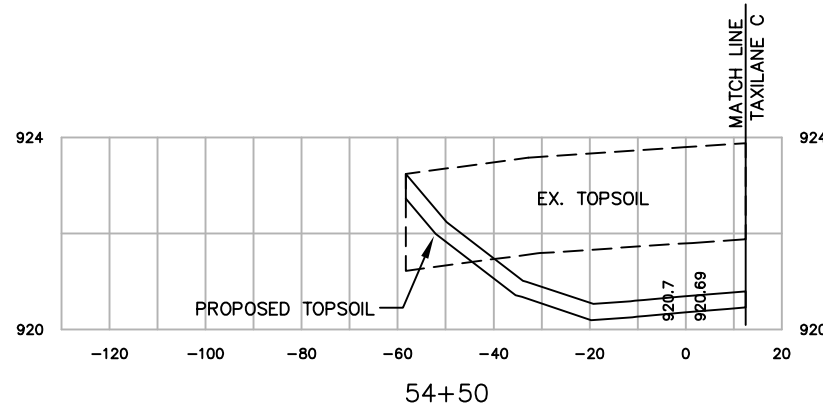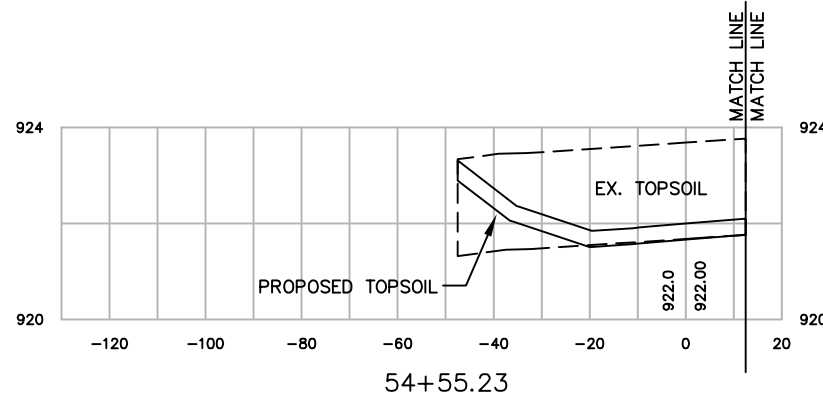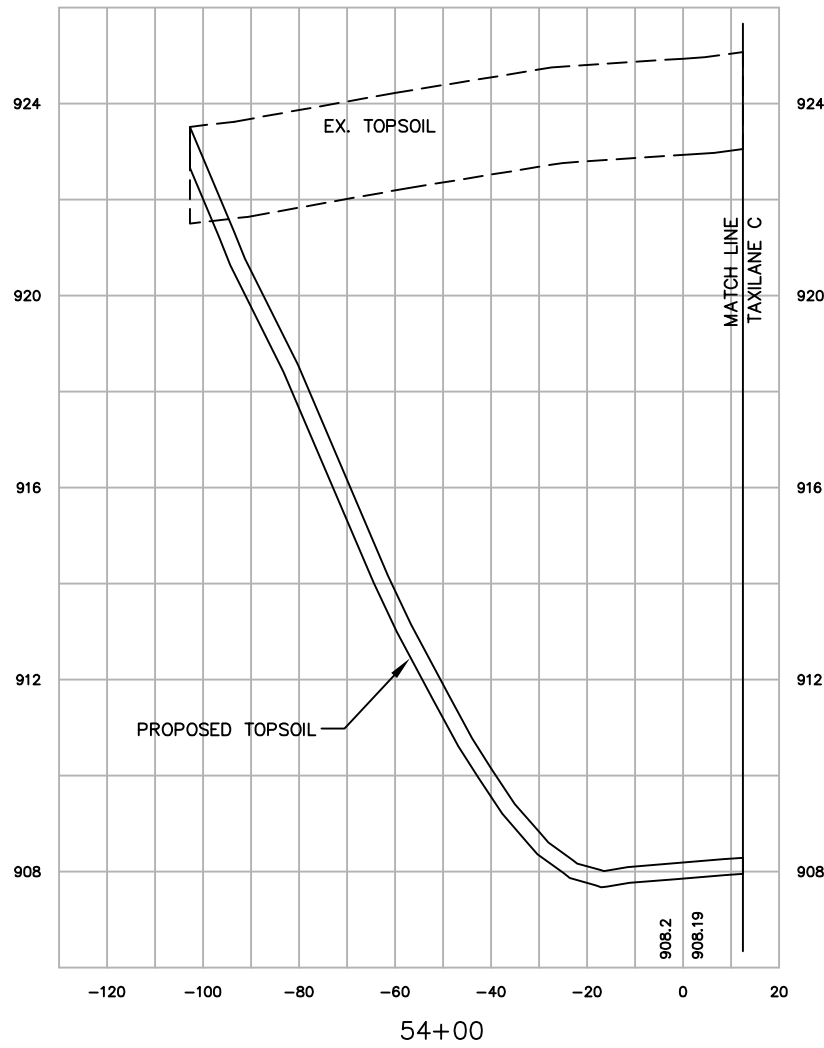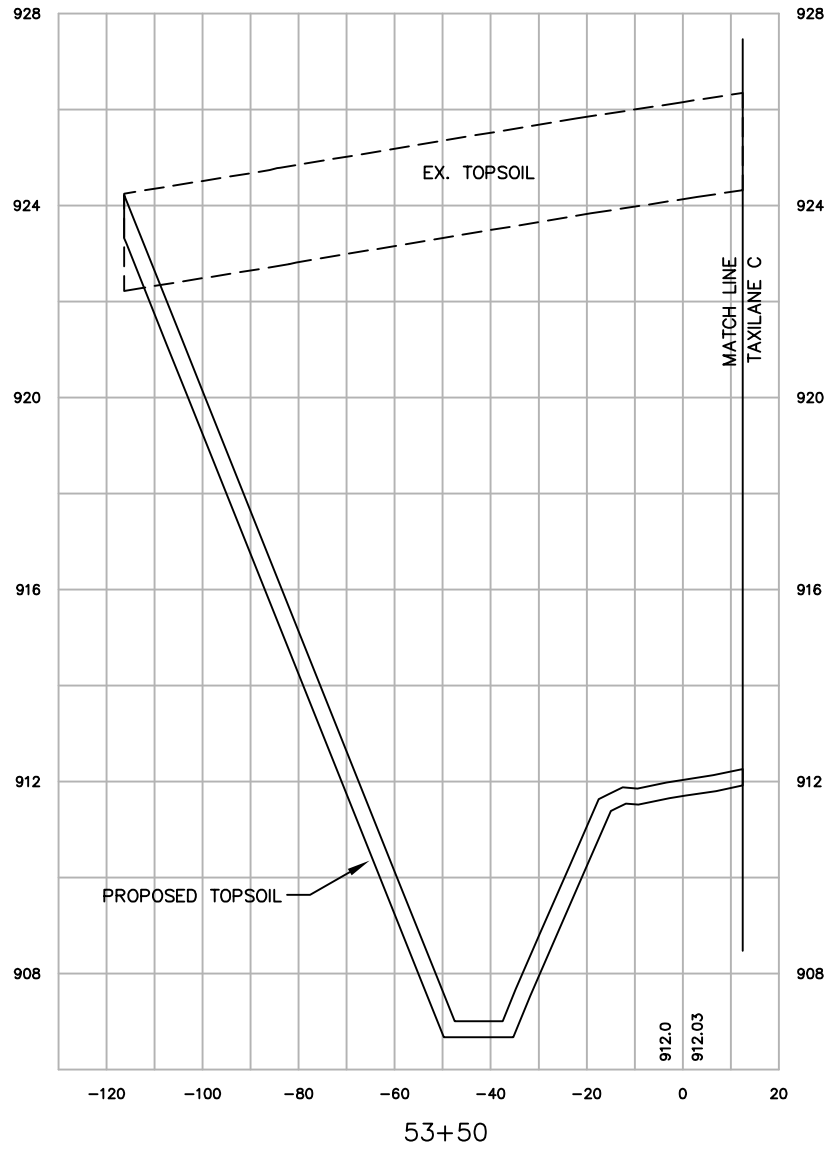

SCALE:
VERT. 1"=4'
HORIZ. 1"=40'

WAUKESHA COUNTY AIRPORT		DATE \$DATE\$		DESIGNED MJK				_____ _____ _____	NO.	DATE	REVISION	INITIAL
HANGAR AREA CROSS SECTIONS ROADWAY W		DRAWN MJK		CHECKED GAS								
A.I.P. PROJECT NO 3-55-0090-22												
JOB NO. 23099-90-04004												
DWG NO. 9004004112.dwg												
SHEET NO. 112 of 130												

