

CITY OF WAUKESHA, WISCONSIN

201 DELAFIELD STREET * ROOM 200 * WAUKESHA, WI 53188 * PH: (262)524-3750 * FAX: (262)524-3751

PERMIT NUMBER

PERMANENT SIGN PERMIT APPLICATION

ONE APPLICATION PER SIGN

SITE ADDRESS: 2120 E Moreland BlvdTotal Number of signs applying for today: 1 Value of Sign(s) \$ _____FEE: \$40 min. or \$1 per sq. ft. Required in full at time of submittal. **FEE IS NON-REFUNDABLE.**Location of THIS sign: Tenant Wall Sign

Office Use Only

☐ PICTURE/Drawing/Site Plan☐ FEE☐ ELECTRICAL PERMIT

Paid: _____ Initials: _____

Permit copy will be mailed to this address

Business Name: CricketSign Contractor: M. Owest Sign & Lighting, IncOwner Name: Suker & SonsAddress: PO 100045

Business Phone: _____

City/State/Zip: Milw, WI 53210For questions call: ☐ Business ☒ Sign ContractorPhone: 414/447-8227

Rich Kos @ m.owestsignandlighting.com

IF THIS IS AREA IS LEFT EMPTY, PERMIT WILL NOT BE MAILED.

(MANDATORY FIELD; application will be returned if left blank.)

You must submit an electrical permit signed by a licensed electrician with all illuminated sign permit applications.

HAS THIS BEEN DONE? ☐ YES, Permit No. BL- _____ ☐ NO ☐ NOT APPLICABLE**ATTACH A COLOR PHOTO, DRAWING, AND/OR SITE PLAN.** Show dimensions to scale, colors, and location of sign.

CHECK ONE:

☐ New Sign ☐ Existing Sign ☒ Face Change Only

TYPE OF SIGN (Circle all that apply):

☒ Wall ☐ Door ☐ Projecting ☐ Window ☐ Roof ☐ Billboard
☐ Flat ☐ Awning ☐ Freestanding ☐ Yard ☐ Double FaceHorizontal Width of Sign 12' Vertical dimension of Sign 3' TOTAL Square Footage: 36 sq. ft.

If Sign is detached or projecting, please supply: Total Height _____ Clearance: _____ Setback: _____

Premise Data: Street Frontage: _____ Building or Tenant Space Width: 22' Other Street Frontage: _____**PLEASE LIST ALL EXISTING SIGNAGE ON THE BACK OF THIS SHEET.**

By my signature, I state and agree, that I have carefully examined the completed application and do hereby certify that all information herein is true and correct, and I further certify that any and all work performed shall be done in accordance with the Ordinances of the City of Waukesha, and the Laws of the State of Wisconsin pertaining to the work described herein

Legal Signature [Signature] Print Name Richard Kos Date 8/3/17

OFFICE USE ONLY

Zoning District: _____ Gross sign area for premises: _____ Area used by other signs: _____

☐ Approved Conditions (if any):☐ Must submit electrical permit within 30 days of meeting or permit shall be voided.☐ Denied Does not conform to:☐ Height ☐ Architecturally compatible ☐ Not to face R-district ☐ Clearance ☐ Area ☐ Corner Vision
☐ Projection ☐ Avoid needless elaboration ☐ Consolidation of signs ☐ Distracting sign ☐ Setback ☐ Other

Authorized Signature _____

Date of Review _____

INCOMPLETE APPLICATIONS MAY NOT BE PROCESSED.Review Board meets the 3rd Monday of the month at 8:15 am. DEADLINE IS THE MONDAY BEFORE THE MEETING.

Exterior Site Plan | Summary



Sign	Existing Sign	SF	Recommended Sign	SF
N-01	No Existing	N/A	Tenant Panel	36
N-02	No Existing		AR-DV-SD Transom Bar Hours of Operation	

 



2035 Lakeside Centre Way Suite 250 Knoxville, TN 37922 T+865 692 4058 F+865 692 4104		Revision notes:				Client: Cricket NR1 Project: AS Built Title: TBD Date: 07.10.2017	Drawn by: EBD Checked by: - Scale: NTS Revision: 2 Page: 2
--	--	-----------------	--	--------------	--	---	---

principle




3M #7725-10 Opaque White
film applied first surface

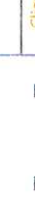   		2035 Lakeside Centre Way Suite 250 Knoxville, TN 37922 F+865 692 4104 T+865 692 4058																					
Copyright © 2014 by Cricket. All rights reserved. All trademarks are the property of their respective owners. All other trademarks are the property of their respective owners. All rights reserved.		Revision notes:																					
		<table border="1"> <tr> <td>Client:</td> <td>Cricket NRI</td> <td>Drawn by:</td> <td>EBD</td> </tr> <tr> <td>Project:</td> <td>As Built</td> <td>Checked by:</td> <td>-</td> </tr> <tr> <td>Title:</td> <td>TBD</td> <td>Scale:</td> <td>N/T'S</td> </tr> <tr> <td>Date:</td> <td>07.10.2017</td> <td>Revision:</td> <td>2</td> </tr> <tr> <td></td> <td></td> <td>Page:</td> <td>4</td> </tr> </table>		Client:	Cricket NRI	Drawn by:	EBD	Project:	As Built	Checked by:	-	Title:	TBD	Scale:	N/T'S	Date:	07.10.2017	Revision:	2			Page:	4
Client:	Cricket NRI	Drawn by:	EBD																				
Project:	As Built	Checked by:	-																				
Title:	TBD	Scale:	N/T'S																				
Date:	07.10.2017	Revision:	2																				
		Page:	4																				

Exterior Site Plan | Logo Vinyl with Store Hours



AB-DV-SDTB

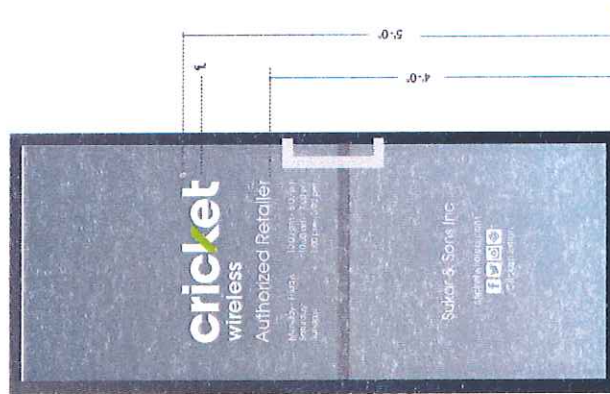


Approved layout

Typography:

ITC Avant Garde Std 8k Light
- standard font for store hours

N-02

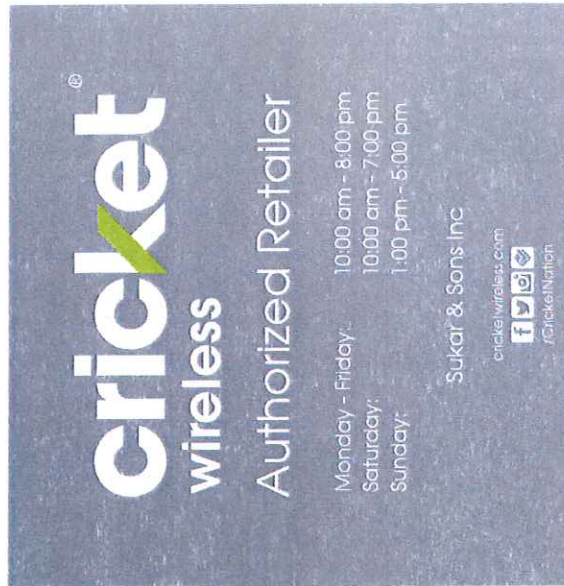

For visual reference only - not an approved layout
Color Specifications

3M #7725-10 Opaque White
film applied first surface

3M #180C-196 Apple Green
film applied first surface

Revision notes:

©2010 Sukar & Sons Inc. All rights reserved. This document is for internal use only and should not be distributed outside of the company. It is the property of Sukar & Sons Inc. and all rights are reserved. No part of this document may be reproduced without written permission from Sukar & Sons Inc.



2035 Lakeside Centre Way Suite 250
Knoxville, TN 37922
T+865 692 4058 F+865 692 4104

cricket

Client:	Cricket NR1	Drawn by:	EBD
Project:	As Built	Checked by:	-
Title:	TBD	Scale:	NTS
Date:	07.10.2017	Revision:	2
		Page:	5

cricket

principle

UID: 70232428

Client: Cricket - NP1

Project: BAU

Title: Exterior Signage

Site address: 2120 E Moreland Blvd
Waukesha, WI

Project manager: Kyle Erickson

Drawn by: EBD

Date: 07/10/17

Revision: 2

As the Owner/Lessor/Mortgage or Security interest holder, I hereby acknowledge and accept the installation of signs as illustrated within the renderings shown within this brand proposal. By signing below I consent to the installation of signs at the premises and property address listed within this brand proposal and acknowledge that I have reviewed all details of this brand proposal in its entirety.

Signature of (Owner/Lessor/Mortgage or Security interest Holder)

Print Name

7/10/17

Date



NOTE: Quote does not include removal of any existing signage, patching or painting of the existing facade. Cricket requires that any existing signs be removed and that facade is patched and painted by the dealer, or landlord to match the color of existing fascia prior to the new Cricket signs being installed by Principle USA Inc. Please contact your Field Activity Manager if you would like Principle to quote removal of any existing signage, or patching and painting of the facade.



UID: 70232428

Client: Cricket - NR1

Project: BAU

Title: Exterior Signage

Site address: 2120 E Moreland Blvd
Waukesha, WI

Project manager: Kyle Ericksen

Drawn by: EBD

Date: 07/10/17

Revision: 2

As the Owner/Lessor/Mortgage or Security interest holder, I hereby acknowledge and accept the installation of signs as illustrated within the renderings shown within this brand proposal. By signing below I consent to the installation of signs at the premises and property address listed within this brand proposal and acknowledge that I have reviewed all details of this brand proposal in its entirety.

Signature of (Owner/Lessor/Mortgage or Security Interest Holder)

Print Name

Date



NOTE: Quote does not include removal of any existing signage, patching or painting of the existing facade. Cricket requires that any existing signs be removed and that facade is patched and painted by the dealer, or landlord to match the color of existing fascia prior to the new Cricket signs being installed by Principle USA Inc. Please contact your Field Activity Manager if you would like Principle to quote removal of any existing signage, or patching and painting of the facade.