

NOI Service

CITY OF WAUKESHA, WISCONSIN

201 DELAFIELD STREET * ROOM 200 * WAUKESHA, WI 53188 * PH: (262)524-3750 * FAX: (262)524-3751

PERMIT NUMBER

PERMANENT SIGN PERMIT APPLICATION

ONE APPLICATION PER SIGN

SITE ADDRESS : 1901 E. Moreland Rd.

Total Number of signs applying for today: 4 Value of Sign(s) \$

FEE: \$40 min. or \$1 per sq. ft. Required in full at time of submittal. **FEE IS NON-REFUNDABLE.**

Location of THIS sign: Front of Building
Site plan NOI

Office Use Only	
<input type="checkbox"/>	PICTURE/Drawing/Site Plan
<input type="checkbox"/>	FEE
<input type="checkbox"/>	ELECTRICAL PERMIT
Paid: _____ Initials: _____	

Permit copy will be mailed to this address

Business Name: Fields Volvo Jaguar

Sign Contractor: Midwest Sign & Lighting, Inc.

Owner Name:

Address: PO Box 100045

Business Phone: 262-522-8025

City/State/Zip: Milwaukee, WI 53210

For questions call: ☐ Business ☒ Sign Contractor

Phone: 414-447-8227

IF THIS IS AREA IS LEFT EMPTY, PERMIT WILL NOT BE MAILED.

(MANDATORY FIELD; application will be returned if left blank.)

You must submit an electrical permit signed by a licensed electrician with all illuminated sign permit applications.

HAS THIS BEEN DONE? ☐ YES, Permit No. BL - - ☐ NO ☐ NOT APPLICABLE

ATTACH A COLOR PHOTO, DRAWING, AND/OR SITE PLAN. Show dimensions to scale, colors, and location of sign.

CHECK ONE:

☒ New Sign ☐ Existing Sign ☐ Face Change Only

TYPE OF SIGN (Circle all that apply):

☒ Wall ☐ Door ☐ Projecting ☐ Window ☐ Roof ☐ Billboard
☐ Flat ☐ Awning ☐ Freestanding ☐ Yard ☐ Double Face

Horizontal Width of Sign 4'9" Vertical dimension of Sign 1'0" TOTAL Square Footage: 4.75 sq. ft.

If Sign is detached or projecting, please supply: Total Height _____ Clearance: _____ Setback: _____

Premise Data: Street Frontage: _____ Building or Tenant Space Width: _____ Other Street Frontage: _____

PLEASE LIST ALL EXISTING SIGNAGE ON THE BACK OF THIS SHEET.

By my signature, I state and agree, that I have carefully examined the completed application and do hereby certify that all information herein is true and correct, and I further certify that any and all work performed shall be done in accordance with the Ordinances of the City of Waukesha, and the Laws of the State of Wisconsin pertaining to the work described herein

Legal Signature  Print Name Richard Kos Date 1/5/18

OFFICE USE ONLY

Zoning District: _____ Gross sign area for premises: _____ Area used by other signs: _____

☐ Approved Conditions (if any):

☐ Must submit electrical permit within 30 days of meeting or permit shall be voided.

☐ Denied Does not conform to:

<input type="checkbox"/> Height	<input type="checkbox"/> Architecturally compatible	<input type="checkbox"/> Not to face R-district	<input type="checkbox"/> Clearance	<input type="checkbox"/> Area	<input type="checkbox"/> Corner Vision
<input type="checkbox"/> Projection	<input type="checkbox"/> Avoid needless elaboration	<input type="checkbox"/> Consolidation of signs	<input type="checkbox"/> Distracting sign	<input type="checkbox"/> Setback	<input type="checkbox"/> Other

Authorized Signature _____ Date of Review _____

INCOMPLETE APPLICATIONS MAY NOT BE PROCESSED.

Review Board meets the 3rd Monday of the month at 8:15 am. DEADLINE IS THE MONDAY BEFORE THE MEETING.



Project Title

VOLVO

Date 09.22.15

AGI EOR M. ALAMELDIN

Lead Draftor FKN

Drawn By FKN

Project Mgr. J. ANTONÉ

General Sign Specifications

Interior

☒ Single Faced ☐ Double Faced

[illegible]

portatilità) e l'uso di

120 illuminated

1. **Introduction**

WEDNESDAY

MARCH 2007

1	2	3	466
---	---	---	---	---	---	---	---	---	----	----	-----	-----	
100

FABRICATED ALUM. CHANNEL LETTERS
W/ SATIN ANODIZED ALUM. RETURNS

3/4" TRANSLUCENT WHITE #2447
ACRYLIC FACE PANELS

4' - 8 1/16"

“D-d

drivings

1 FRONT ELEVATION
1' = 1" = 0.37

SIDE VIEW
 $r = r' - \phi''$

७८

50

၈၇၁

SAB.

By

This document is the sole property of Architectural Graphics, Inc., and all designs, manufacturers, reproduction, use and sale relating the same are expressly forbidden. It is authorized under a license agreement with the U.S. Copyright Office by the publisher for marketing this document. The publisher and licensee agree that this document will not be loaned or retransmitted in whole or in part, nor the contents retransmitted in any manner or by any person except for the purposes for which it was loaned, nor any special feature included in this design be incorporated in other products.

Code	Type
------	------

6

[illegible]

100

NO 2

Waukesha

PERMIT NUMBER

CITY OF WAUKESHA, WISCONSIN

201 DELAFIELD STREET * ROOM 200 * WAUKESHA, WI 53188 * PH: (262)524-3750 * FAX: (262)524-3751

PERMANENT SIGN PERMIT APPLICATION

ONE APPLICATION PER SIGN

SITE ADDRESS : 1901 E. Moreland Rd.

Total Number of signs applying for today: _____ Value of Sign(s) \$ _____

FEE: \$40 min. or \$1 per sq. ft. Required in full at time of submittal. **FEE IS NON-REFUNDABLE.**Location of THIS sign: Site Plan NO 2

Office Use Only

☐ PICTURE/Drawing/Site Plan☐ FEE☐ ELECTRICAL PERMIT

Paid: _____ Initials: _____

Permit copy will be mailed to this address

Business Name: Fields Volvo JaguarSign Contractor: Midwest Sign & Lighting, Inc.

Owner Name: _____

Address: PO Box 100045Business Phone: 262-522-8025City/State/Zip: Milwaukee, WI 53210For questions call: ☐ Business ☒ Sign ContractorPhone: 414-447-8227

IF THIS IS AREA IS LEFT EMPTY, PERMIT WILL NOT BE MAILED.

(MANDATORY FIELD; application will be returned if left blank.)

You must submit an electrical permit signed by a licensed electrician with all illuminated sign permit applications.

HAS THIS BEEN DONE? ☐ YES, Permit No. BL - - ☐ NO ☐ NOT APPLICABLE**ATTACH A COLOR PHOTO, DRAWING, AND/OR SITE PLAN.** Show dimensions to scale, colors, and location of sign.

CHECK ONE:

☒ New Sign ☐ Existing Sign ☐ Face Change Only

TYPE OF SIGN (Circle all that apply):

☒ Wall ☐ Door ☐ Projecting ☐ Window ☐ Roof ☐ Billboard
☐ Flat ☐ Awning ☐ Freestanding ☐ Yard ☐ Double FaceHorizontal Width of Sign 10' 11" Vertical dimension of Sign 1' 8" TOTAL Square Footage: 18.2 sq. ft.

If Sign is detached or projecting, please supply: Total Height _____ Clearance: _____ Setback: _____

Premise Data: Street Frontage: _____ Building or Tenant Space Width: _____ Other Street Frontage: _____

PLEASE LIST ALL EXISTING SIGNAGE ON THE BACK OF THIS SHEET.

By my signature, I state and agree, that I have carefully examined the completed application and do hereby certify that all information herein is true and correct, and I further certify that any and all work performed shall be done in accordance with the Ordinances of the City of Waukesha, and the Laws of the State of Wisconsin pertaining to the work described herein

Legal Signature [Signature] Print Name Richard Kos Date 11/5/18

OFFICE USE ONLY

Zoning District: _____ Gross sign area for premises: _____ Area used by other signs: _____

☐ Approved Conditions (if any):☐ Must submit electrical permit within 30 days of meeting or permit shall be voided.☐ Denied Does not conform to:☐ Height ☐ Architecturally compatible ☐ Not to face R-district ☐ Clearance ☐ Area ☐ Corner Vision
☐ Projection ☐ Avoid needless elaboration ☐ Consolidation of signs ☐ Distracting sign ☐ Setback ☐ Other

Authorized Signature _____ Date of Review _____

INCOMPLETE APPLICATIONS MAY NOT BE PROCESSED.Review Board meets the 3rd Monday of the month at 8:15 am. DEADLINE IS THE MONDAY BEFORE THE MEETING.

N02

AGI Architectural Graphics Incorporated
2655 International Parkway
PO Box 9175
Virginia Beach, VA 23460
(757) 457-1800

Project Title
VOLVO

Date: 07.21.17

AGI Est: M. SMITH

Lead Draftsman: NUC

Drawn By: JTG

Project Mgr.: J. COLLINS

General Sign Specifications

☐ Interior ☒ Exterior
☒ Single Faced ☐ Double Faced
☐ Non-Illuminated
☒ Illuminated

Location: 100 CHESTER RD

Windload:

Notes: 100 Amps +/-

120

100

100


100

100
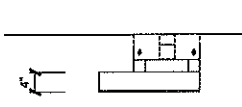

3 SIDE VIEW
1/2" = 1'-0"

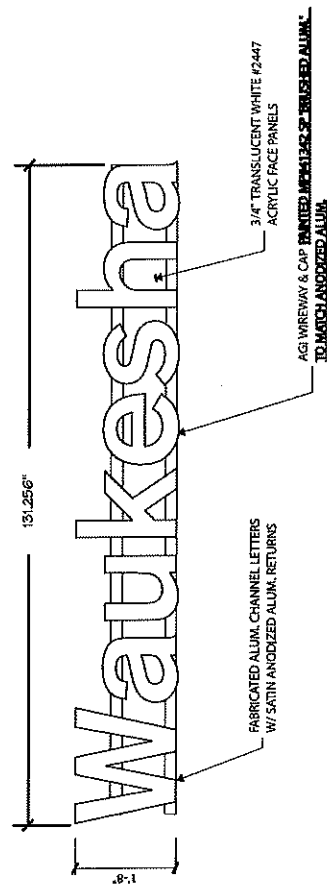

1 FRONT ELEVATION
1/2" = 1'-0"

Code	18874	Type	C
Sign Type	V-DN-20-RW	PG #:	1

NOG 0010

CITY OF WAUKESHA, WISCONSIN

201 DELAFIELD STREET * ROOM 200 * WAUKESHA, WI 53188 * PH: (262)524-3750 * FAX: (262)524-3751

PERMIT NUMBER

PERMANENT SIGN PERMIT APPLICATION

ONE APPLICATION PER SIGN

SITE ADDRESS : 1901 E. Moreland Rd.

Total Number of signs applying for today: _____ Value of Sign(s) \$ _____

FEE: \$40 min. or \$1 per sq. ft. Required in full at time of submittal. **FEE IS NON-REFUNDABLE.**

Location of THIS sign: Site Plan NOG

Office Use Only

☐ PICTURE/Drawing/Site Plan

☐ FEE

☐ ELECTRICAL PERMIT

Paid: _____ Initials: _____

Permit copy will be mailed to this address

Business Name: Fields Volvo Jaguar

Sign Contractor: Midwest Sign & Lighting, Inc.

Owner Name: _____

Address: PO Box 100045

Business Phone: 262-522-8025

City/State/Zip: Milwaukee, WI 53210

For questions call: ☐ Business ☒ Sign Contractor

Phone: 414-447-8227

IF THIS IS AREA IS LEFT EMPTY, PERMIT WILL NOT BE MAILED.

(MANDATORY FIELD; application will be returned if left blank.)

You must submit an electrical permit signed by a licensed electrician with all illuminated sign permit applications.
HAS THIS BEEN DONE? ☐ YES, Permit No. BL - - ☐ NO ☐ NOT APPLICABLE

ATTACH A COLOR PHOTO, DRAWING, AND/OR SITE PLAN. Show dimensions to scale, colors, and location of sign.

CHECK ONE:

☒ New Sign ☐ Existing Sign ☐ Face Change Only

TYPE OF SIGN (Circle all that apply):

Wall Door Projecting Window Roof Billboard
Flat Awning Freestanding Yard Double Face

Horizontal Width of Sign 12' 10" Vertical dimension of Sign 1' 8" TOTAL Square Footage: 21.3 sq. ft.

If Sign is detached or projecting, please supply: Total Height _____ Clearance: _____ Setback: _____

Premise Data: Street Frontage: _____ Building or Tenant Space Width: _____ Other Street Frontage: _____

PLEASE LIST ALL EXISTING SIGNAGE ON THE BACK OF THIS SHEET.

By my signature, I state and agree, that I have carefully examined the completed application and do hereby certify that all information herein is true and correct, and I further certify that any and all work performed shall be done in accordance with the Ordinances of the City of Waukesha, and the Laws of the State of Wisconsin pertaining to the work described herein

Legal Signature [Signature] Print Name Richard Kos Date 1/5/18

OFFICE USE ONLY

Zoning District: _____ Gross sign area for premises: _____ Area used by other signs: _____

☐ **Approved** Conditions (if any):

☐ Must submit electrical permit within 30 days of meeting or permit shall be voided.

☐ **Denied** Does not conform to:

☐ Height ☐ Architecturally compatible ☐ Not to face R-district ☐ Clearance ☐ Area ☐ Corner Vision
☐ Projection ☐ Avoid needless elaboration ☐ Consolidation of signs ☐ Distracting sign ☐ Setback ☐ Other


Authorized Signature _____ Date of Review _____

INCOMPLETE APPLICATIONS MAY NOT BE PROCESSED.


Review Board meets the 3rd Monday of the month at 8:15 am. DEADLINE IS THE MONDAY BEFORE THE MEETING.

N06, N08

QTY 3

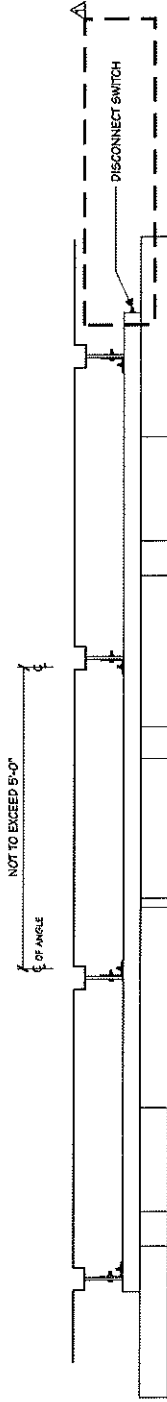

1 PLAN VIEW
3/4" = 1'-0"

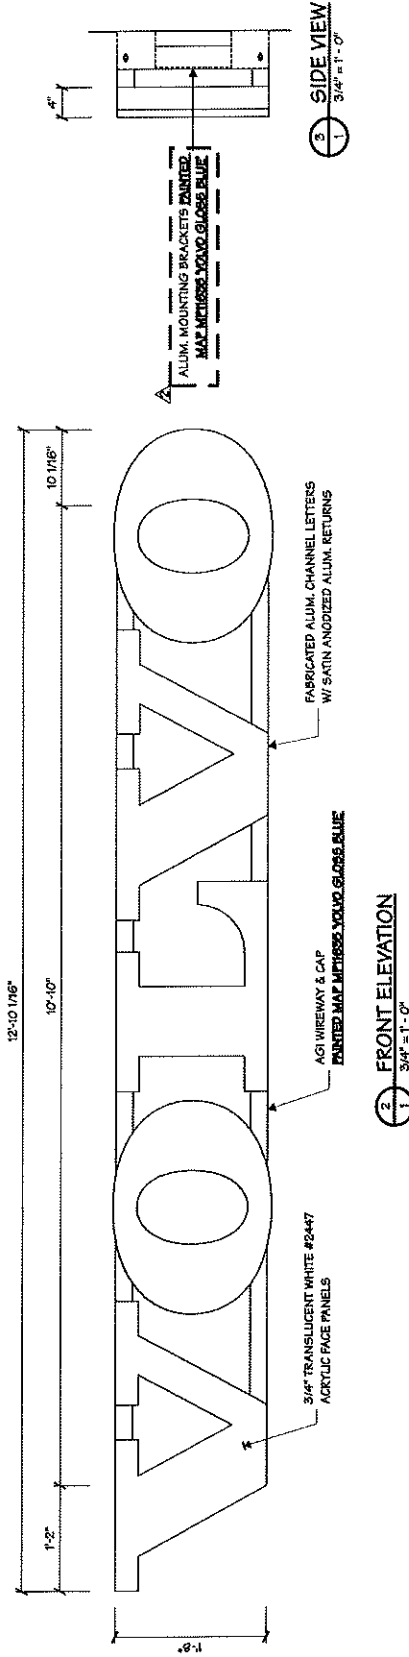

2 FRONT ELEVATION
3/4" = 1'-0"

AGI Architectural Graphics Incorporated
2855 International Parkway
P.O. Box 9175
Virginia Beach, VA 23460
(757) 427-1800

Project Title
VOLVO

Date 03.20.17
AGI Est. M. ALAMELDIN
Lead Draftsman FKN
Drawn By FKN
Project Mgr. J. ANTOINE

General Sign Specifications
☐ Interior ☒ Exterior
☐ Single Faced ☐ Double Faced
☐ Non-Illuminated
☒ Illuminated
120 Volts 0.8 Amps(+/-)

Location
Windload

Change	Drawn By	Date	Comments
01	FAS	03.20.17	GENERAL MARK UPS
02	FAS	03.14.17	SPECIFIED MOUNTING ANGLE COLORS

Change	Drawn By	Date	Comments
01	FAS	03.20.17	GENERAL MARK UPS
02	FAS	03.14.17	SPECIFIED MOUNTING ANGLE COLORS

This document is the sole property of Architectural Graphics Incorporated. It is to be used only for the project and site specified on the drawing. It is not to be reproduced, stored in a retrieval system, or transmitted, in any form or by any means, electronic, mechanical, photocopying, recording, or by any information storage and retrieval system, without the prior written permission of Architectural Graphics Incorporated. The user agrees to indemnify and hold Architectural Graphics Incorporated harmless from and against all claims, damages, and expenses, including reasonable attorneys' fees, arising out of or from the use of this document for any purpose other than that intended for the project and site specified on the drawing.

Code	Type	Sign Type	PO #
15161	C	CL-20-RW	1

NO8 Volvo

CITY OF WAUKESHA, WISCONSIN

201 DELAFIELD STREET * ROOM 200 * WAUKESHA, WI 53188 * PH: (262)524-3750 * FAX: (262)524-3751

PERMIT NUMBER

PERMANENT SIGN PERMIT APPLICATION

ONE APPLICATION PER SIGN

SITE ADDRESS : 1901 E. Moreland Rd.

Total Number of signs applying for today: _____ Value of Sign(s) \$ _____

FEE: \$40 min. or \$1 per sq. ft. Required in full at time of submittal. **FEE IS NON-REFUNDABLE.**

Location of THIS sign: Sib Plan NO8

Office Use Only

☐ PICTURE/Drawing/Site Plan

☐ FEE

☐ ELECTRICAL PERMIT

Paid: _____ Initials: _____

Permit copy will be mailed to this address

Business Name: Fields Volvo Jaguar

Sign Contractor: Midwest Sign & Lighting, Inc.

Owner Name: _____

Address: PO Box 100045

Business Phone: 262-522-8025

City/State/Zip: Milwaukee, WI 53210

For questions call: ☐ Business ☒ Sign Contractor

Phone: 414-447-8227

IF THIS IS AREA IS LEFT EMPTY, PERMIT WILL NOT BE MAILED.

(MANDATORY FIELD; application will be returned if left blank.)

You must submit an electrical permit signed by a licensed electrician with all illuminated sign permit applications.

HAS THIS BEEN DONE? ☐ YES, Permit No. BL - - - ☐ NO ☐ NOT APPLICABLE

ATTACH A COLOR PHOTO, DRAWING, AND/OR SITE PLAN. Show dimensions to scale, colors, and location of sign.

CHECK ONE:

☒ New Sign ☐ Existing Sign ☐ Face Change Only

TYPE OF SIGN (Circle all that apply):

Wall Door Projecting Window Roof Billboard
Flat Awning Freestanding Yard Double Face

Horizontal Width of Sign 12'10" Vertical dimension of Sign 1'5" TOTAL Square Footage: 21.3 sq. ft.

If Sign is detached or projecting, please supply: Total Height _____ Clearance: _____ Setback: _____

Premise Data: Street Frontage: _____ Building or Tenant Space Width: _____ Other Street Frontage: _____

PLEASE LIST ALL EXISTING SIGNAGE ON THE BACK OF THIS SHEET.

By my signature, I state and agree, that I have carefully examined the completed application and do hereby certify that all information herein is true and correct, and I further certify that any and all work performed shall be done in accordance with the Ordinances of the City of Waukesha, and the Laws of the State of Wisconsin pertaining to the work described herein

Legal Signature [Signature] Print Name Richard Kos Date 11/5/18

OFFICE USE ONLY

Zoning District: _____ Gross sign area for premises: _____ Area used by other signs: _____

☐ Approved Conditions (if any):

☐ Must submit electrical permit within 30 days of meeting or permit shall be voided.

☐ Denied Does not conform to:

☐ Height ☐ Architecturally compatible ☐ Not to face R-district ☐ Clearance ☐ Area ☐ Corner Vision
☐ Projection ☐ Avoid needless elaboration ☐ Consolidation of signs ☐ Distracting sign ☐ Setback ☐ Other


Authorized Signature _____ Date of Review _____

INCOMPLETE APPLICATIONS MAY NOT BE PROCESSED.


Review Board meets the 3rd Monday of the month at 8:15 am. DEADLINE IS THE MONDAY BEFORE THE MEETING.

N06, N08

QTY 3

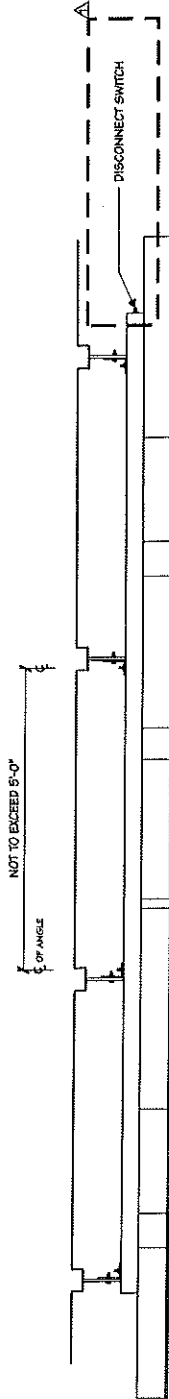

1 PLAN VIEW
3/4" = 1'-0"

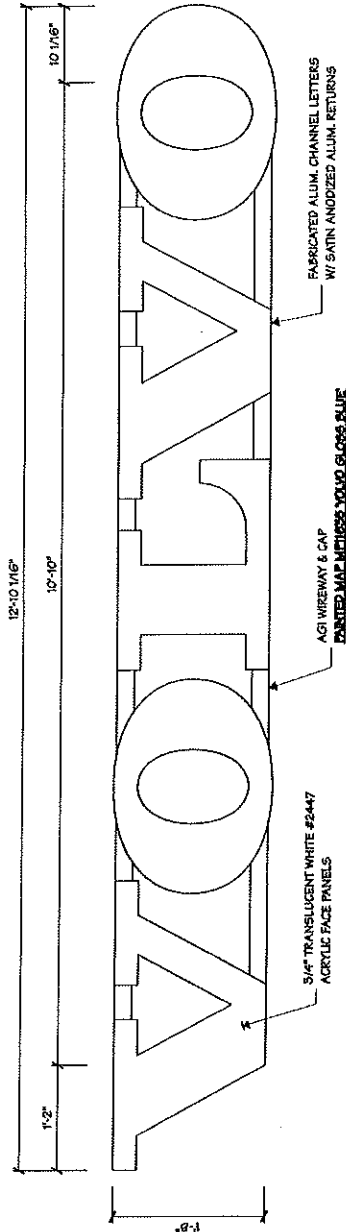

2 FRONT ELEVATION
3/4" = 1'-0"

ALUM. MOUNTING BRACKETS PAINTED
MAX MICHIGAN VIOLET GLOSS BLUE

FABRICATED ALUM. CHANNEL LETTERS
W/ SATIN ANODIZED ALUM. RETURNS

AGI WIREWAY & CAP
PAINTED MAX MICHIGAN VIOLET GLOSS BLUE

3/4" TRANSLUCENT WHITE #2447
ACRYLIC FACE PANELS

3 SIDE VIEW
3/4" = 1'-0"

AGI Architectural
Graphics
Incorporated
2555 International Parkway
PO Box 9175
Virginia Beach, VA 23460
(757) 427-1900

Project Title

VOLVO

Date 03.20.17

Adi Esh M. ALAMELIDIN

Lead Designer FKN

Drawn By FKN

Project Mgr. J. ANTONIO

General Sign Specifications

☐ Interior ☒ Exterior

☐ Single Faced ☐ Double Faced

☐ Non-Illuminated

☒ Illuminated

Location _____

120 _____

Volts _____

0.5 _____

Amperage _____

Windload _____

Whiteboard _____

Change _____

Drawn By _____

Date _____

Check _____

Approved _____

Specified Mounting Angle Colors _____

Change _____

Drawn By _____

Date _____

Check _____

Approved _____

Specified Mounting Angle Colors _____

Change _____

Drawn By _____

Date _____

Check _____

Approved _____

VOLVO



WAUKESHA VOLVO



Retailer Exterior Signage

Site ID:

Site Name:
Waukesha Volvo

Site Address:
2700 N.E. 55th Street
Seattle, WA 98105

Date of Creation: 10/31/17

REV 1:

REV 2:

REV 3:

REV 4:

REV 5:

Page: 2

Drawing Desc: Site Plan

Scale: NTS

Drawings are the exclusive property of Architectural Graphics Incorporated. Any unauthorized use or duplication is not permitted.

AGI
YOUR IMAGE. OUR PRIORITY.

3655 Greenwood Pl., Victoria B.C., V8L 4G2
PHONE: (250) 427-1100 FAX: (250) 427-1107
www.AGI-BC.com

