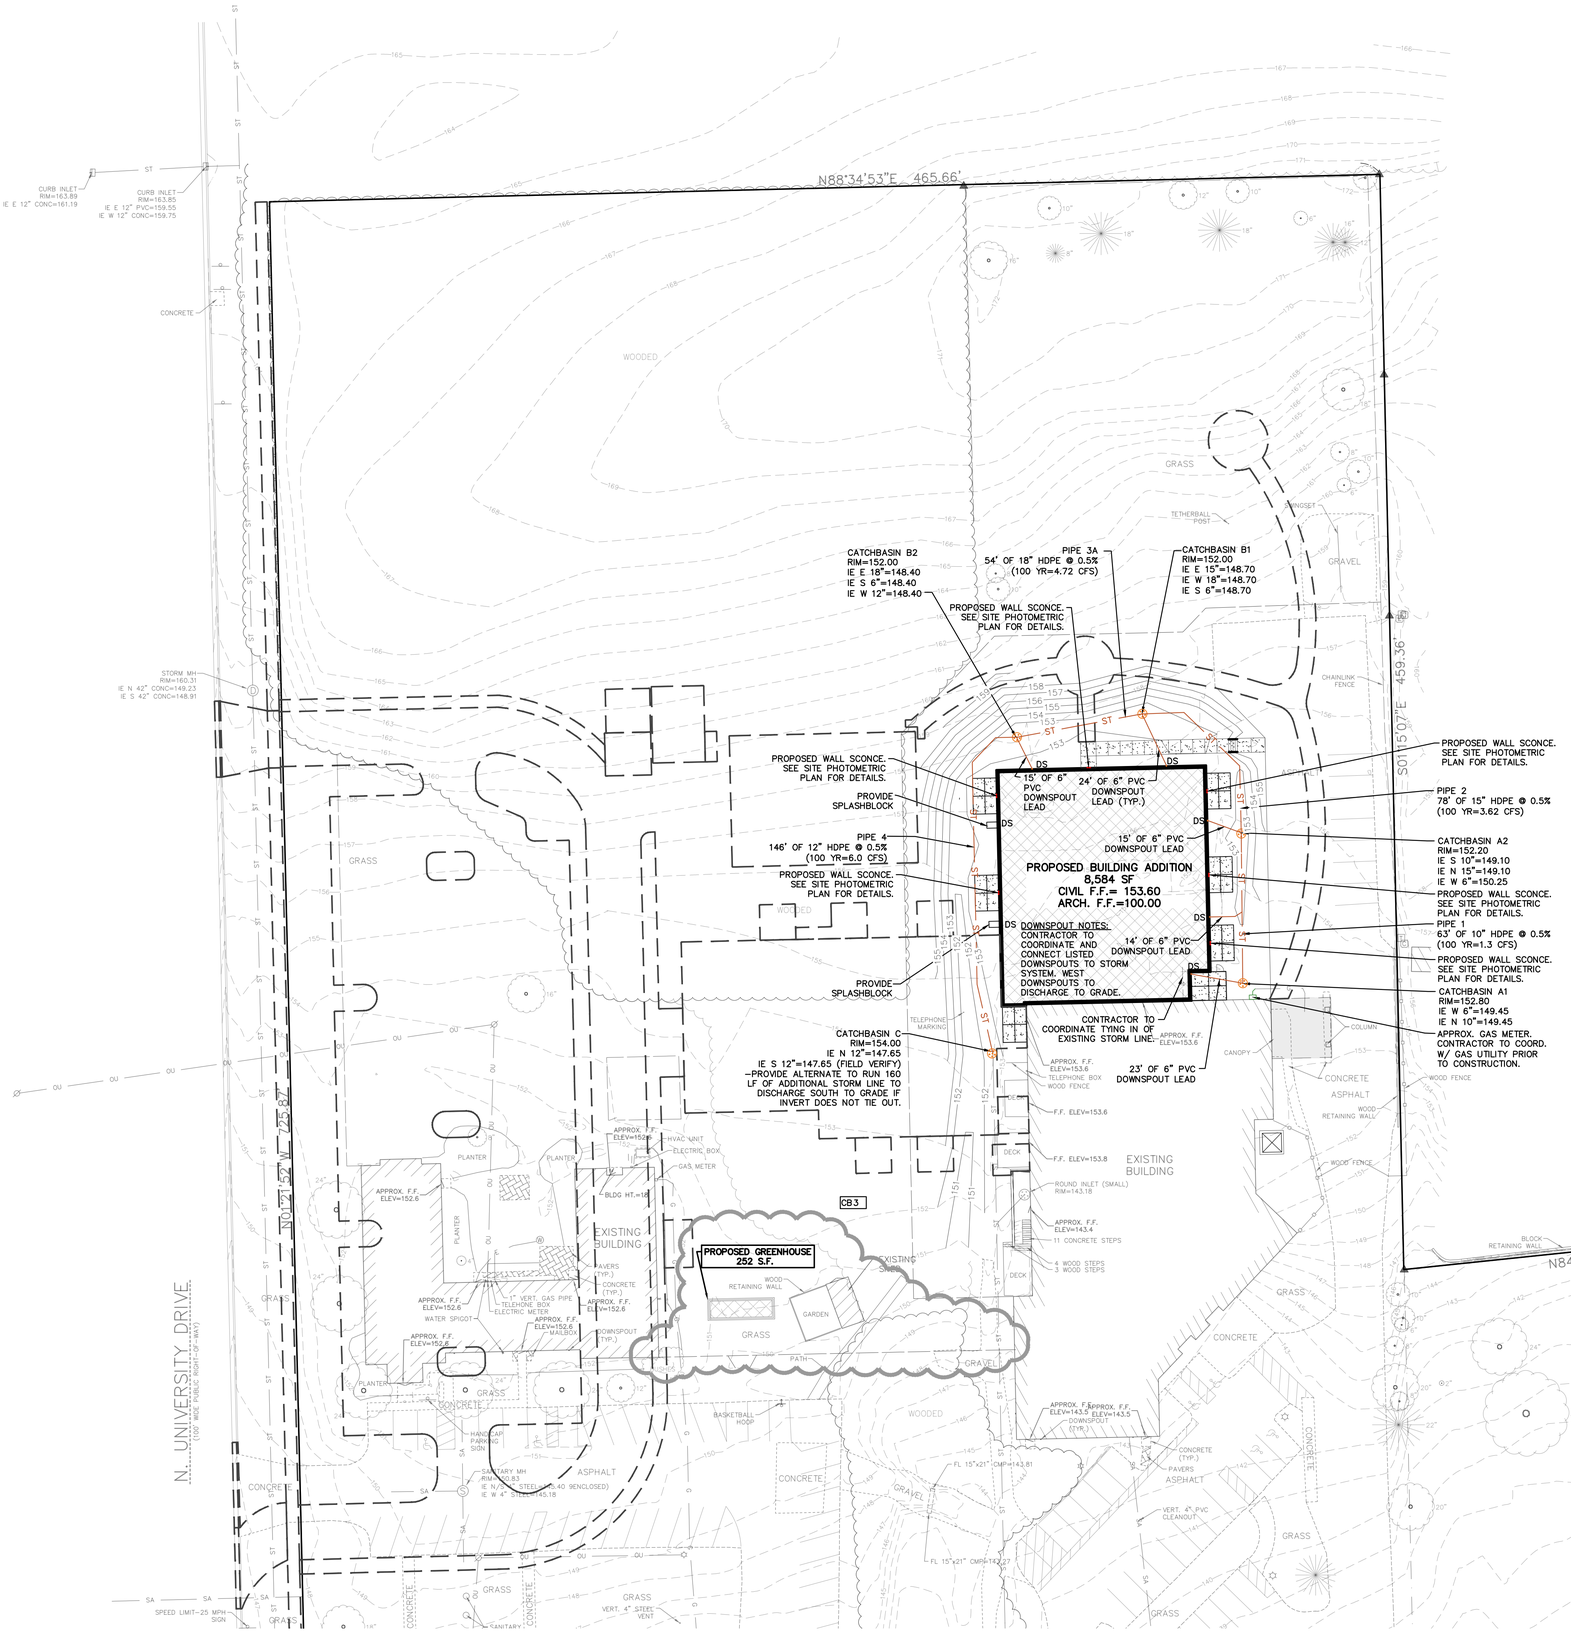

CIVIL UTILITY PLAN

SPECIFICATION NOTE:
SEE SHEET C0.1 FOR PLAN SPECIFICATIONS AND REQUIREMENTS

DOWNSPOUT NOTE:

DS = DENOTES DOWNSPOUT TO GRADE OR DOWNSPOUTS CONNECTING TO STORM LINE LOCATIONS. PROVIDE SPLASH BLOCKS AT ALL DS TO GRADE LOCATIONS. SEE ARCH PLANS FOR FINAL LOCATIONS.

GENERAL UTILITY NOTES

1. CONTRACTOR SHALL PROVIDE FIELD NOTES FROM INSTALLATION OF SANITARY AND STORM LINES TO ENGINEER UP COMPLETION. INSTALLATION DATE SHALL BE PROVIDED BY CONTRACTOR. A SIGNED & SEALED RECORD DRAWING OF STORM AND SANITARY LINES SHALL BE COMPLETED BY A PROFESSIONAL ENGINEER OR REGISTERED LAND SURVEYOR UPON COMPLETION OF CONSTRUCTION AND SHALL INCLUDE THE FOLLOWING:RIM/COVER ELEVATION, INVERT ELEVATION, DISTANCES, SLOPES, MATERIALS, INSTALLATION DATES, AND NOTES RELATED TO MAJOR FIELD CHANGES.

EXCEL
ARCHITECTS • ENGINEERS • SURVEYORS
Always a **Better Plan**
100 Camelot Drive
Fond Du Lac, WI 54935
Phone: (920) 926-9800
www.EXCELENGINEER.com

PROJECT INFORMATION

PROPOSED MASTER PLAN FOR:
MONTESSORI SCHOOL OF WAUKESHA
2600 SUMMIT AVE. • WAUKESHA, WI 53188

PROFESSIONAL SEAL

SHEET DATES
SHEET ISSUE MAR. 25, 2021
REVISIONS
CB3 JUN. 25, 2021

JOB NUMBER
2053880

SHEET NUMBER
C1.3

2021 © EXCEL ENGINEERING, INC.